



CITY OF ROCKWALL
BRASS MONUMENT:
N 7019787.6941
E 2611033.9137
ELEV 583.24

HIGH POINT ELEV = 588.84
HIGH POINT STA = 7+31.50
PVI STA = 7+32.97
PVI ELEV = 589.00
A.D. = -1.83
K = 38.17

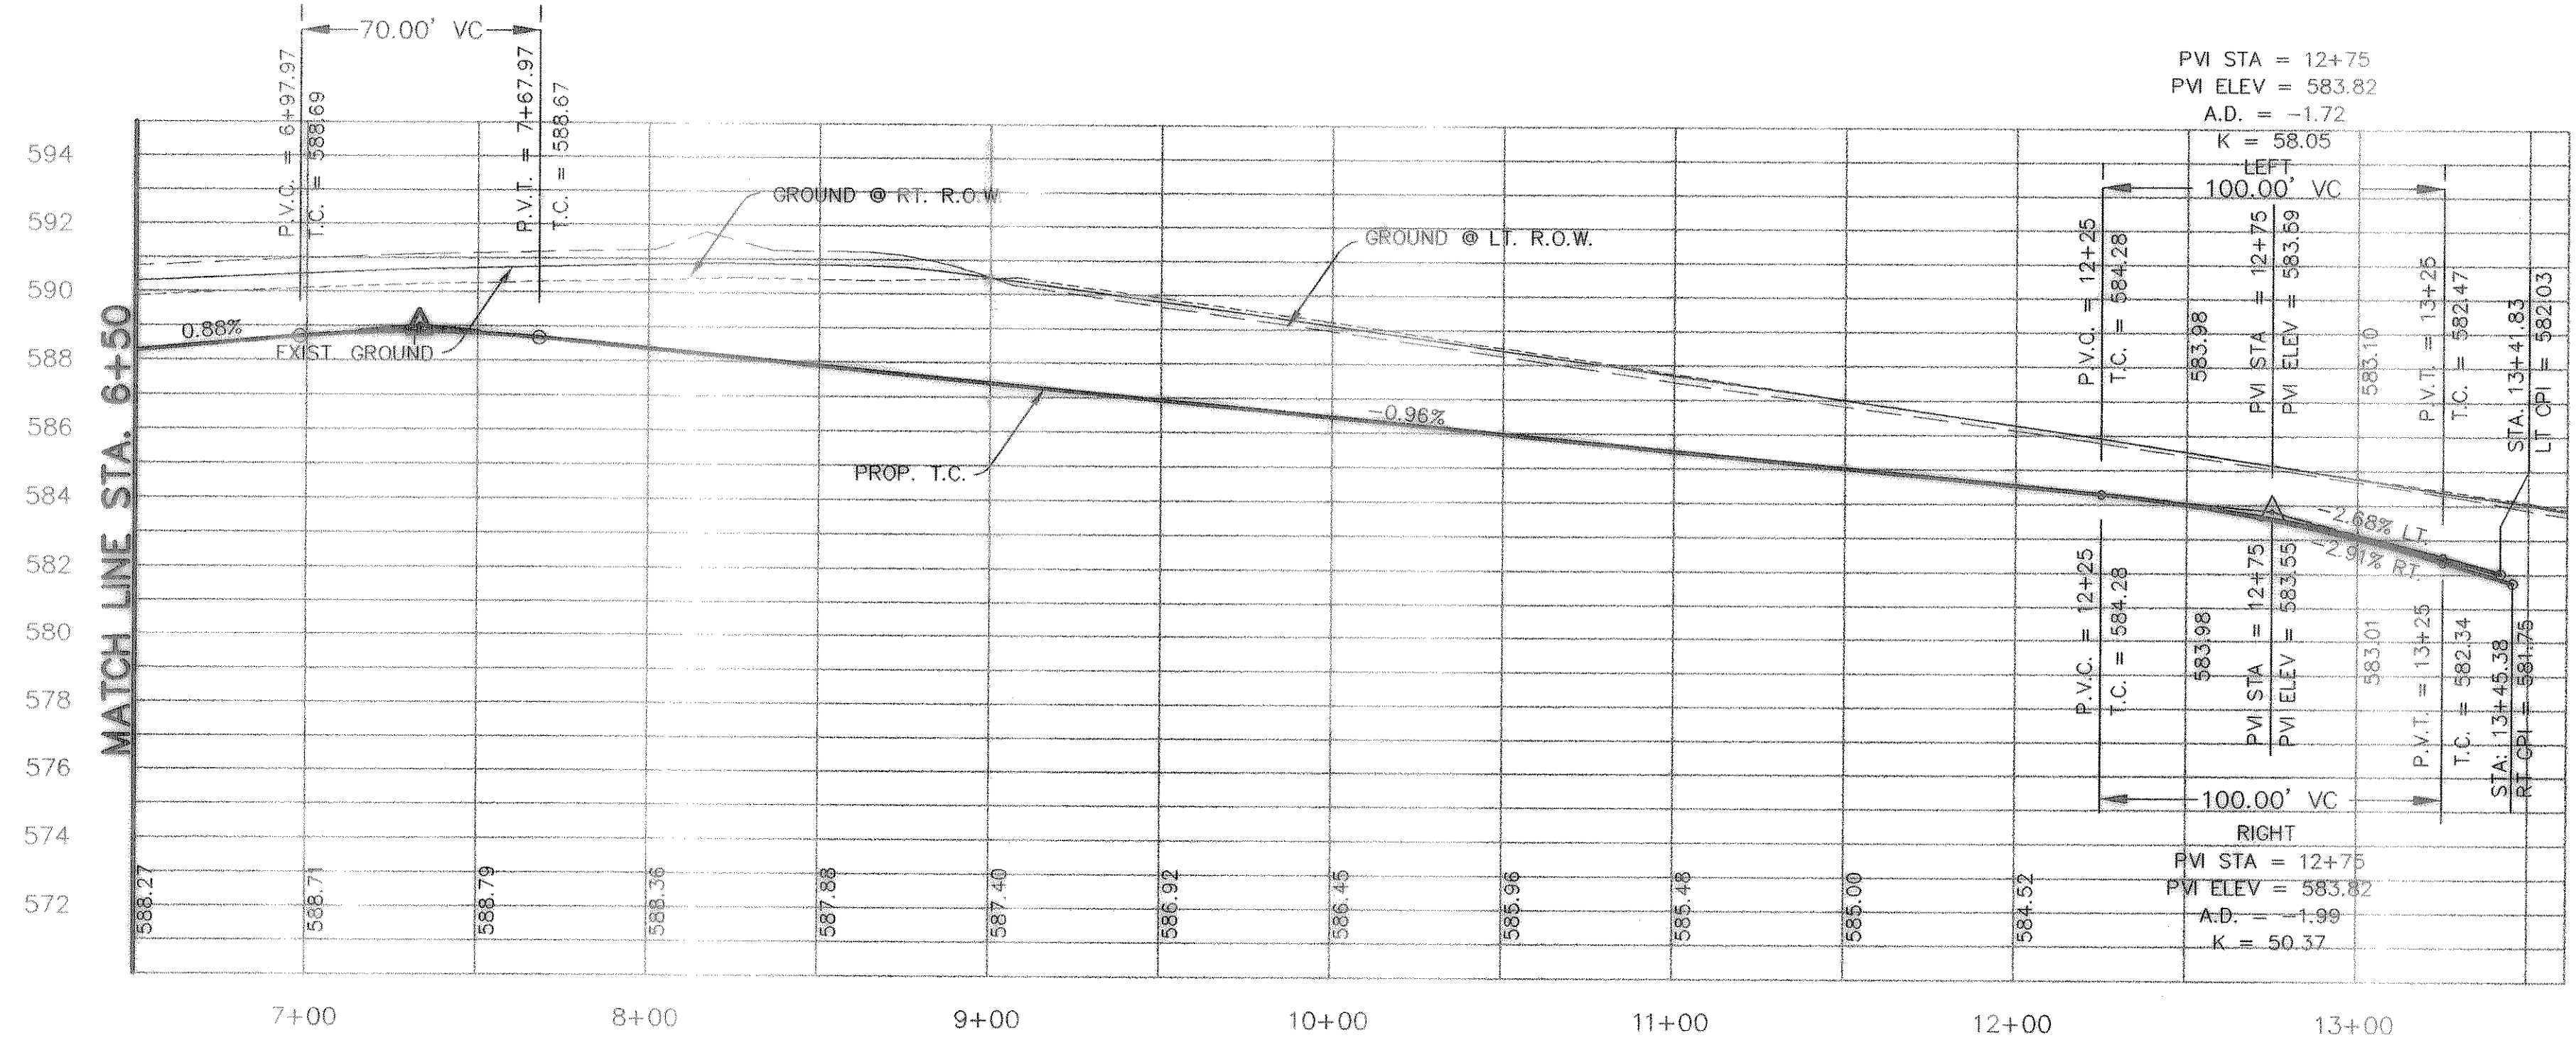

REVISED TO CONFORM TO CONSTRUCTION RECORDS.
W.L.D.
DATE: 12/18/02

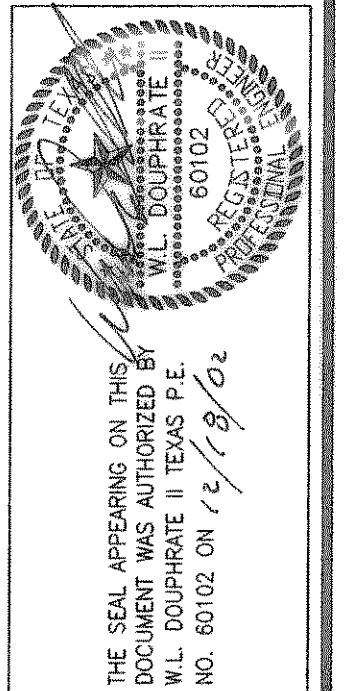

DOUPHRA
& ASSOCIATES, INC.
ENGINEERING • PROJECT MANAGEMENT • SURVEYING
2235 RIDGE RD., # 200 ROCKWALL, TEXAS 75087
PHONE: (972)771-9004 FAX: (972)771-9005

PAVING PLAN & PROFILE
EVERGREEN & HAWTHORNE DR. - STA: 6+50 TO 13+61.33
TIMBER CREEK ADDITION
CITY OF ROCKWALL, COUNTY OF ROCKWALL

REVISION	
W.L.D.	
CHECKED	
K.E.B.	
DRAWN	
7/25/00	
DATE	
9913 PV2	
PROJECT	