

DOUPHRADE & ASSOCIATES, INC.  
 ENGINEERING - PROJECT MANAGEMENT - SURVEYING  
 2235 RIDGE RD., # 200 ROCKWALL, TEXAS 75087  
 PHONE: (972)771-9004 FAX: (972)771-9005

PLAN AND PROFILE  
 ROCHELLE ROAD  
 TIMBER CREEK ADDITION  
 CITY OF ROCKWALL, COUNTY OF ROCKWALL

REV. 12-3-03  
 LEAVE-OUT AROUND  
 POWER POLE

REVISION


W.L.D.  
 CHECKED

K.E.B.  
 DRAWN

07/00  
 DATE

9913PV13  
 PROJECT

33  
 OF

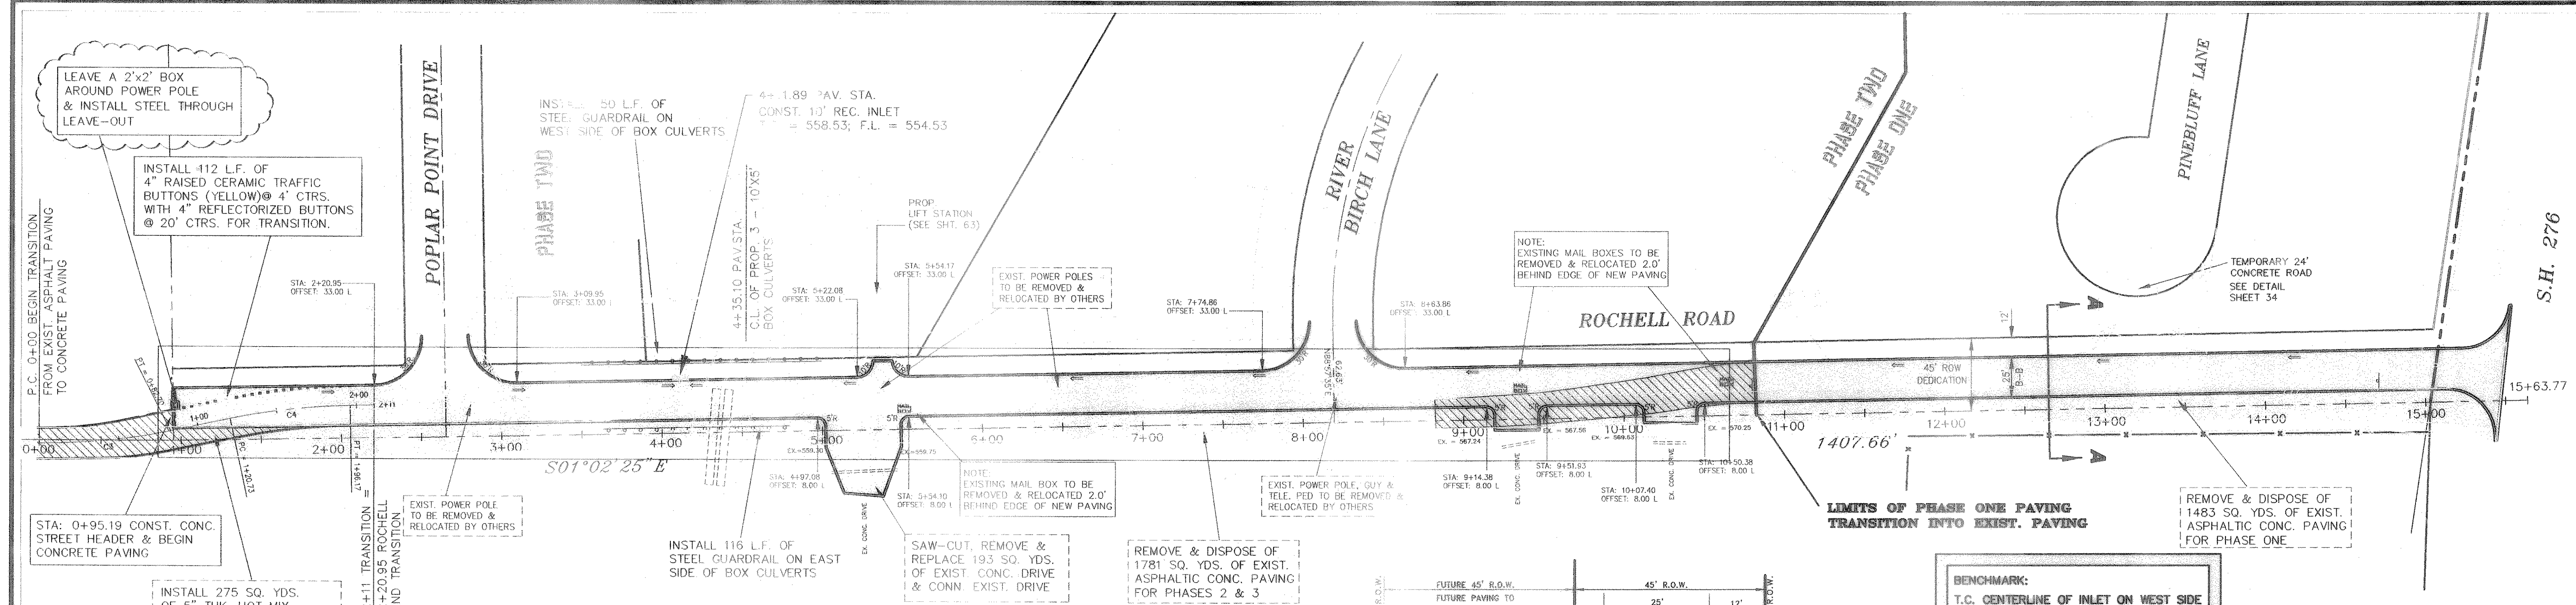

CURVE TABLE

CURVE	DELTA	RADIUS	TANGENT	LENGTH	CHORD
3	11°50'46"	400.00	41.50	82.70	82.55
4	10°48'21"	400.00	37.83	75.44	75.33

