


DOUPHRADE & ASSOCIATES, INC.
 ENGINEERING - PROJECT MANAGEMENT - SURVEYING
 2235 RIDGE RD., # 200 ROCKWALL, TEXAS 75087
 PHONE: (972) 771-9004 FAX: (972) 771-0005

PLAN AND PROFILE
 PINEBLUFF LANE
 TIMBER CREEK ADDITION
 CITY OF ROCKWALL, COUNTY OF ROCKWALL



STATE HIGHWAY NO. 276

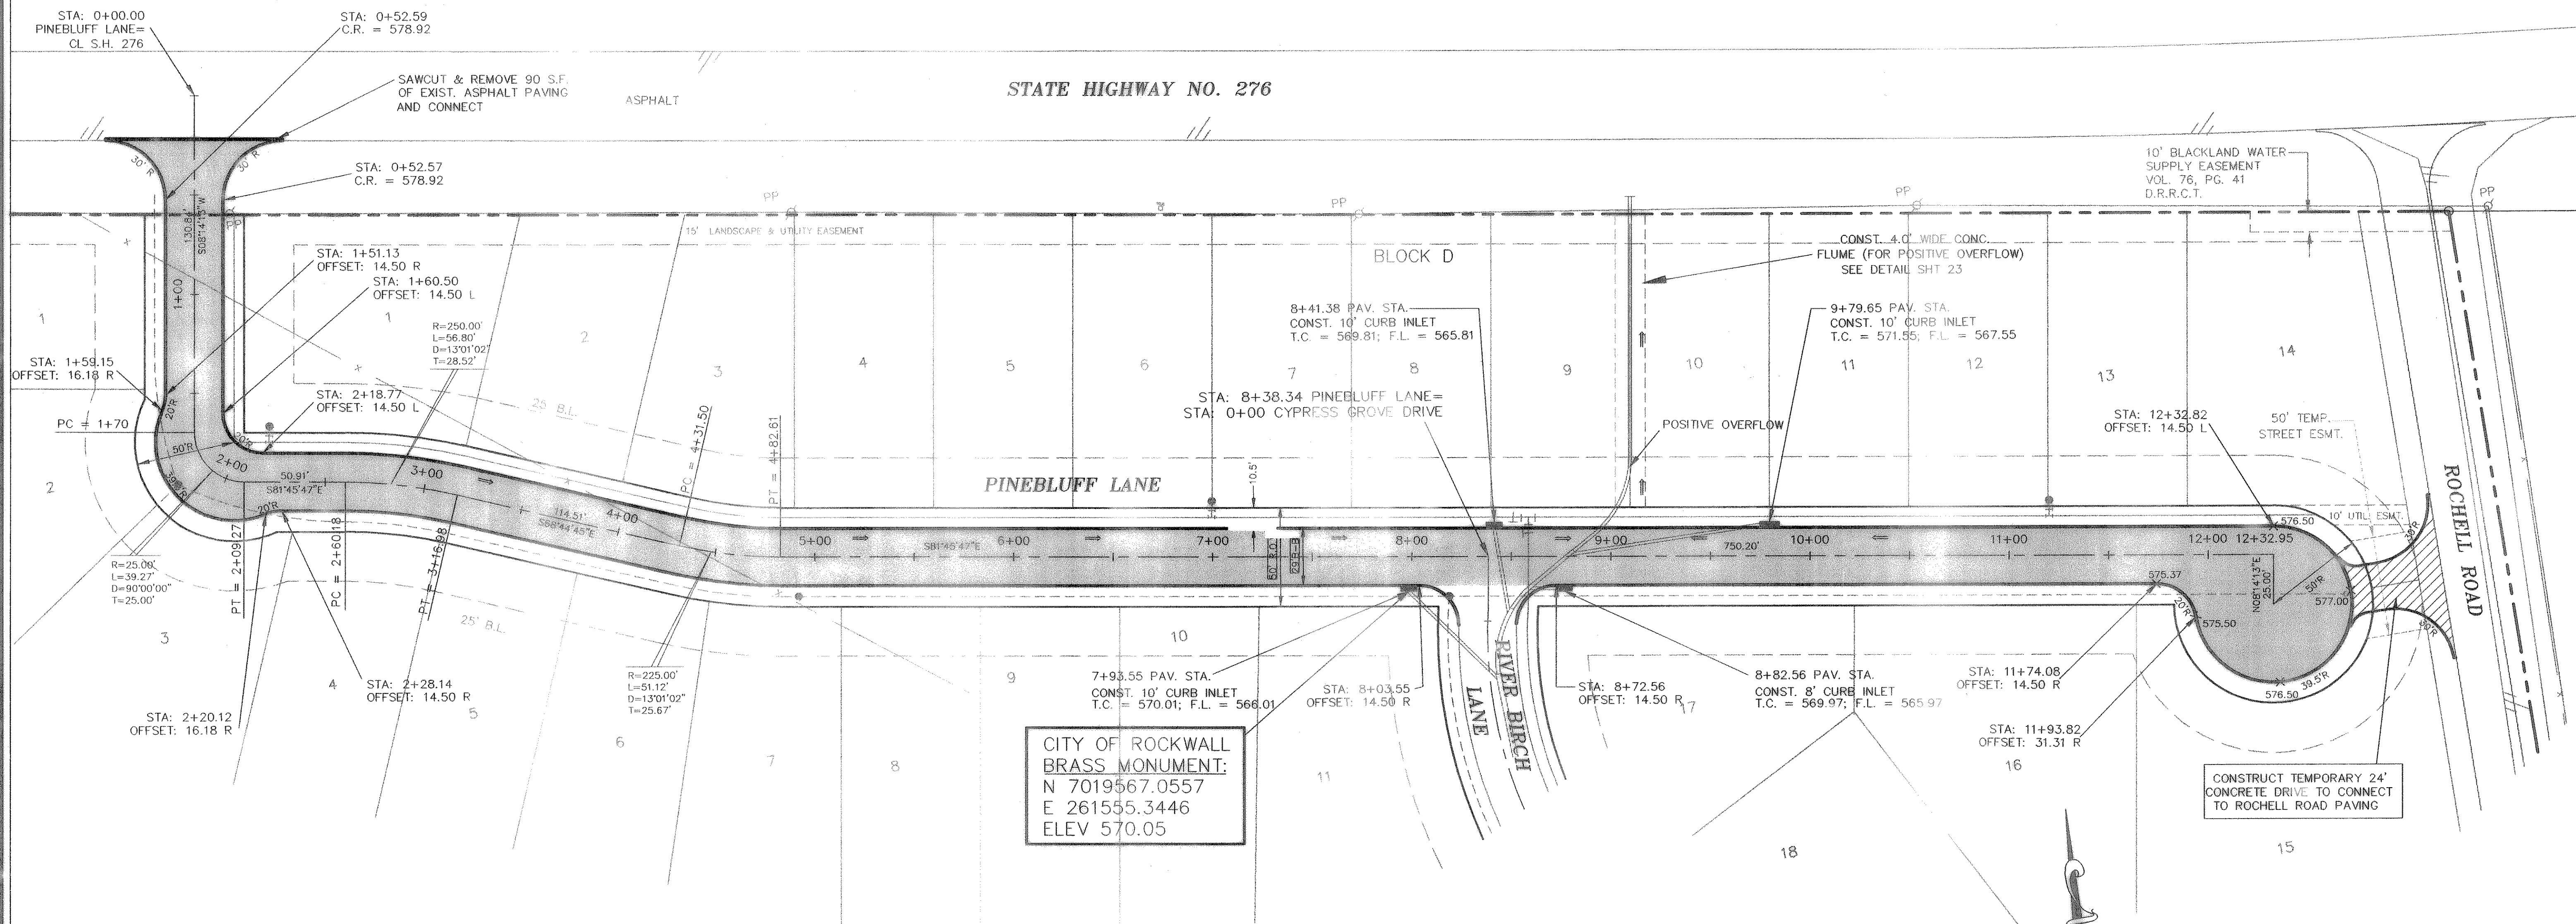

CITY OF ROCKWALL
 BRASS MONUMENT:
 N 7019567.0557
 E 261555.3446
 ELEV 570.05


REVISED TO CONFORM TO CONSTRUCTION RECORDS.
 DATE: 12/10/01

BENCHMARK:
 T.C. CENTERLINE OF INLET ON WEST SIDE
 OF SILVER VIEW LANE BETWEEN LOTS 4
 & 5, BLOCK B, OF STERLING FARMS
 ADDITION
 ELEV: 599.65

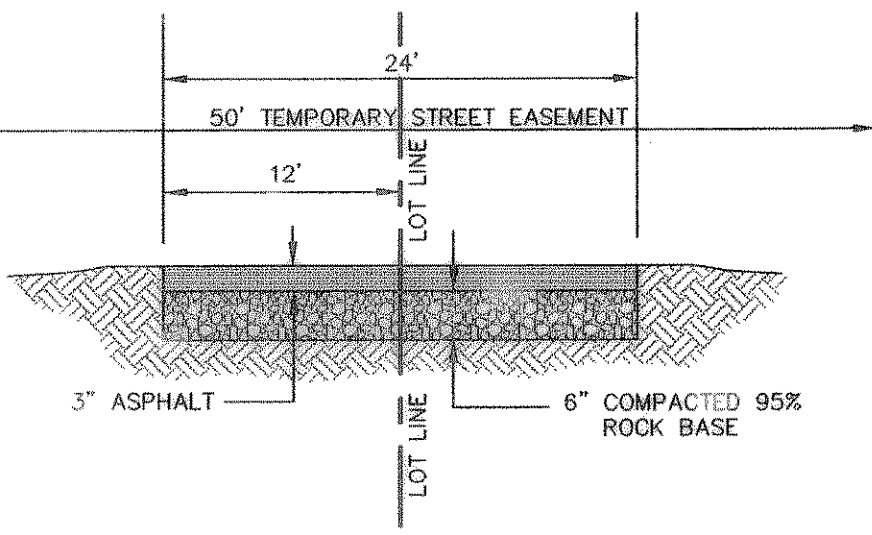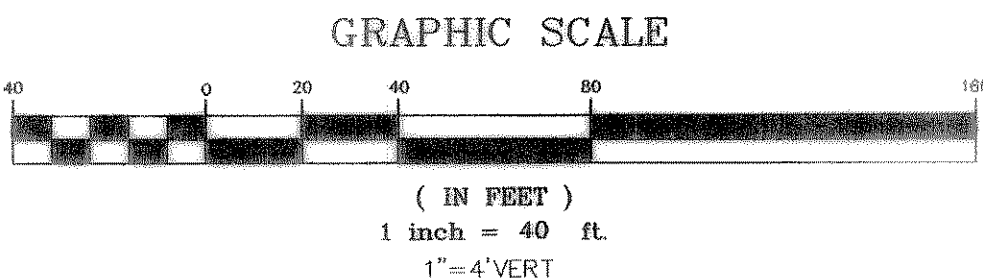

HIGH POINT ELEV = 578.98
 HIGH POINT STA = 0+34.38
 PVI STA = 0+75
 PVI ELEV = 579.22
 A.D. = -3.82
 K = 28.77

LOW POINT ELEV = 569.81
 LOW POINT STA = 8+41.38
 PVI STA = 8+75
 PVI ELEV = 569.50
 A.D. = 2.59
 K = 50.29

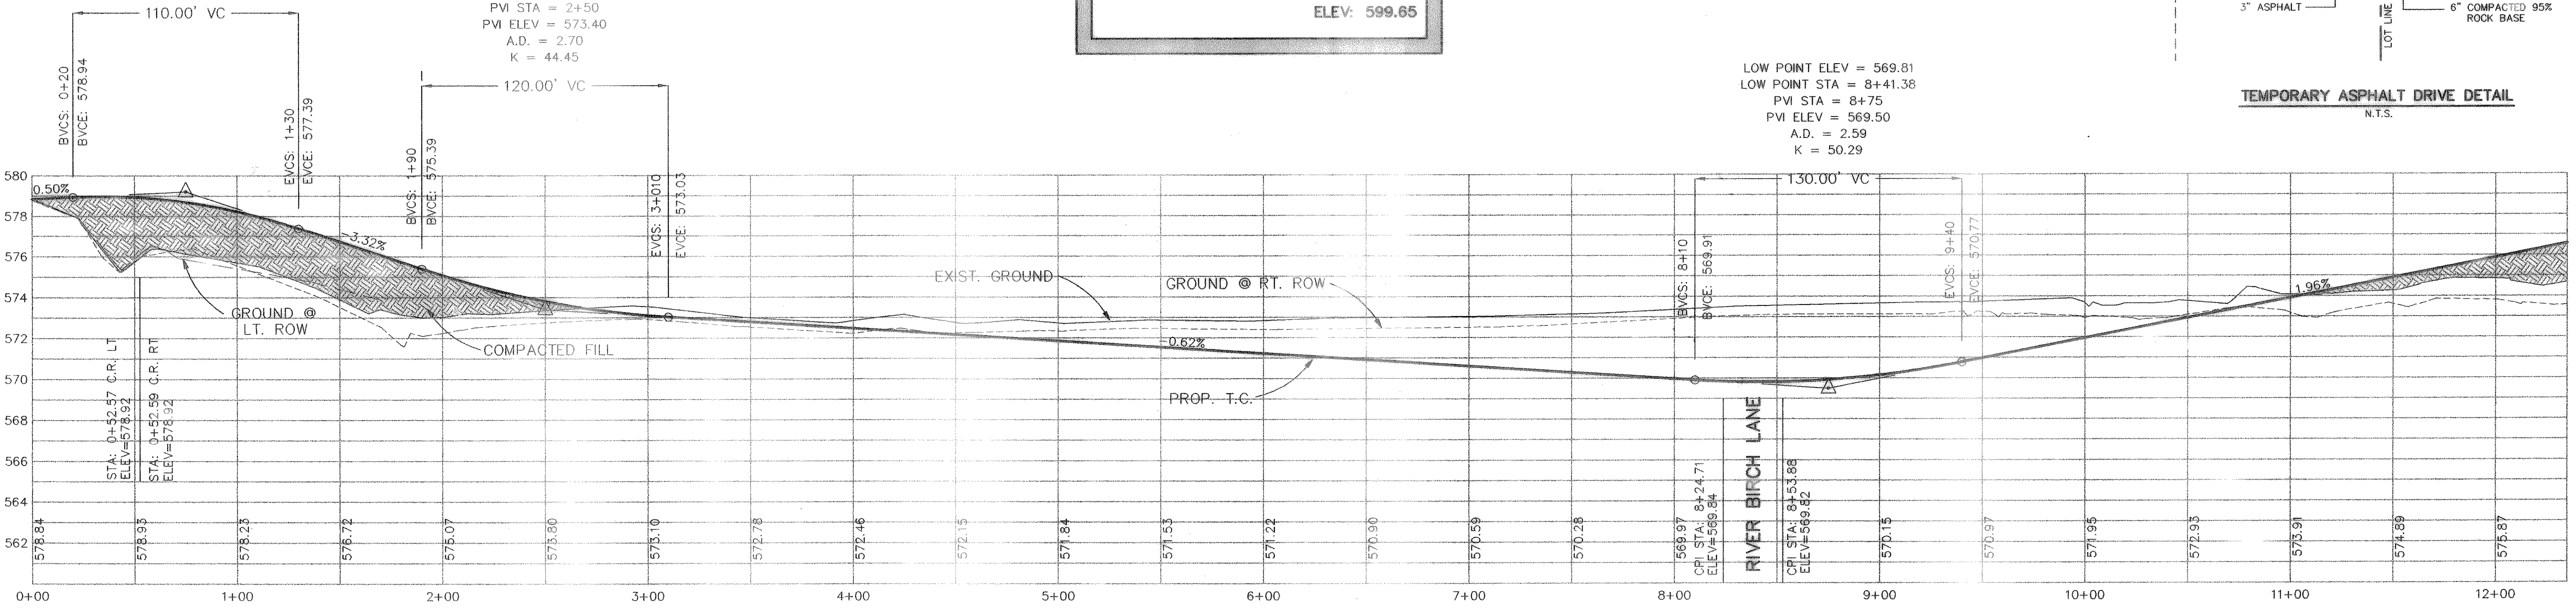

REVISION	W.L.D.
CHECKED	KEB.
DRAWN	1/28/98
DATE	9913PVI4
PROJECT	34 OF