

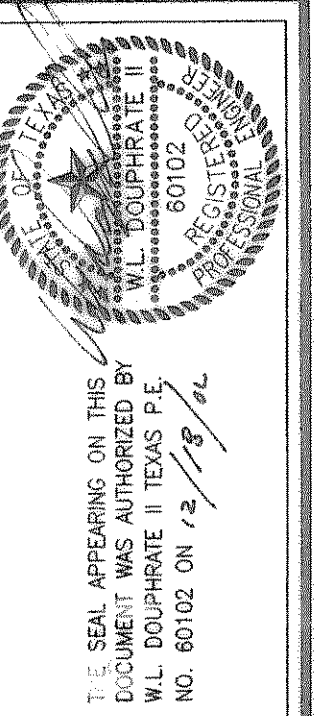


SEE SHEET "46 B" FOR PROFILE

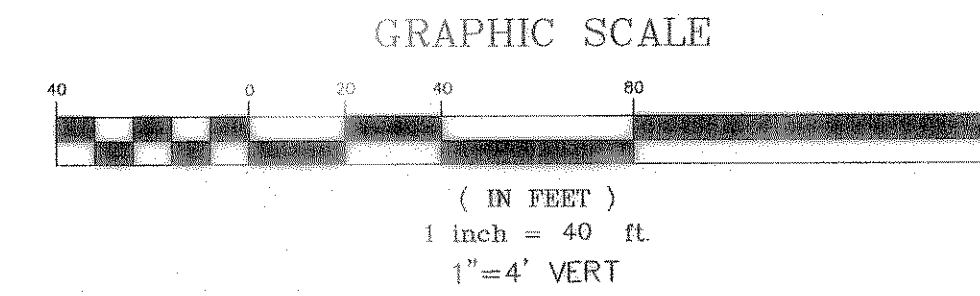

DOUPHRA  
& ASSOCIATES, INC.  
ENGINEERING - PROJECT MANAGEMENT - SURVEYING  
2235 RIDGE RD. # 200 ROCKWALL, TEXAS 75087  
PHONE: (972)771-9004 FAX: (972)771-9005

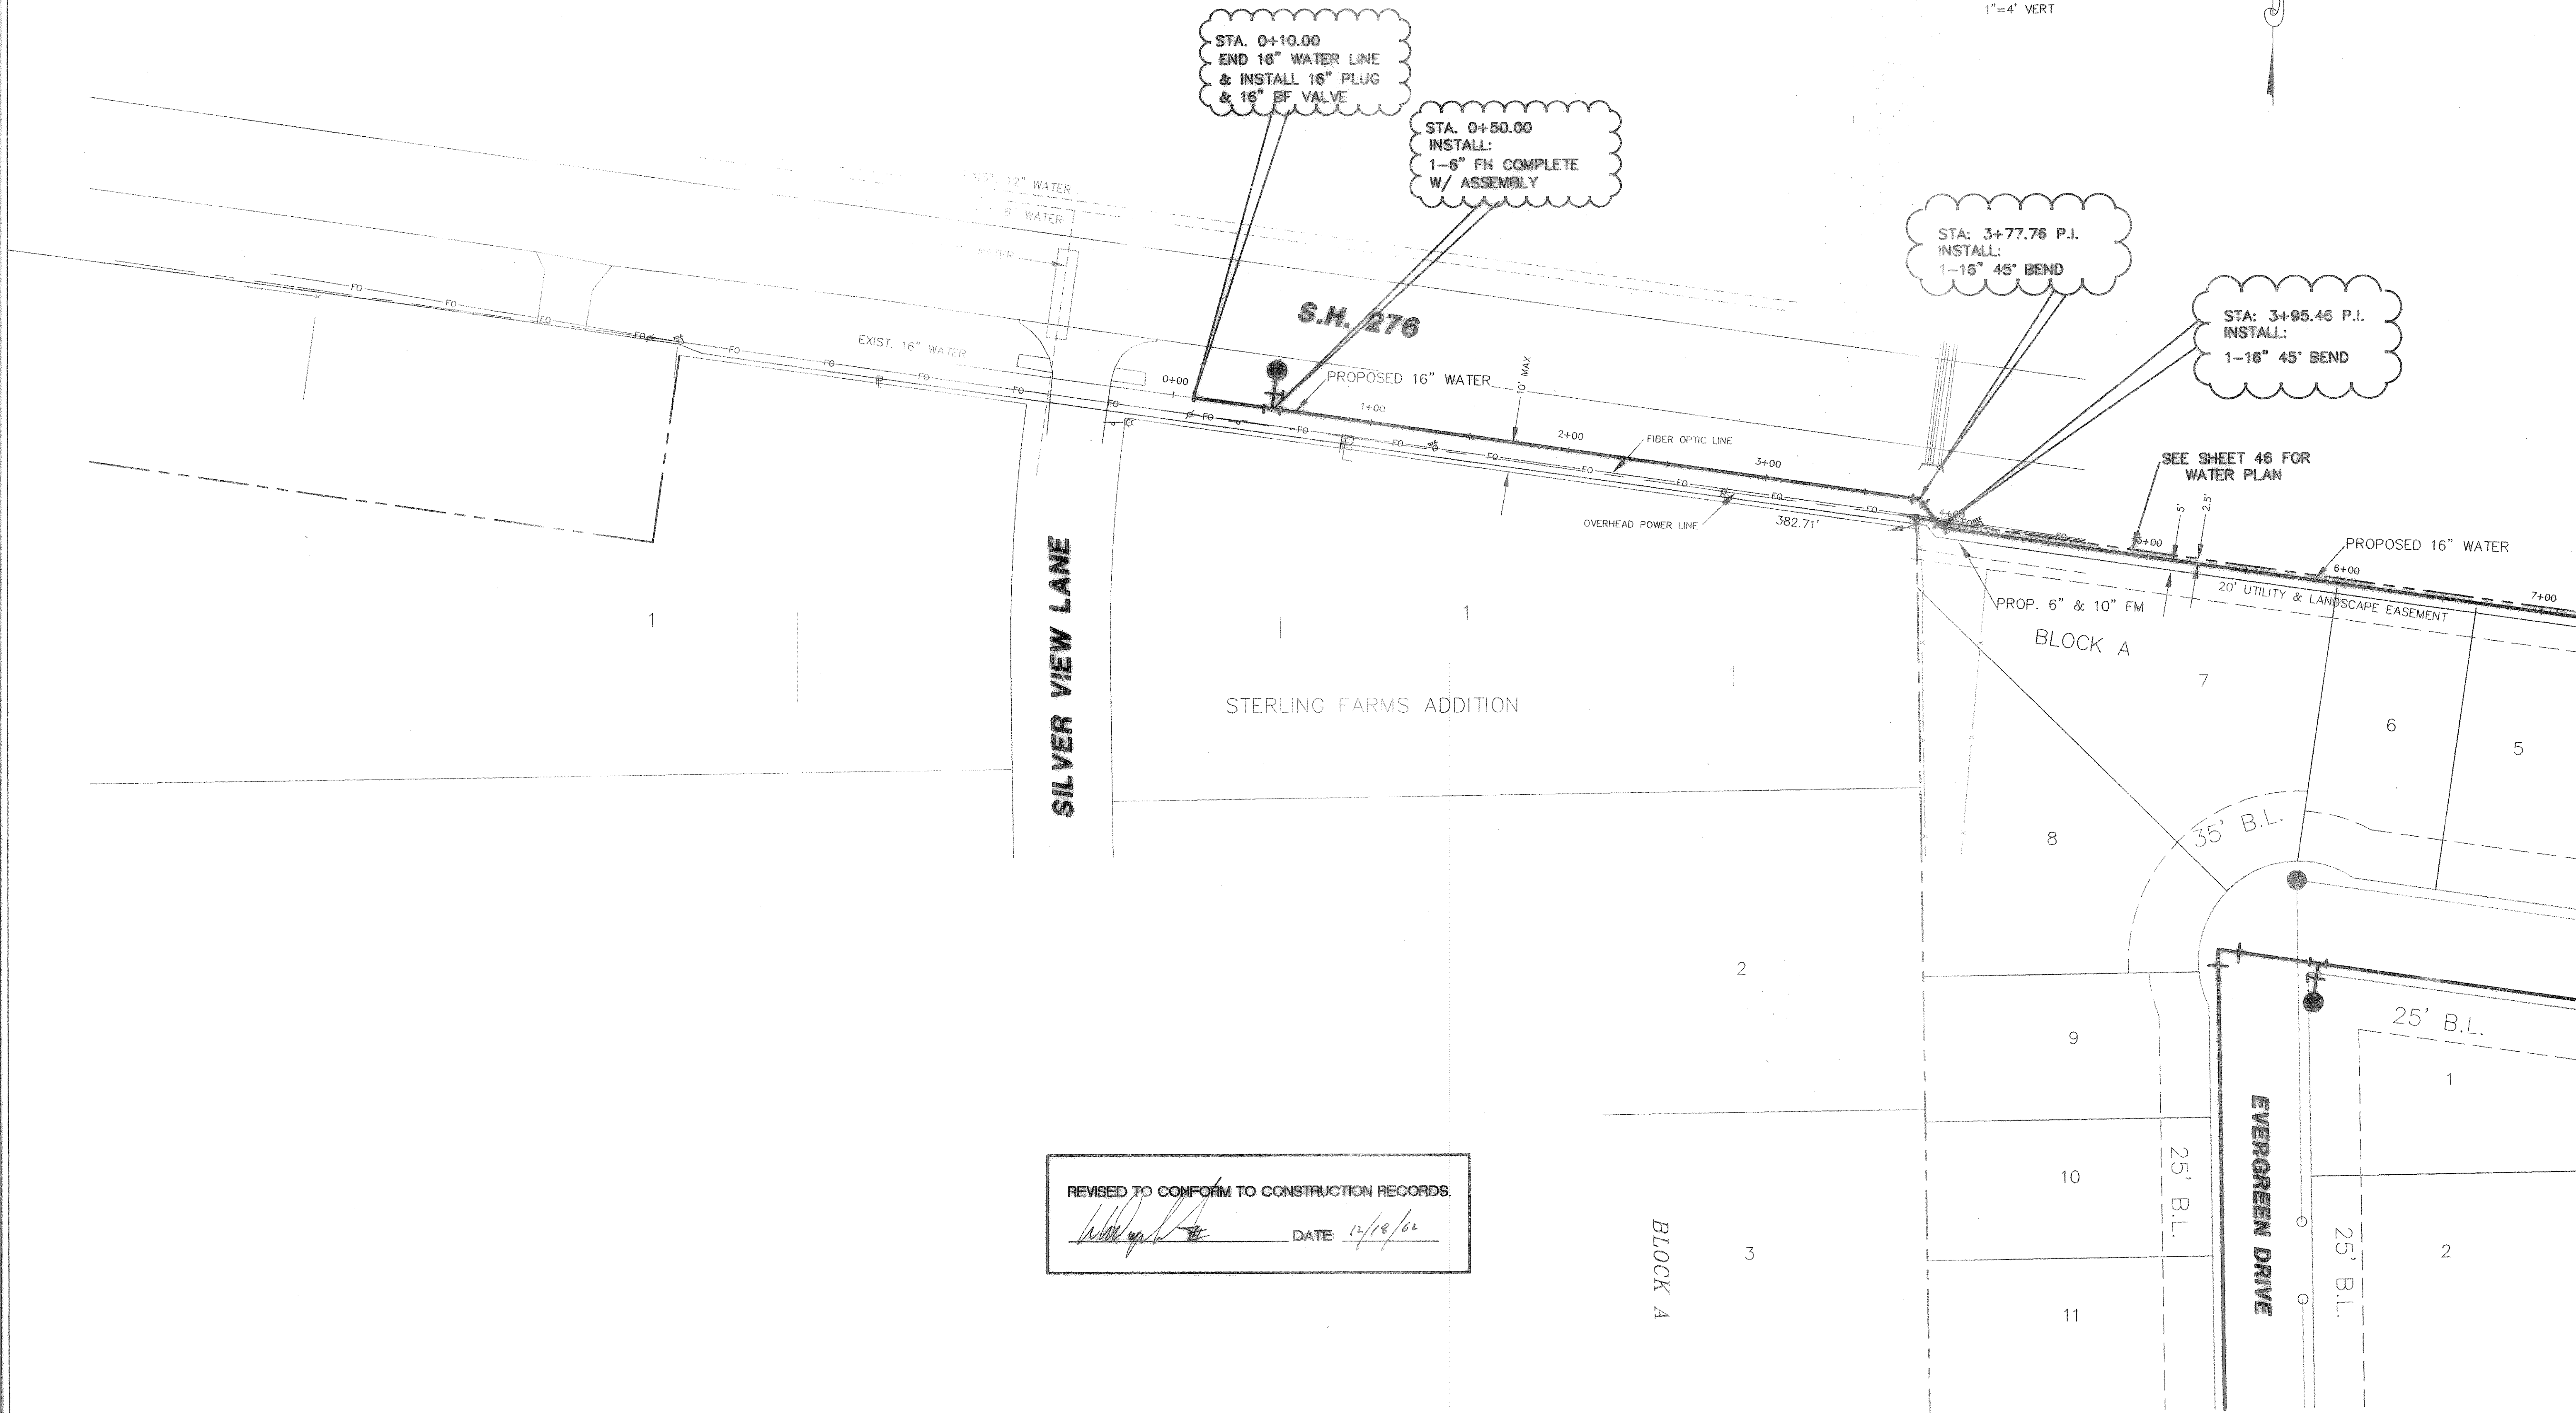

REVISED TO CONFORM TO CONSTRUCTION RECORDS.  
 DATE: 12/18/01

OFFSITE WATER PLAN  
 TIMBER CREEK ESTATES  
 CITY OF ROCKWALL  
 ROCKWALL COUNTY, TEXAS

REVISION	W.L.D.
CHECKED	K.E.B.
DRAWN	1/26/01
DATE	9913WAT2
PROJECT	46A OF