



DOUPHRADE & ASSOCIATES, INC.
 ENGINEERING - PROJECT MANAGEMENT - SURVEYING
 2235 RIDGE RD., # 200 ROCKWALL, TEXAS 75087
 PHONE: (972)771-0004 FAX: (972)771-9005

WATER LINE PROFILE
 TIMBER CREEK ESTATES
 CITY OF ROCKWALL
 COUNTY OF ROCKWALL

| |
|---------------------|
| REVISION |
| W.L.D. CHECKED |
| K.E.B. DRAWN |
| 1/26/01 DATE |
| 9913 WLP PROJECT |
| 46 B OF |

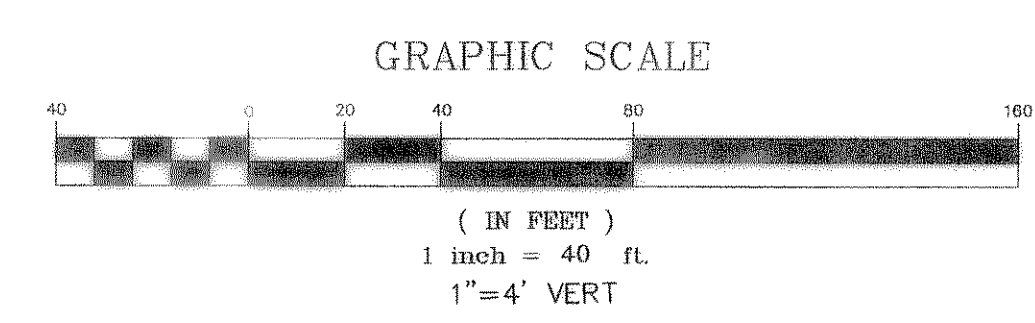

PROPOSED 16" WATER LINE

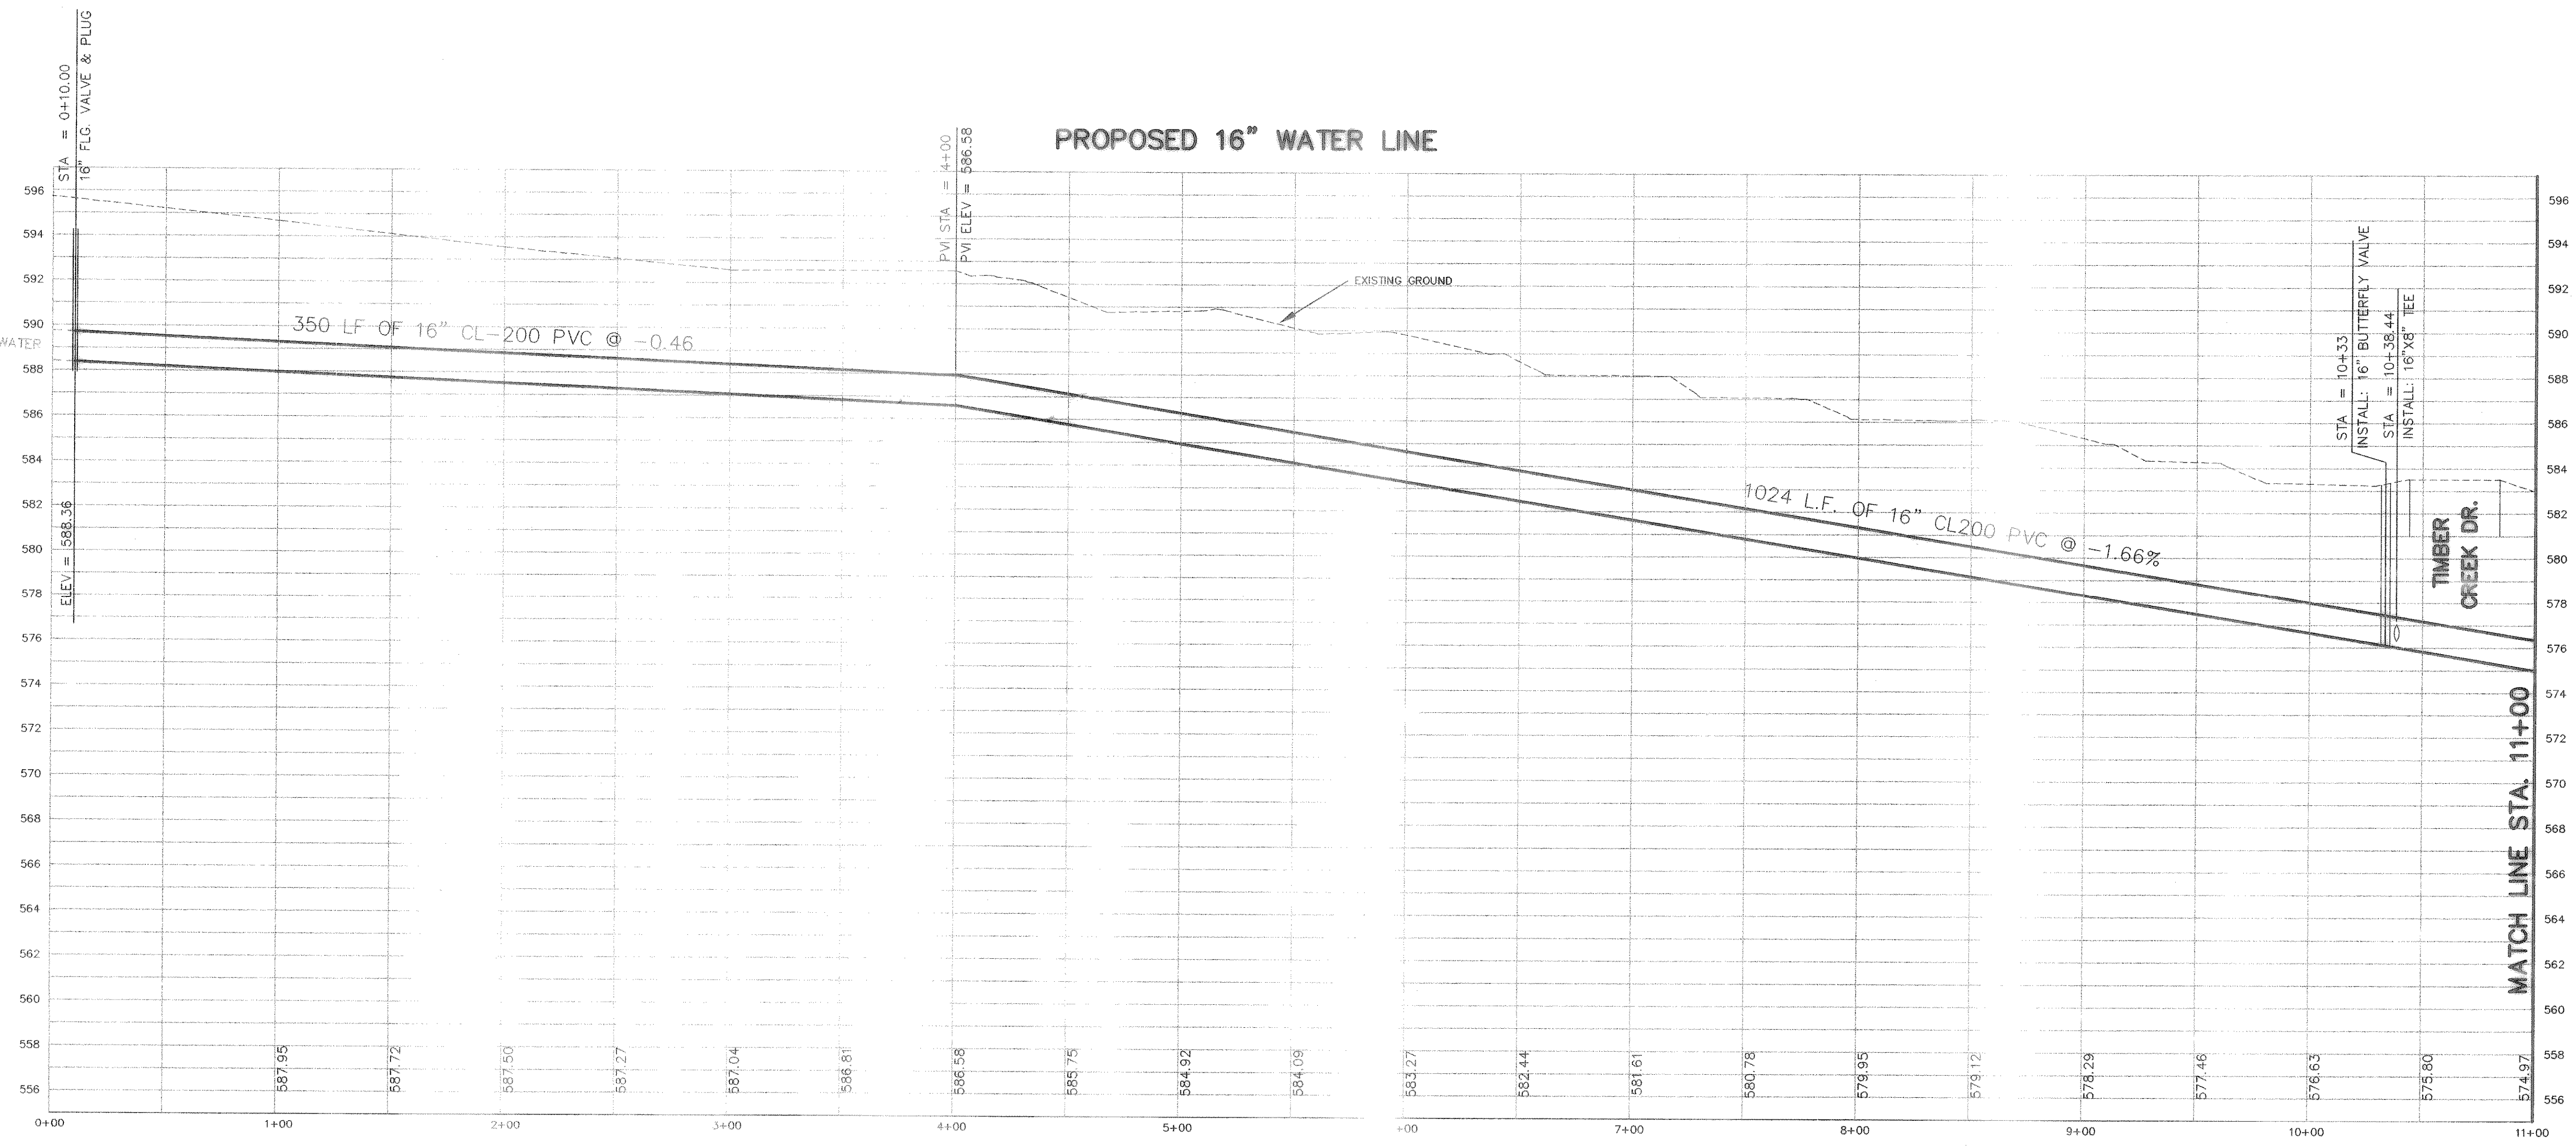

REVISED TO CONFORM TO CONSTRUCTION RECORDS.
W. Douphrate II
 DATE: 12/13/02