



**DOUPHRATE & ASSOCIATES, INC.**  
 ENGINEERING - PROJECT MANAGEMENT - SURVEYING  
 2235 RIDGE RD., # 200 ROCKWALL, TEXAS 75087  
 PHONE: (972)771-9004 FAX: (972)771-9005

WATER LINE PROFILE  
 TIMBER CREEK ESTATES  
 CITY OF ROCKWALL  
 COUNTY OF ROCKWALL

REVISION	
W.L.D.	
CHECKED	
K.E.B.	
DRAWN	
DATE	10/00
PROJECT	9913 WLP1
	46 C OF

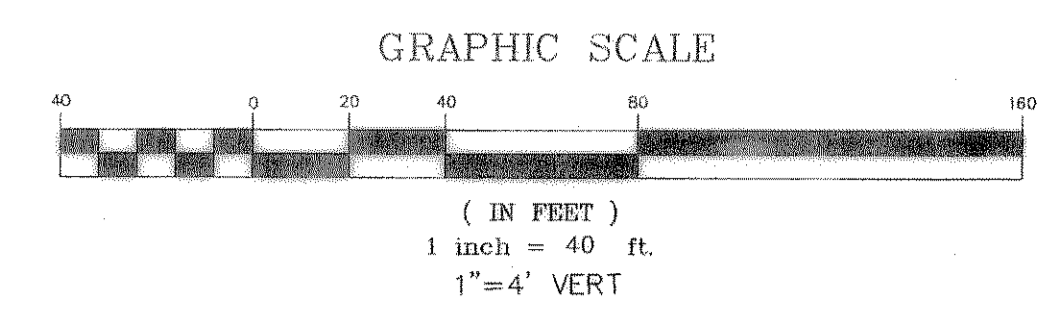

### 16" WATER LINE PROFILE

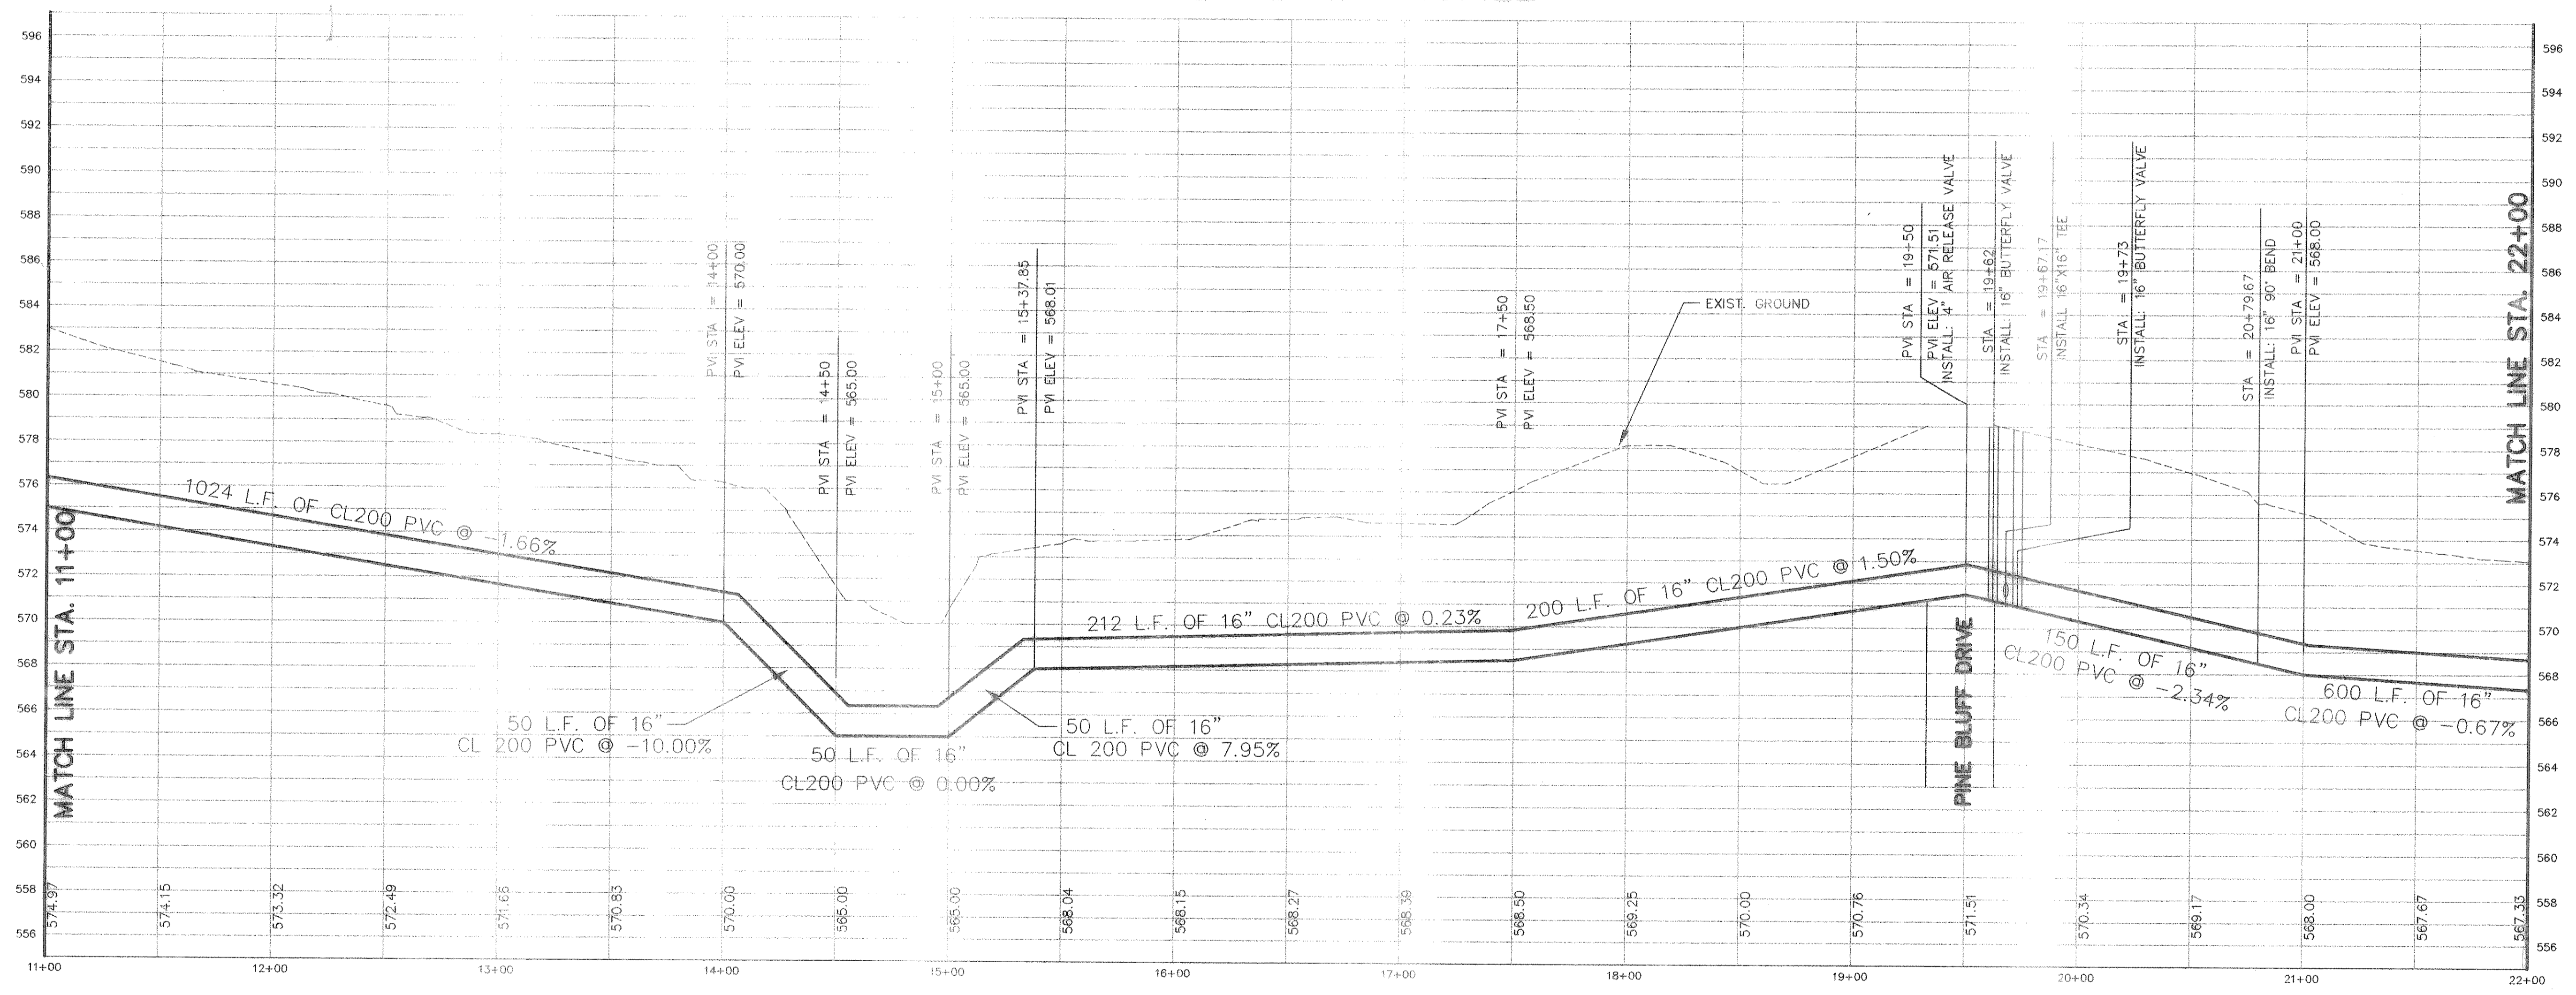

REVISED TO CONFORM TO CONSTRUCTION RECORDS.  
*W.L. Douphrate II* DATE: 12/18/02