



DOUPHRADE & ASSOCIATES, INC.  
 ENGINEERING • PROJECT MANAGEMENT • SURVEYING  
 2235 RIDGE RD., # 200 ROCKWALL, TEXAS 75087  
 PHONE: (972)771-9004 FAX: (972)771-9005

WATER LINE PROFILE  
 TIMBER CREEK ESTATES  
 CITY OF ROCKWALL  
 COUNTY OF ROCKWALL

REVISION	
CHECKED	W.L.D.
DRAWN	K.E.B.
DATE	10/00
PROJECT	9913 WLP2
46 D of 1	

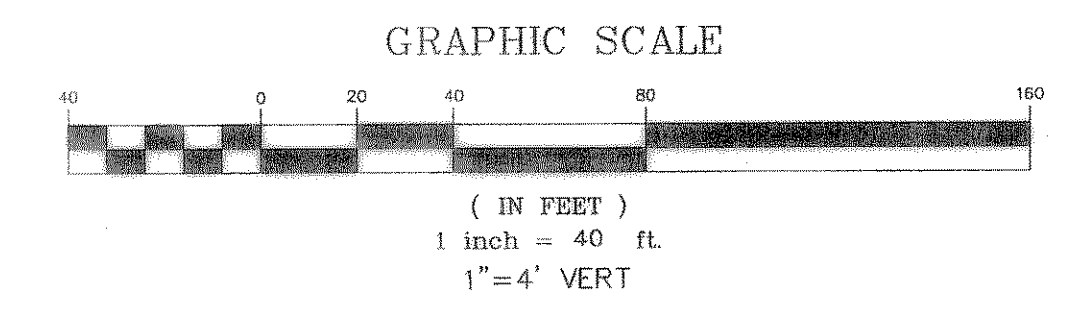

### PROPOSED 16" WATER LINE PROFILE

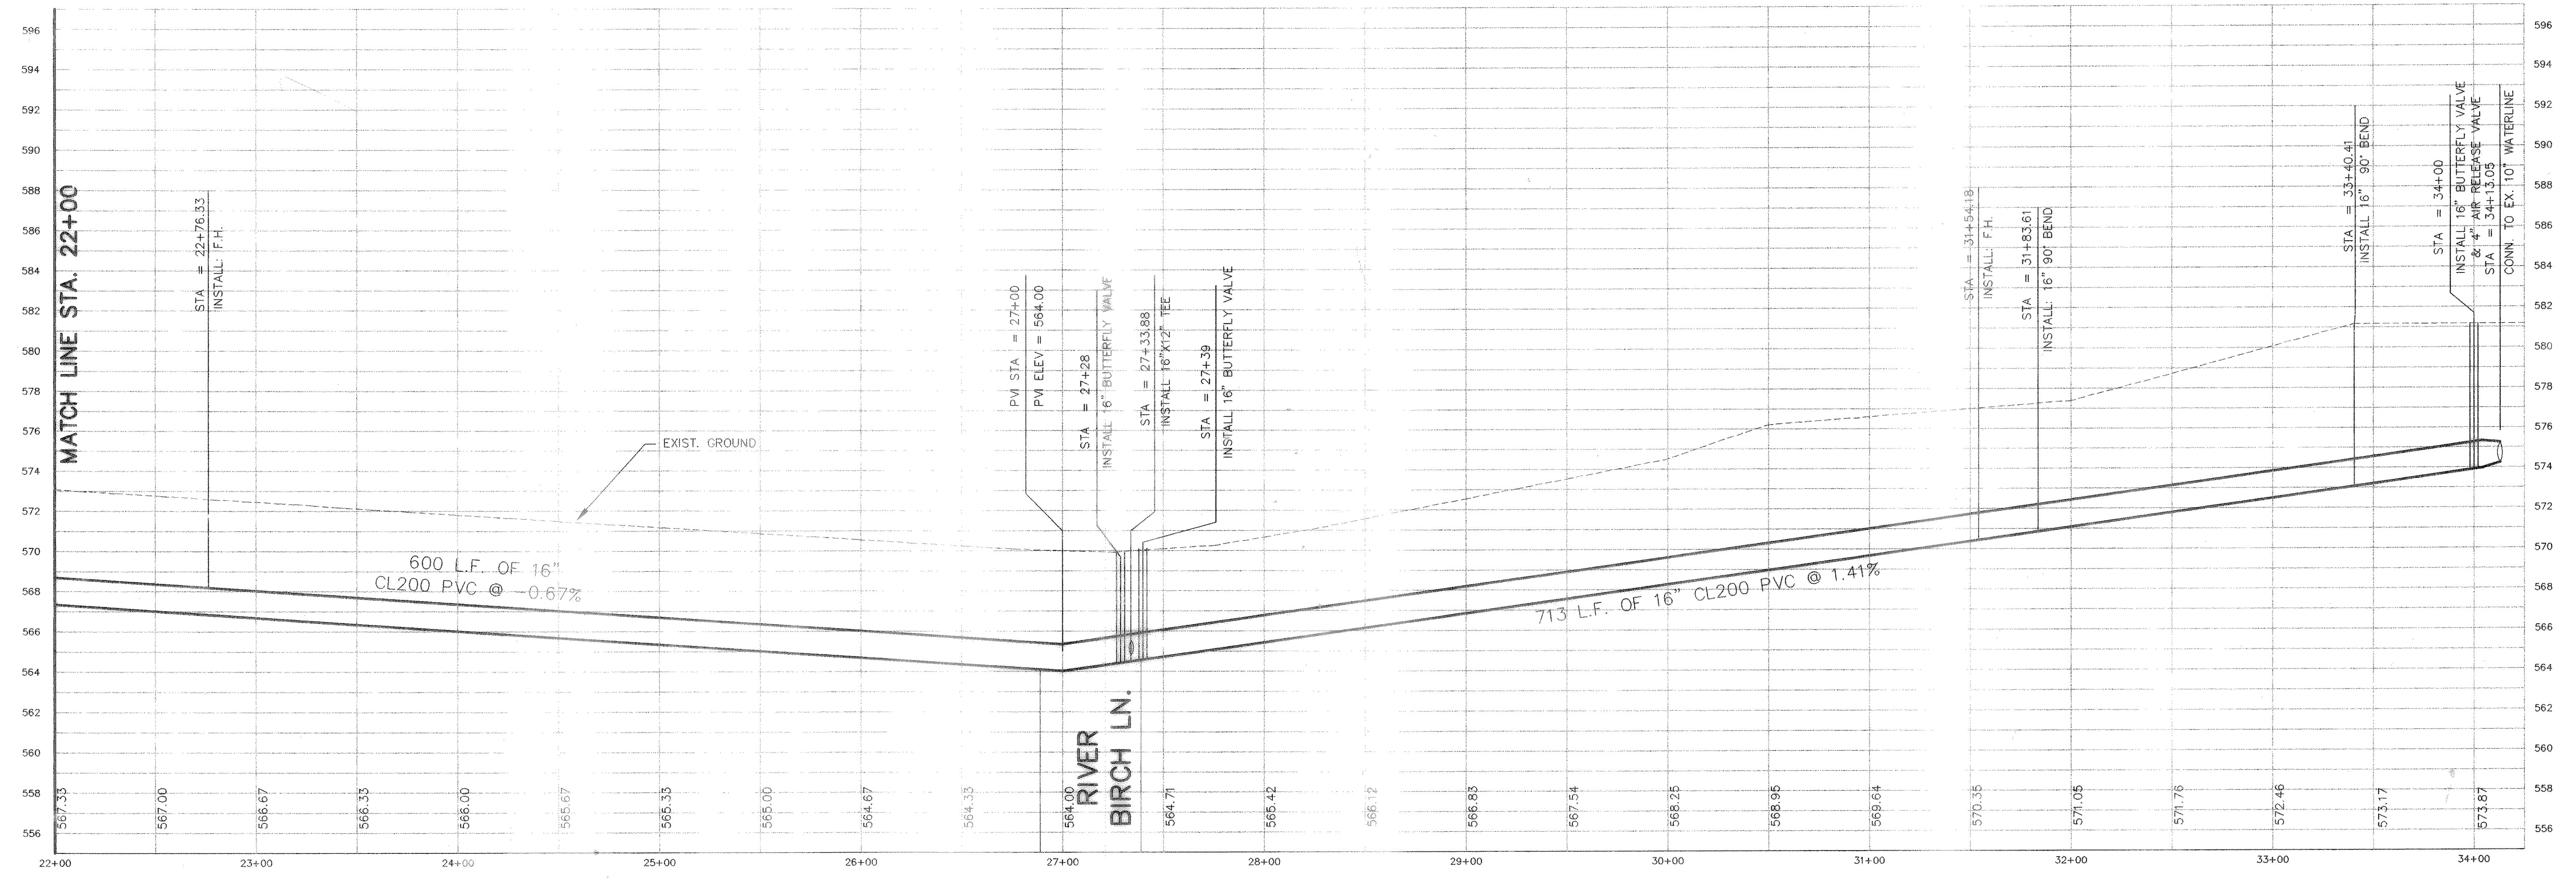

REVISED TO CONFORM TO CONSTRUCTION RECORDS.  
*[Signature]* DATE: 12/10/02