



THE SEAL APPEARING ON THIS DOCUMENT WAS AUTHORIZED BY W.L. DOUPHRATE II TEXAS P.E. NO. 00102 ON 7/26/01

DOUPHRATE & ASSOCIATES, INC.
 ENGINEERING - PROJECT MANAGEMENT - SURVEYING
 2235 RIDGE RD. # 200 ROCKWALL, TEXAS 75087
 PHONE: (972)771-9004 FAX: (972)771-9006


FORCE MAIN PLAN AND PROFILE
 STA: 72+00 TO 75+71.78
 TIMBER CREEK ESTATES
 CITY OF ROCKWALL, ROCKWALL COUNTY, TEXAS

REVISION
 W.L.D.
 CHECKED
 K.E.B.
 DRAWN
 6/28/01
 DATE
 9913FM3-7
 PROJECT


60
 OF

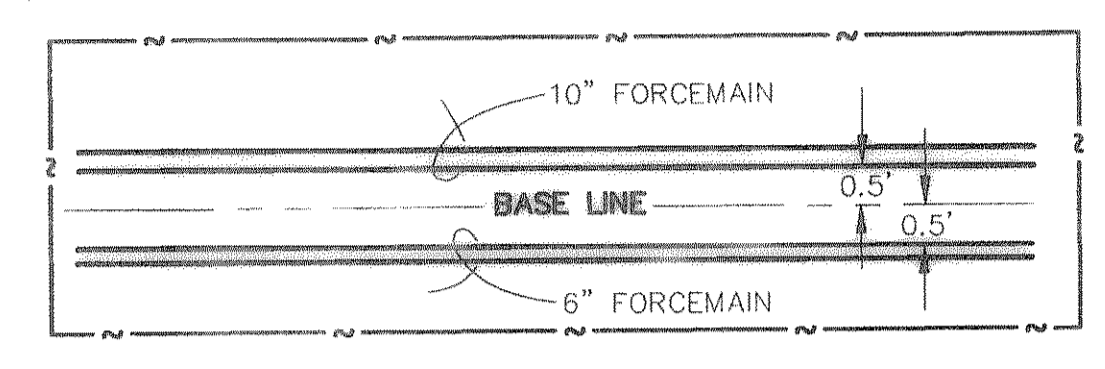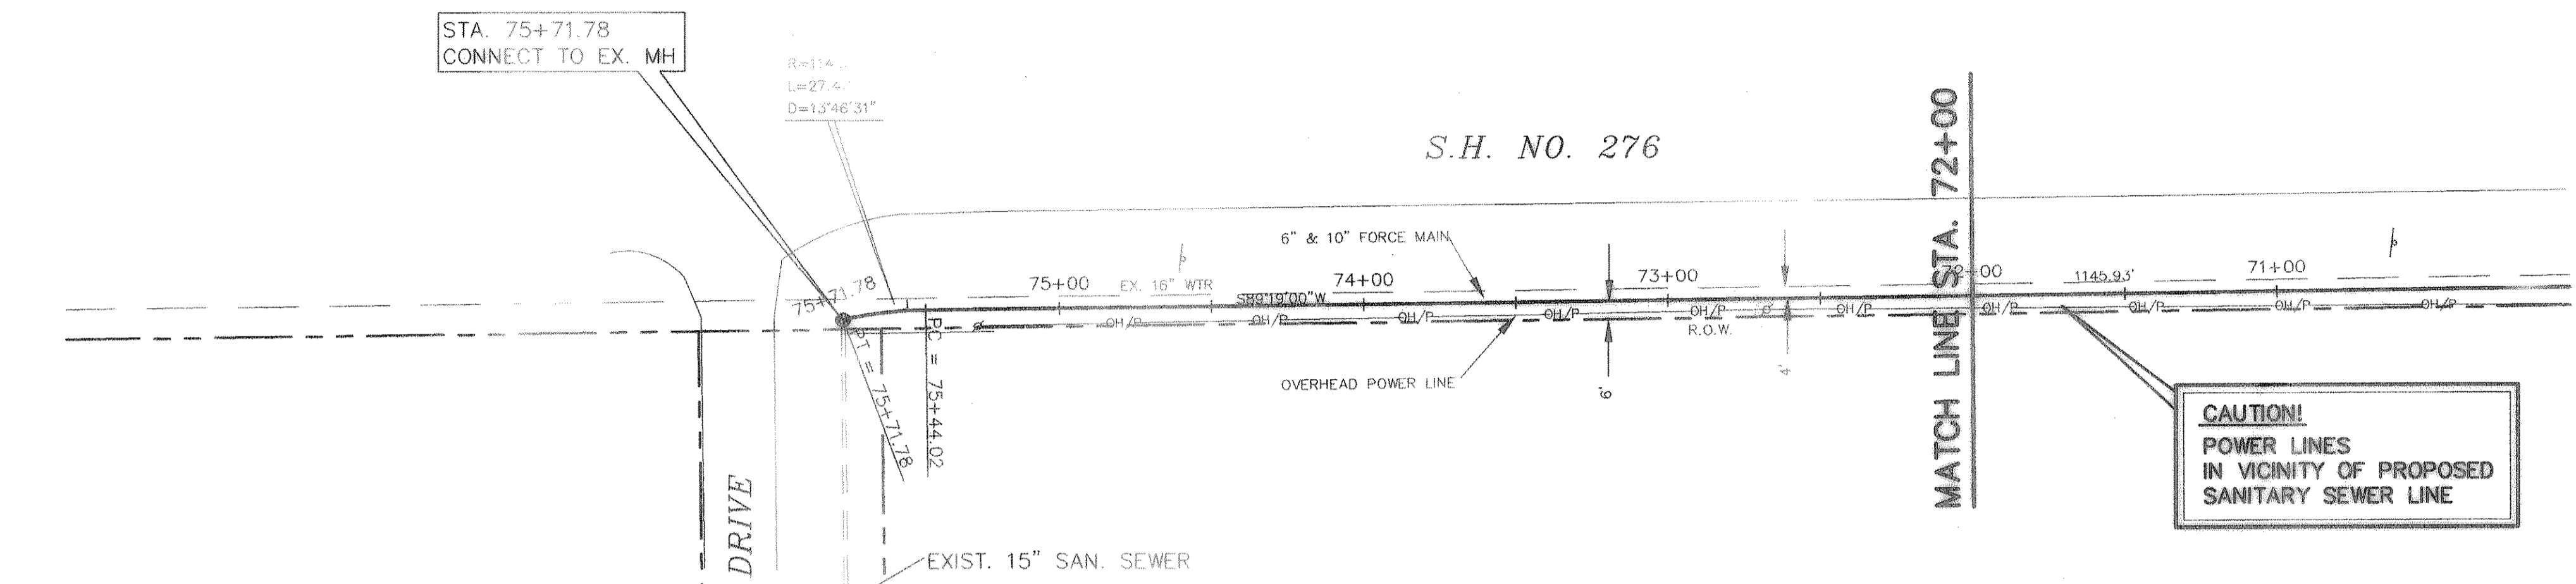

CAUTION!
 POWER LINES
 IN VICINITY OF PROPOSED
 SANITARY SEWER LINE

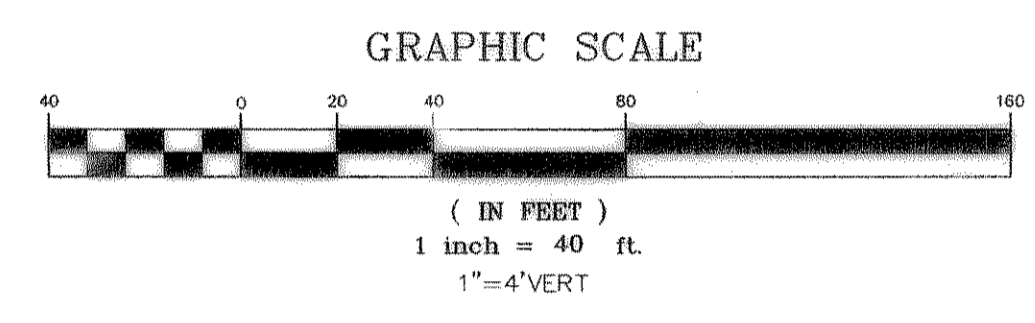

BENCHMARK:
 T.C. CENTERLINE OF INLET ON WEST SIDE
 OF SILVER VIEW LANE BETWEEN LOTS 4
 & 5, BLOCK B, OF STERLING FARMS
 ADDITION
 ELEV: 599.65

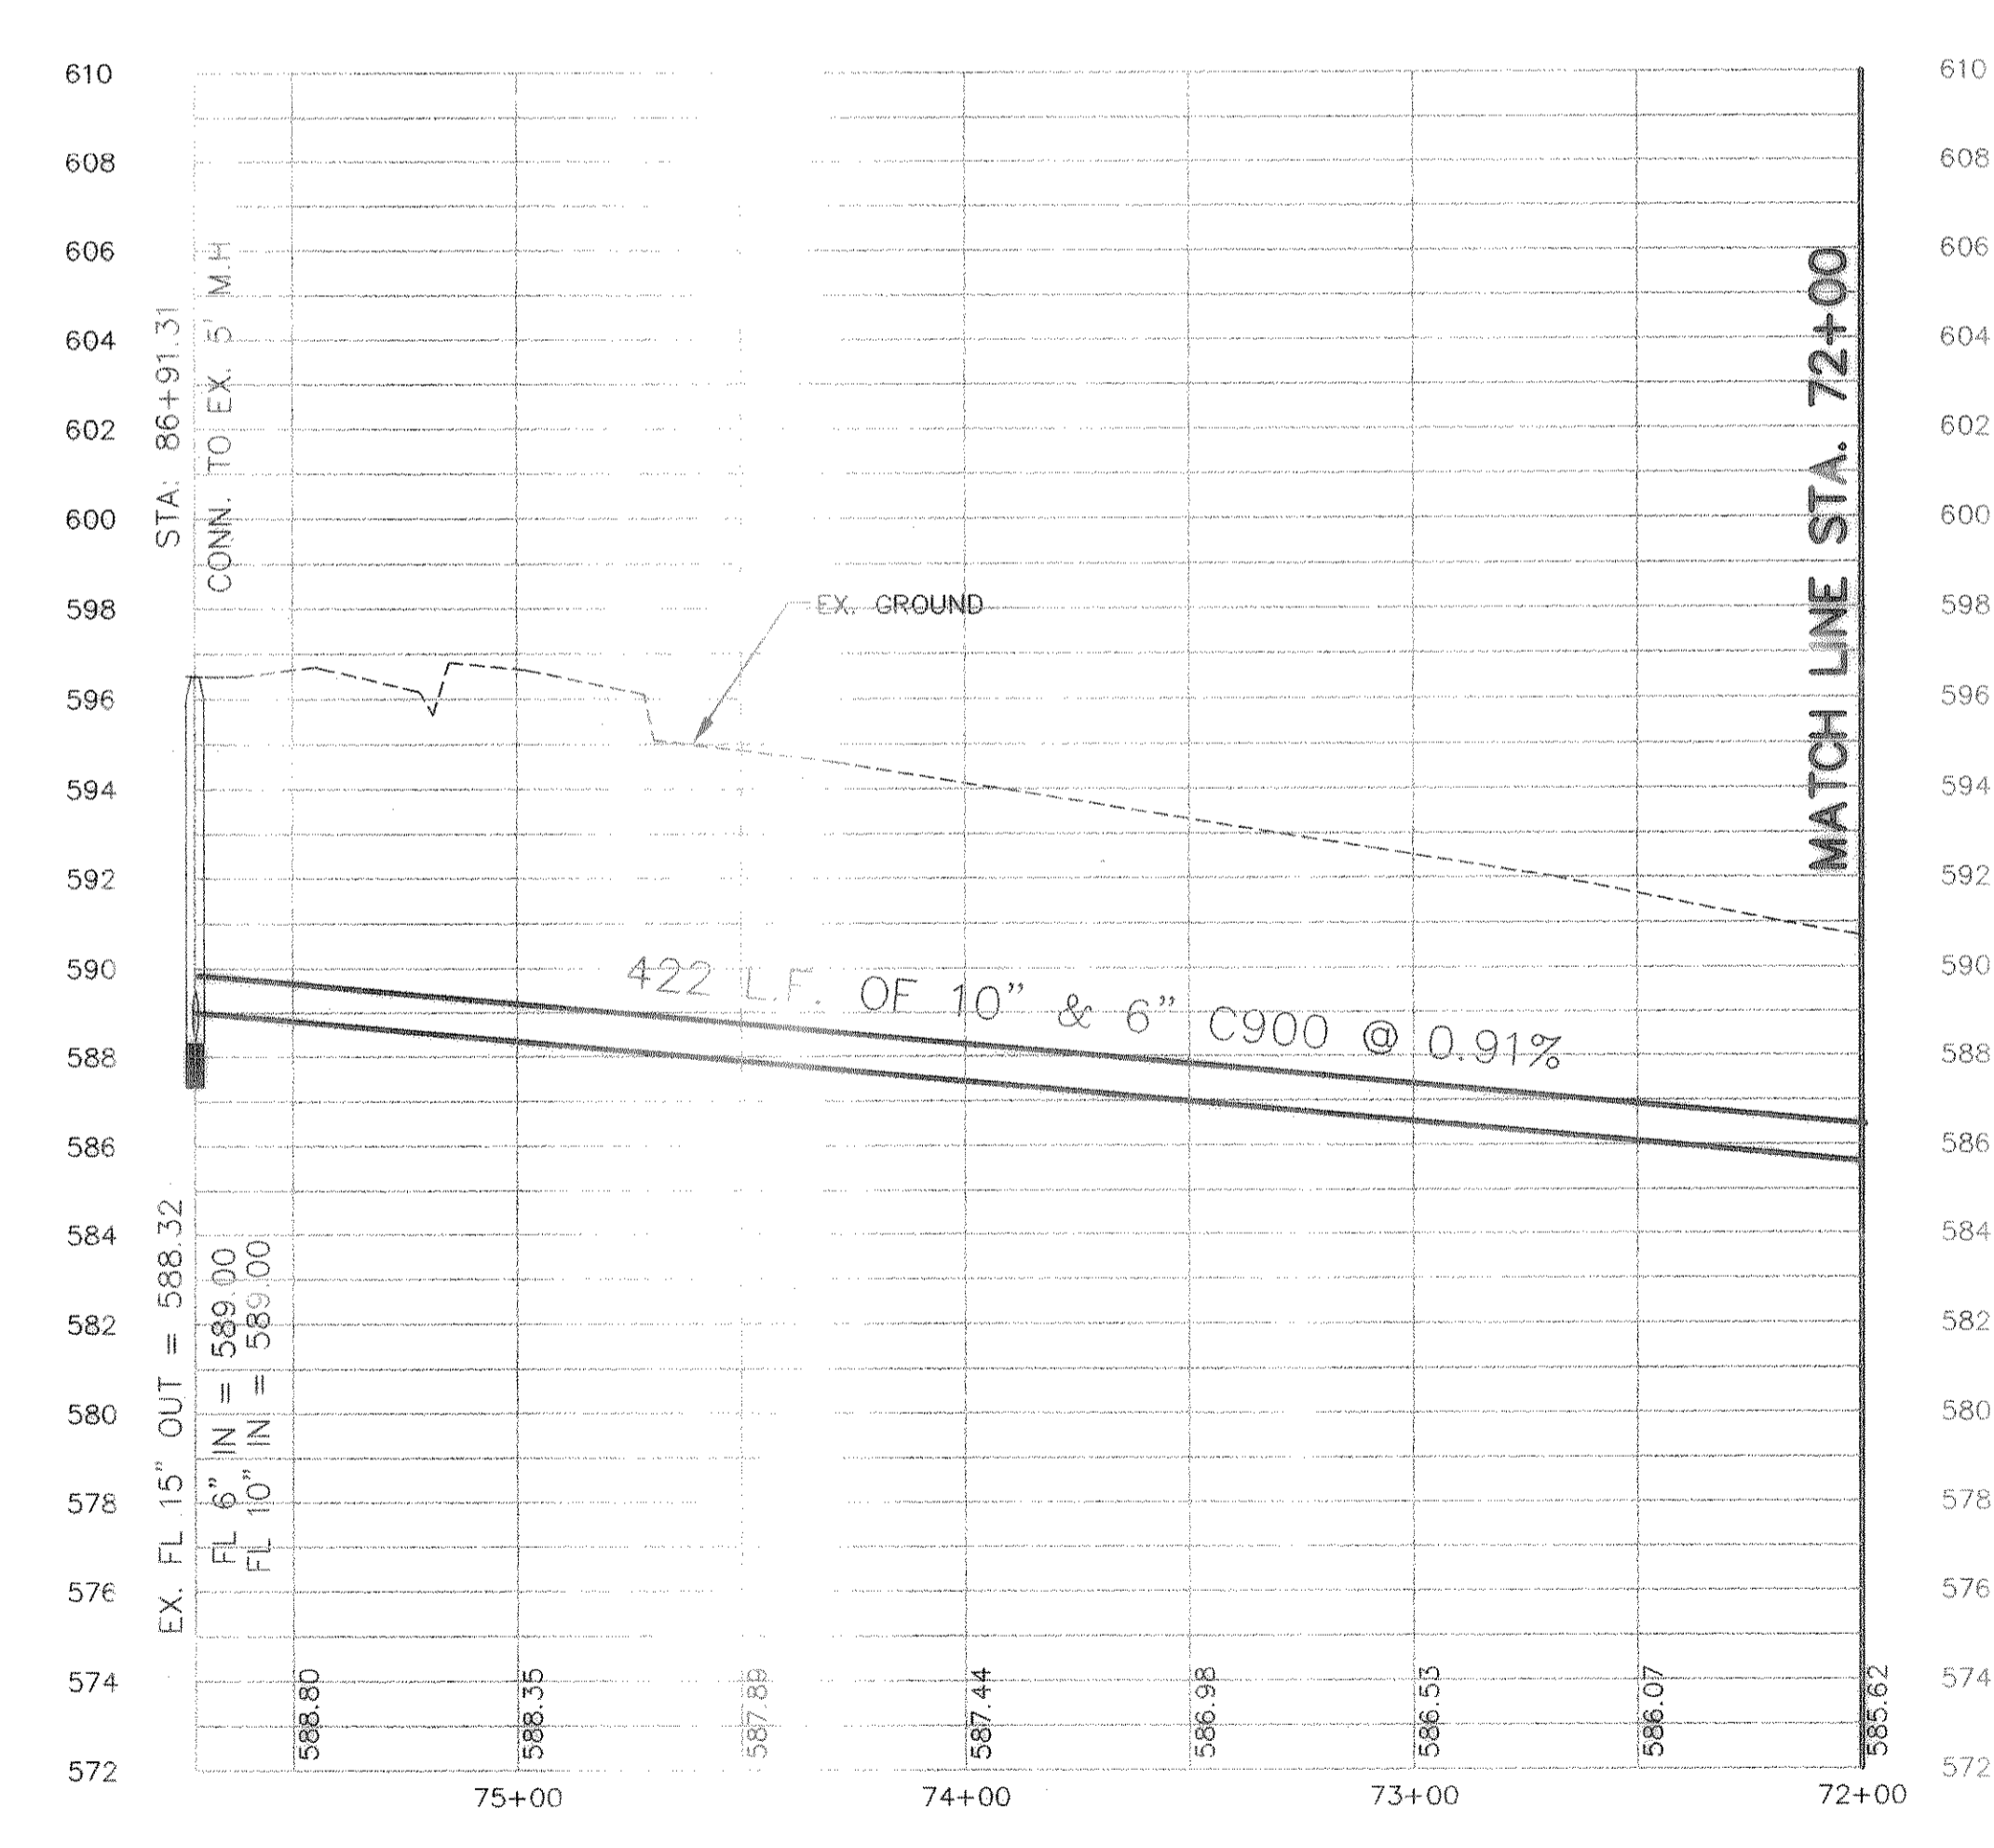

REVISED TO CONFORM TO CONSTRUCTION RECORDS.
[Signature] DATE: 12/03/02