


REVISED TO CONFORM TO CONSTRUCTION RECORDS.

*W. L. D.* DATE: 12/18/01

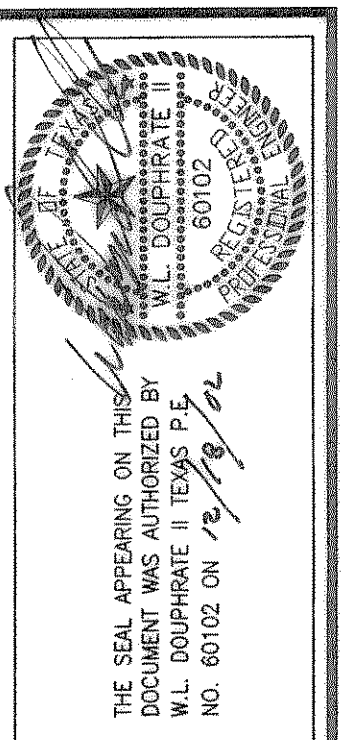

DOUPHRATE & ASSOCIATES, INC.  
ENGINEERING - PROJECT MANAGEMENT - SURVEYING  
2235 RIDGE RD., # 200 ROCKWALL, TEXAS 75087  
PHONE: (972)771-9004 FAX: (972)771-9005

STORM SEWER PLAN & PROFILE  
LINE J  
TIMBER CREEK ESTATES  
CITY OF ROCKWALL, ROCKWALL COUNTY, TEXAS

REVISION
W.L.D.
CHECKED
B.W.H.
DRAWN
1/18/01
DATE
9913STM10
PROJECT