
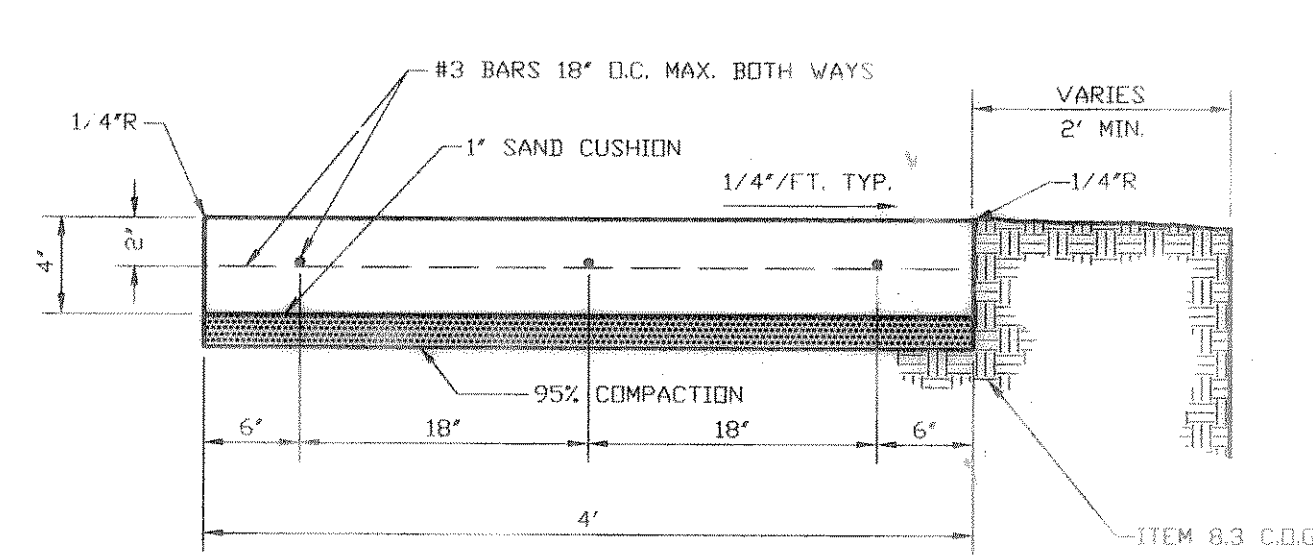
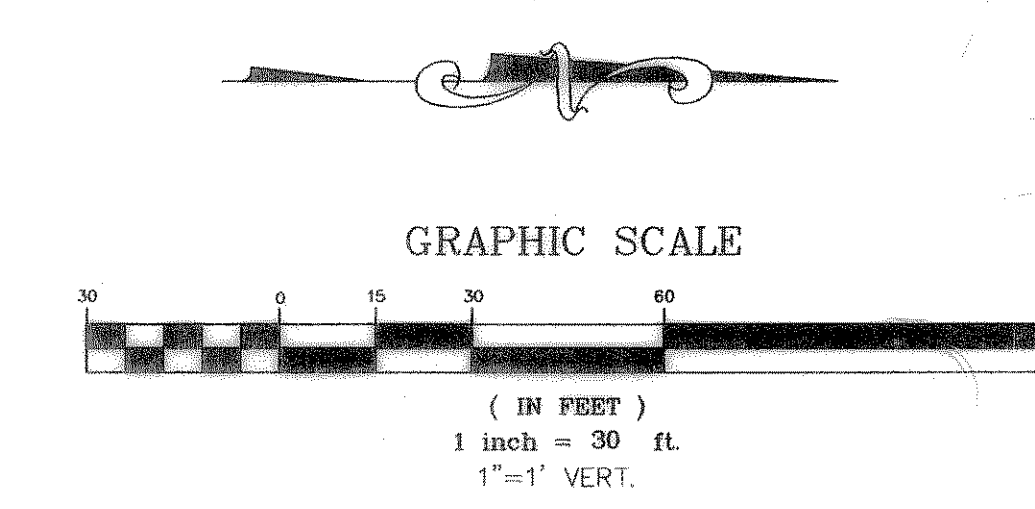


DOUPHRADE & ASSOCIATES, INC.
 ENGINEERING - PROJECT MANAGEMENT - SURVEYING
 2235 RIDGE RD., # 200 ROCKWALL, TEXAS 75087
 PHONE: (972)771-9004 FAX: (972)771-9005

PEDESTRIAN SIDEWALK PLAN & PROFILE
 WALK 1
 TIMBER CREEK ESTATES
 CITY OF ROCKWALL, ROCKWALL COUNTY, TEXAS

REVISION	W.L.D.
CHECKED	K.E.B.
DRAWN	8/11/00
DATE	9913 WALK1
PROJECT	77
	07

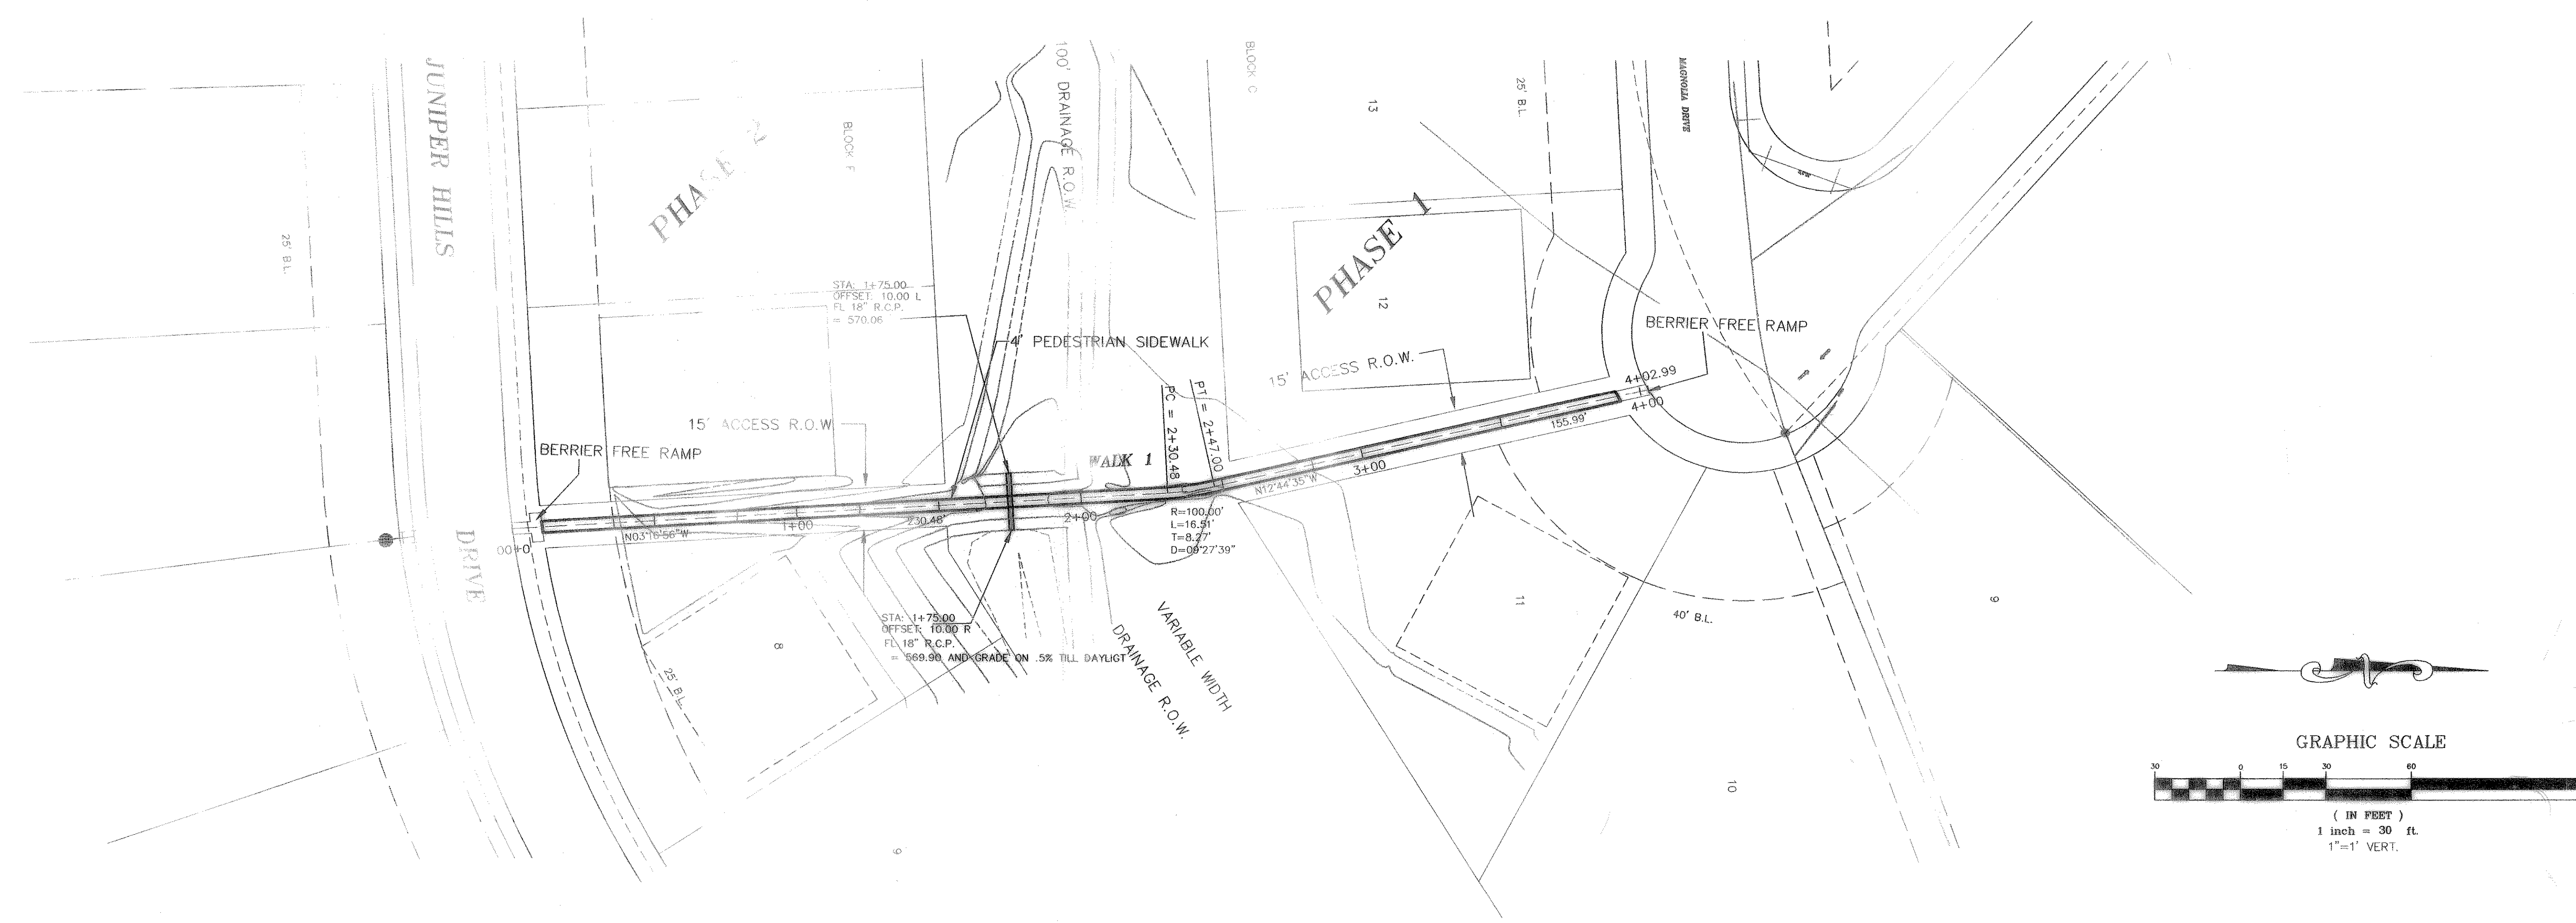

REVISED TO CONFORM TO CONSTRUCTION RECORDS.
 WLD
 DATE: 2/10/02

