


THE SEAL APPEARING ON THIS DOCUMENT WAS AUTHORIZED BY THE BOARD OF ENGINEERING EXAMINERS, STATE OF TEXAS, NO. 60102 ON 12/20/02

DOUPHRATE & ASSOCIATES, INC.
ENGINEERING - PROJECT MANAGEMENT - SURVEYING
22335 RIDGE RD., # 200 ROCKWALL, TEXAS 75087
PHONE: (972) 771-9004 FAX: (972) 771-9005

LOT GRADING PLAN
TIMBER CREEK ESTATES
CITY OF ROCKWALL
ROCKWALL COUNTY, TEXAS

6/24/02	REVISED NOTE
REVISION	
W.L.D.	CHECKED
K.E.B.	DRAWN
7/25/00	DATE
9913GRD1	PROJECT
8	OF

BENCHMARK:
T.C. CENTERLINE OF INLET ON WEST SIDE OF SILVER VIEW LANE BETWEEN LOTS 4 & 5, BLOCK B, OF STERLING FARMS ADDITION
ELEV. = 599.65

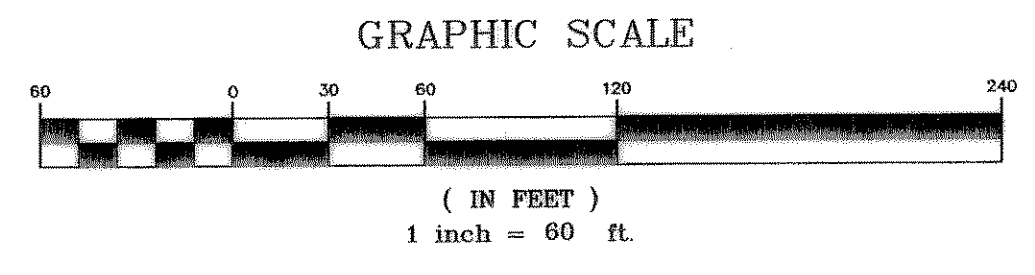

REVISED TO CONFORM TO CONSTRUCTION RECORDS.
WLD DATE: 5/23/03



SEE SHEET 8A

SEE SHEET 8B

STERLING FARMS ADDITION
CAB. C. SLIDES 395 & 396
P.R.R.C.T.
1228' 01"

1228' 01"

1
2
3
4
5
6

1
2
3
4
5
6