

DOUPHRAE & ASSOCIATES, INC.  
ENGINEERING - PROJECT MANAGEMENT - SURVEYING  
2235 RIDGE RD., # 200 ROCKWALL, TEXAS 75087  
PHONE: (972)771-9004 FAX: (972)771-9005


LOT GRADING PLAN  
TIMBER CREEK ESTATES  
CITY OF ROCKWALL  
ROCKWALL COUNTY, TEXAS

REVISION
W.L.D. CHECKED
K.E.B. DRAWN
7/25/00 DATE
9913GRD2 PROJECT
8A OF



N89°57'55" W 523.75'

80.42 AC.  
MC CLENDON CORP.  
VOL. 91, PG. 526

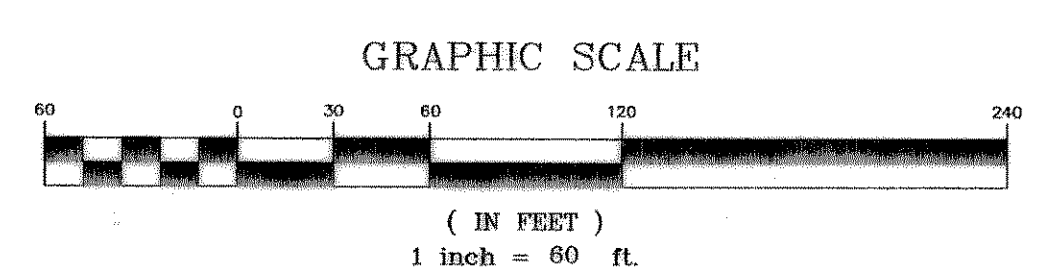

**BENCHMARK:**  
T.C. CENTERLINE OF INLET ON WEST SIDE OF SILVER VIEW LANE BETWEEN LOTS 4 & 5, BLOCK B, OF STERLING FARMS ADDITION  
ELEV: 599.65

REVISED TO CONFORM TO CONSTRUCTION RECORDS.  
DATE: 5/23/02

WEST UNION INVESTMENT CO.  
81.49 AC.  
VOL. 377, PG. 273