

**DOUPHRADE & ASSOCIATES, INC.**  
 ENGINEERING • PROJECT MANAGEMENT • SURVEYING  
 2235 RIDGE RD., # 200 ROCKWALL, TEXAS 75087  
 PHONE: (972)771-9004 FAX: (972)771-9005

**LOT GRADING PLAN**  
**TIMBER CREEK ESTATES**  
 CITY OF ROCKWALL  
 ROCKWALL COUNTY, TEXAS

6/24/02  
 REVISION NOTE  
 7/23/02  
 REVISED GRADE TO DRAIN BEHIND LOTS 15, 16, & 17

REVISION
W.L.D. CHECKED
K.E.B. DRAWN
7/25/00 DATE
9913GRD3 PROJECT


8B OF



NOTE: DO NOT GRADE THIS AREA UNTIL 404 PERMIT IS OBTAINED.

REVISED TO CONFORM TO CONSTRUCTION RECORDS.  
 DATE: 5/23/02

TB=XX.X = CL TOP OF PROPOSED BERM  
 TS=XX.X = TOE OF PROPOSED BERM

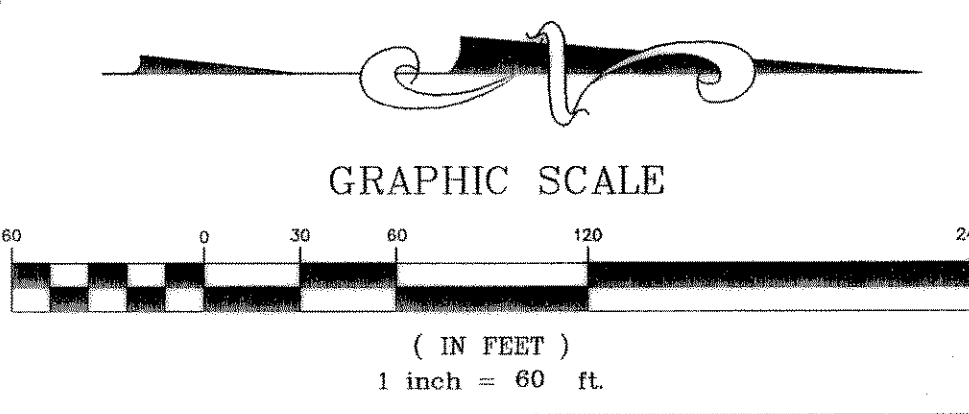

S89°05'11" W

1307.46'

S01°02'25" E

1407.66'

10' BLACKLAND WATER SUPPLY EASEMENT VOL. 76, PG. 41 D.R.R.C.T.