


REVISED TO CONFORM TO CONSTRUCTION RECORDS.  
DATE: 5/23/03

BENCHMARK:  
T.C. CENTERLINE OF INLET ON WEST SIDE  
OF SILVER VIEW LANE BETWEEN LOTS 4  
& 5, BLOCK B, OF STERLING FARMS  
ADDITION  
ELEV: 599.65

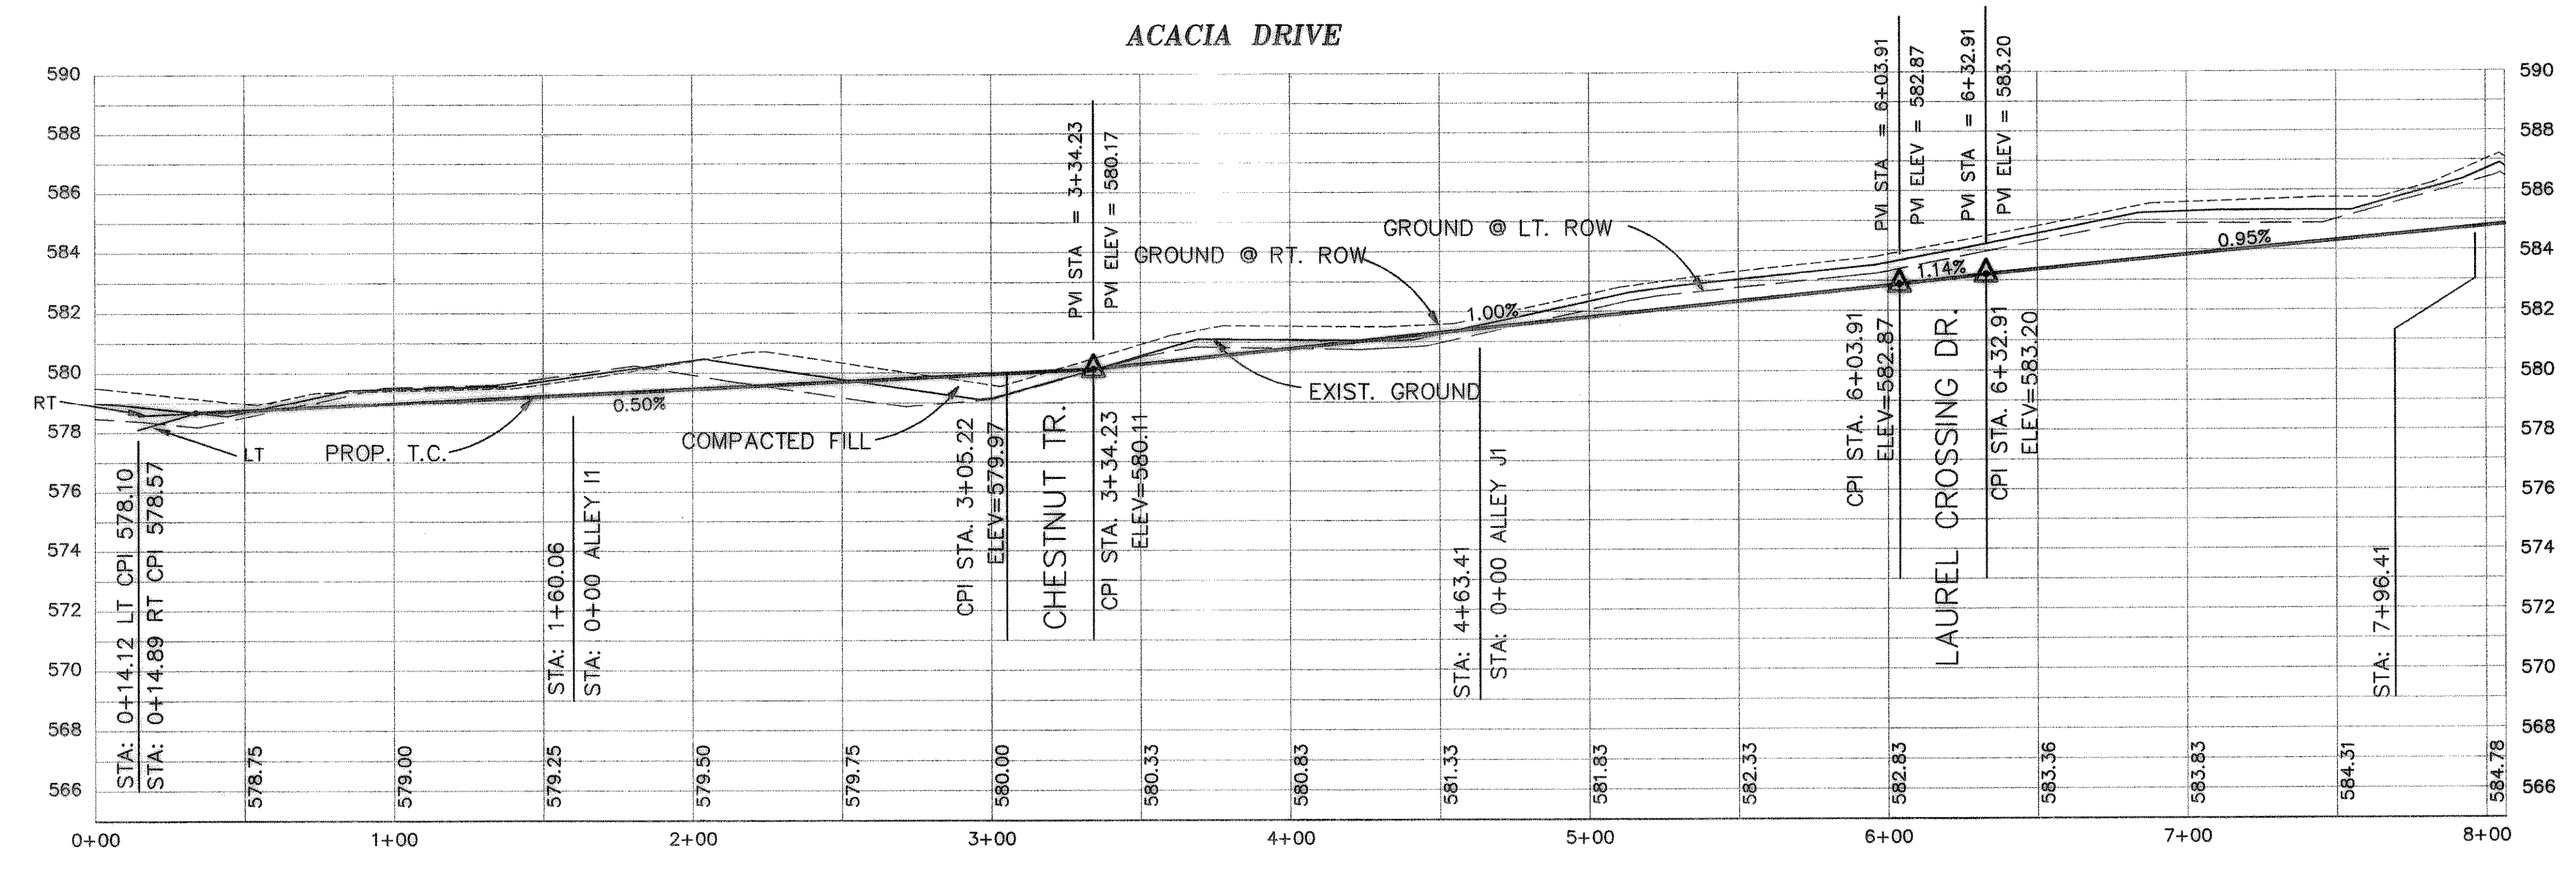

THE SEALED DRAWING ON THIS DOCUMENT WAS AUTHORIZED BY W.L. DOUPHRATE II TEXAS P.E. NO. 80102 ON 2/2/01

DOUPHRATE & ASSOCIATES, INC.  
CONCRETE • PROJECT MANAGEMENT • SURVEYING  
2235 RIDGE RD., # 200 ROCKWALL, TEXAS 75087  
PHONE: (972)771-9004 FAX: (972)771-9005

PAVING PLAN & PROFILE  
ACACIA DRIVE  
TIMBER CREEK ESTATES  
CITY OF ROCKWALL, ROCKWALL COUNTY, TEXAS

REVISION	
CHECKED	W.L.D.
DRAWN	K.E.B.
DATE	7/17/00
PROJECT	9913PV8
	28 OF