
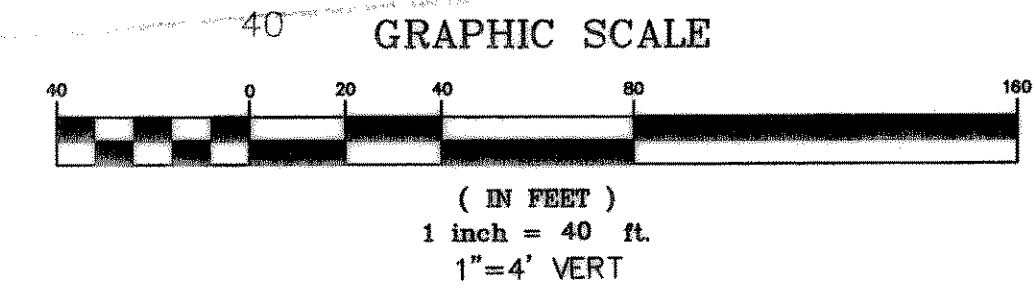



DOUPHRADE & ASSOCIATES, INC.  
 ENGINEERING - PROJECT MANAGEMENT - SURVEYING  
 2255 RIDGE RD., # 200 ROCKWALL, TEXAS 75087  
 PHONE: (972)771-9004 FAX: (972)771-9005

PAVING PLAN & PROFILE  
 LAUREL CROSSING DR. STA: 0+00 TO 9+51.59  
 TIMBER CREEK ESTATES  
 CITY OF ROCKWALL, ROCKWALL COUNTY, TEXAS

REVISION	
CHECKED	W.L.D.
DRAWN	K.E.B.
DATE	7/17/00
PROJECT	9913PV10
	30 OF

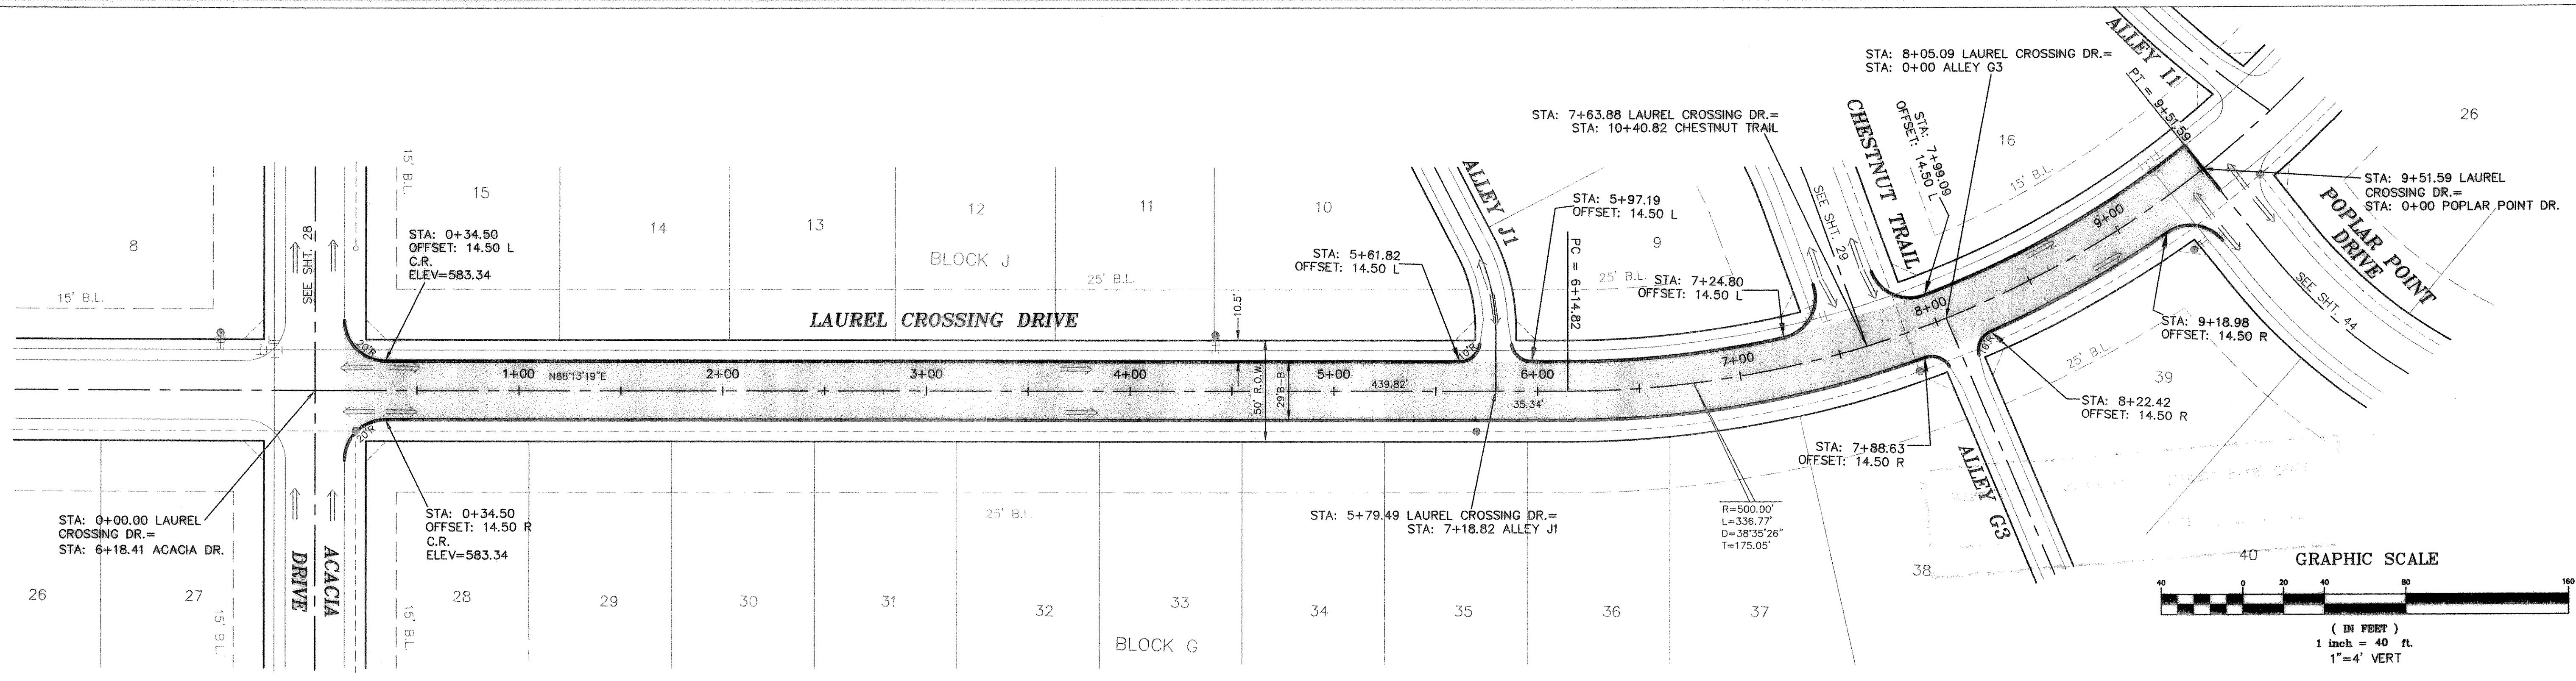

BENCHMARK:  
 T.C. CENTERLINE OF INLET ON WEST SIDE  
 OF SILVER VIEW LANE BETWEEN LOTS 4  
 & 5, BLOCK B, OF STERLING FARMS  
 ADDITION  
 ELEV: 599.65

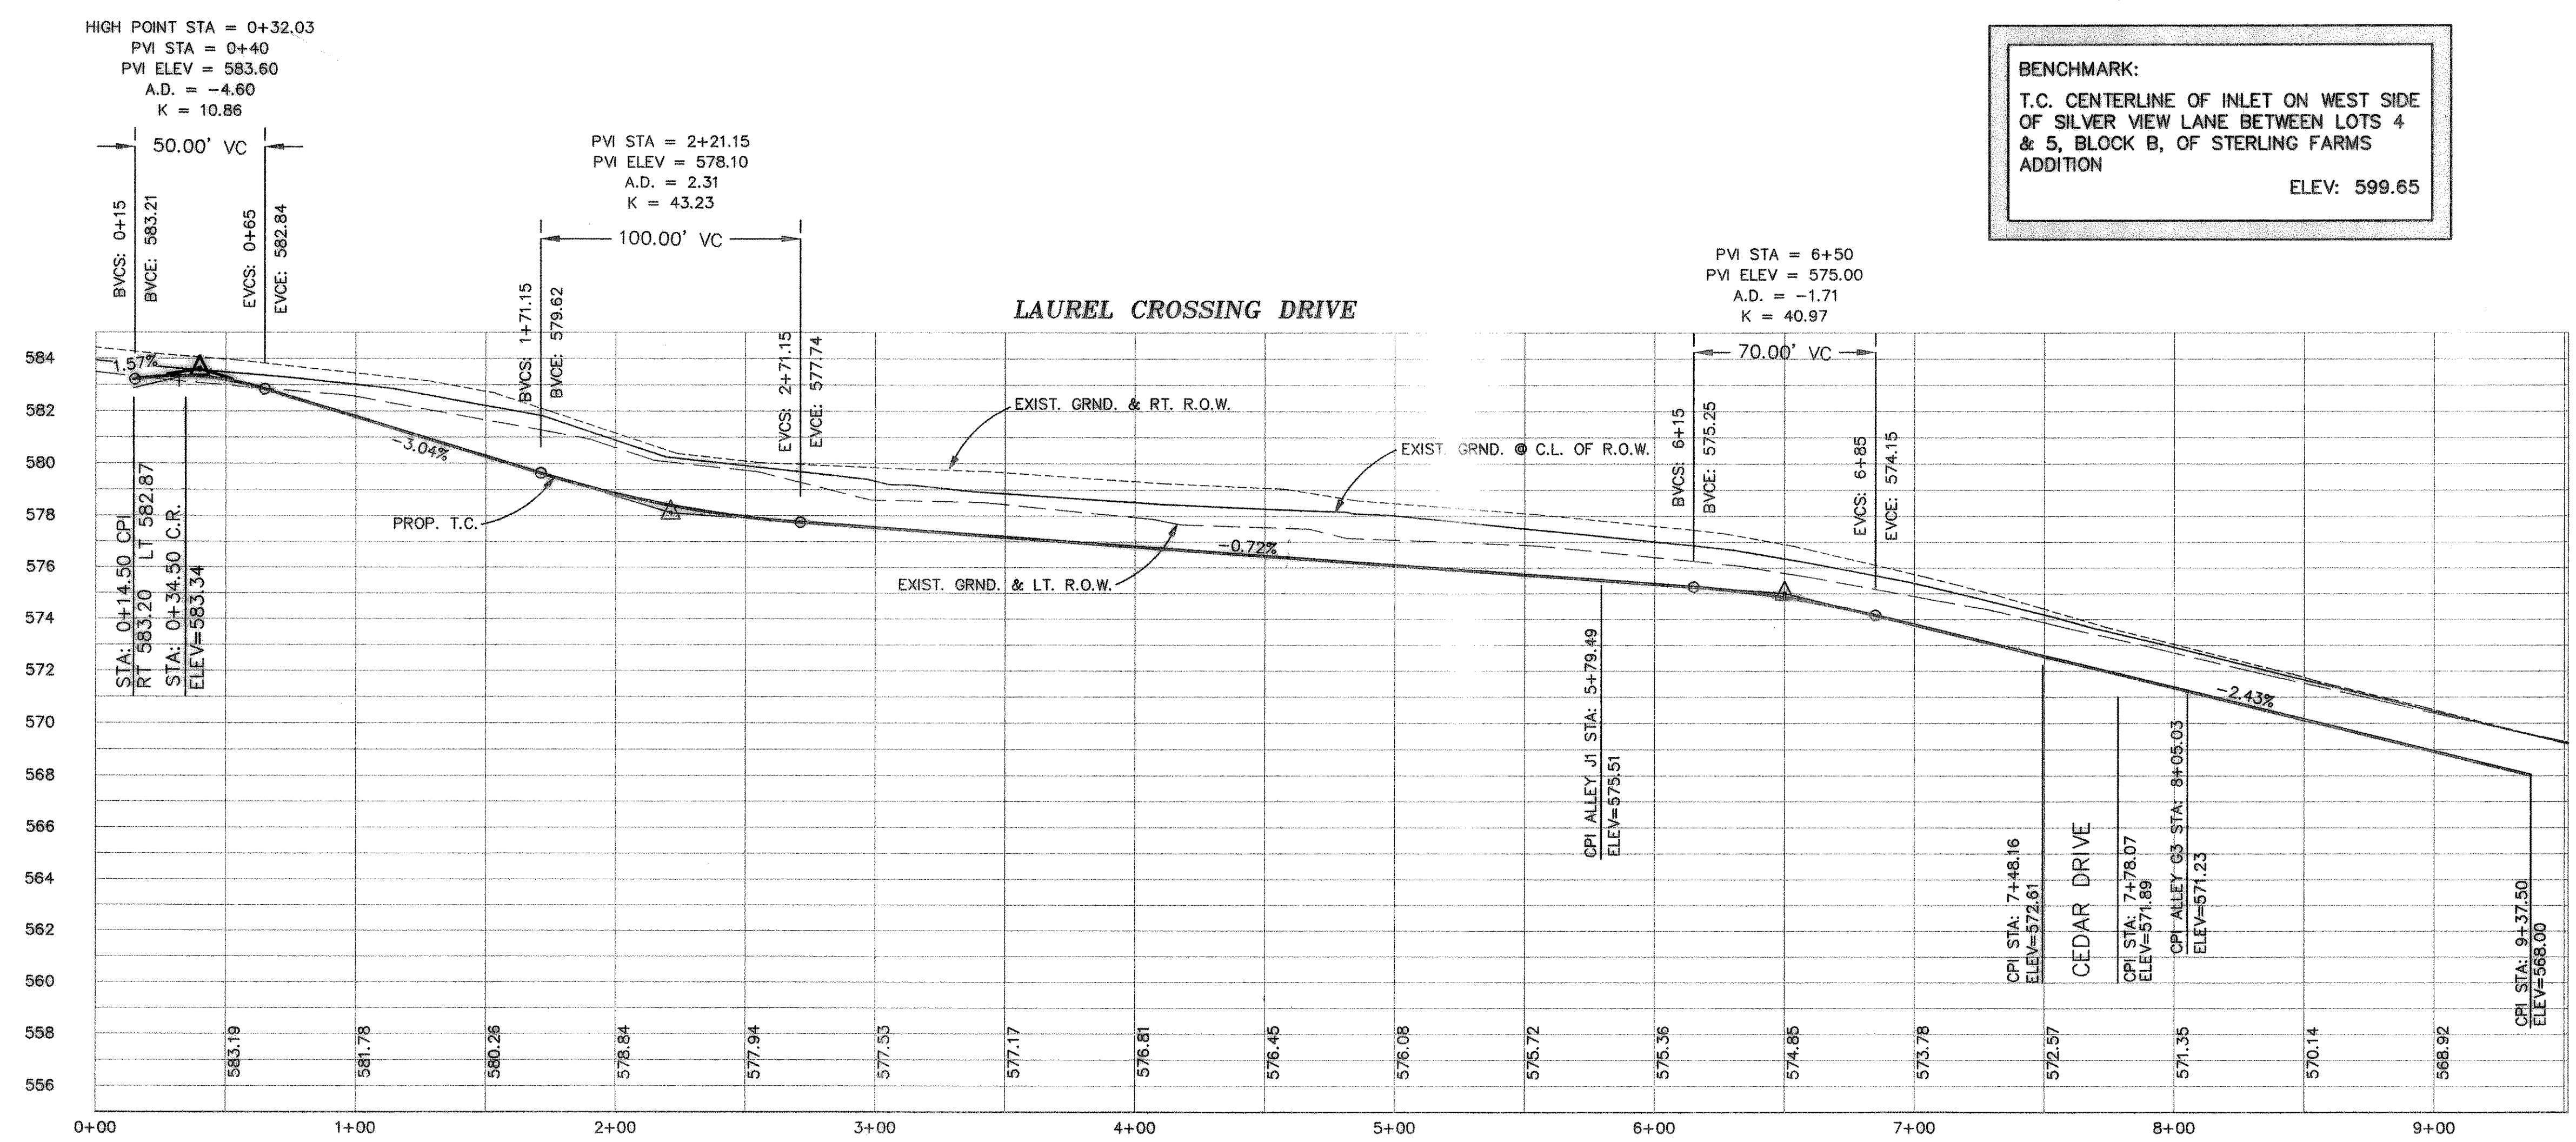

REVISED TO CONFORM TO CONSTRUCTION RECORDS.  
 DATE: 5/21/13