



DOUPHRATE & ASSOCIATES, INC.
 ENGINEERING - PROJECT MANAGEMENT - SURVEYING
 22335 RIDGE RD., # 200 ROCKWALL, TEXAS 75087
 PHONE: (972)771-9004 FAX: (972)771-9005

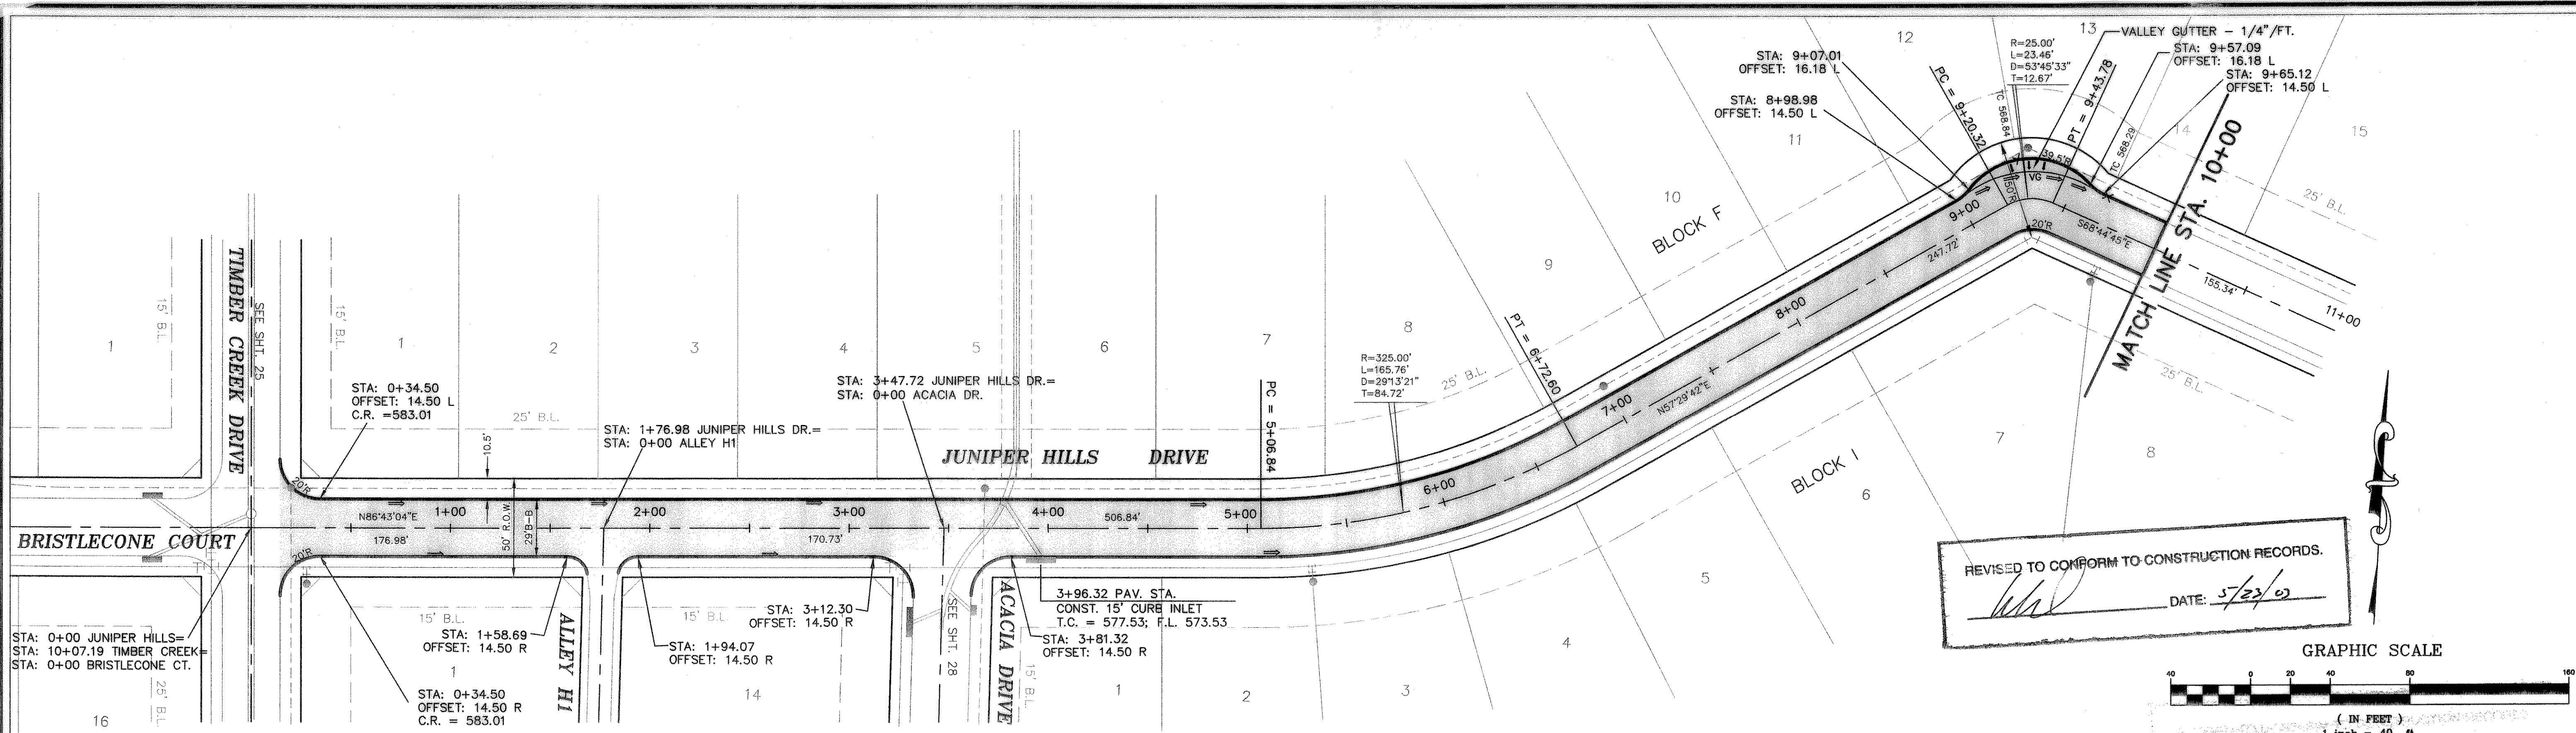


REVISED TO CONFORM TO CONSTRUCTION RECORDS.
 DATE: 5/23/03

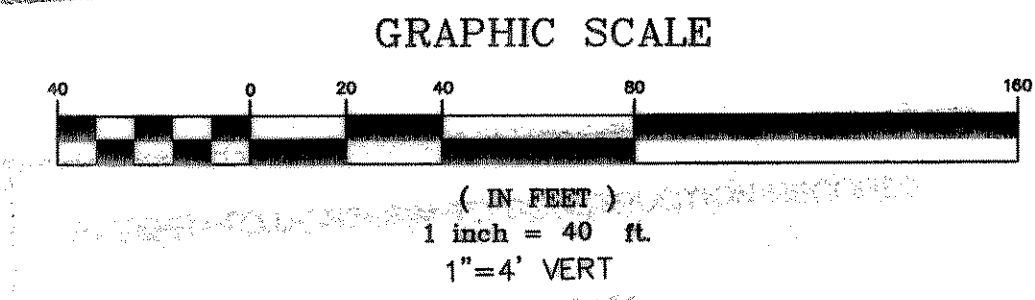

BENCHMARK:
 T.C. CENTERLINE OF INLET ON WEST SIDE OF SILVER VIEW LANE BETWEEN LOTS 4 & 5, BLOCK B, OF STERLING FARMS ADDITION
 ELEV: 599.65

HIGH POINT ELEV = 583.17
 HIGH POINT STA = 0+61.01
 PVI STA = 0+70
 PVI ELEV = 583.38
 A.D. = -2.69
 K = 26.01

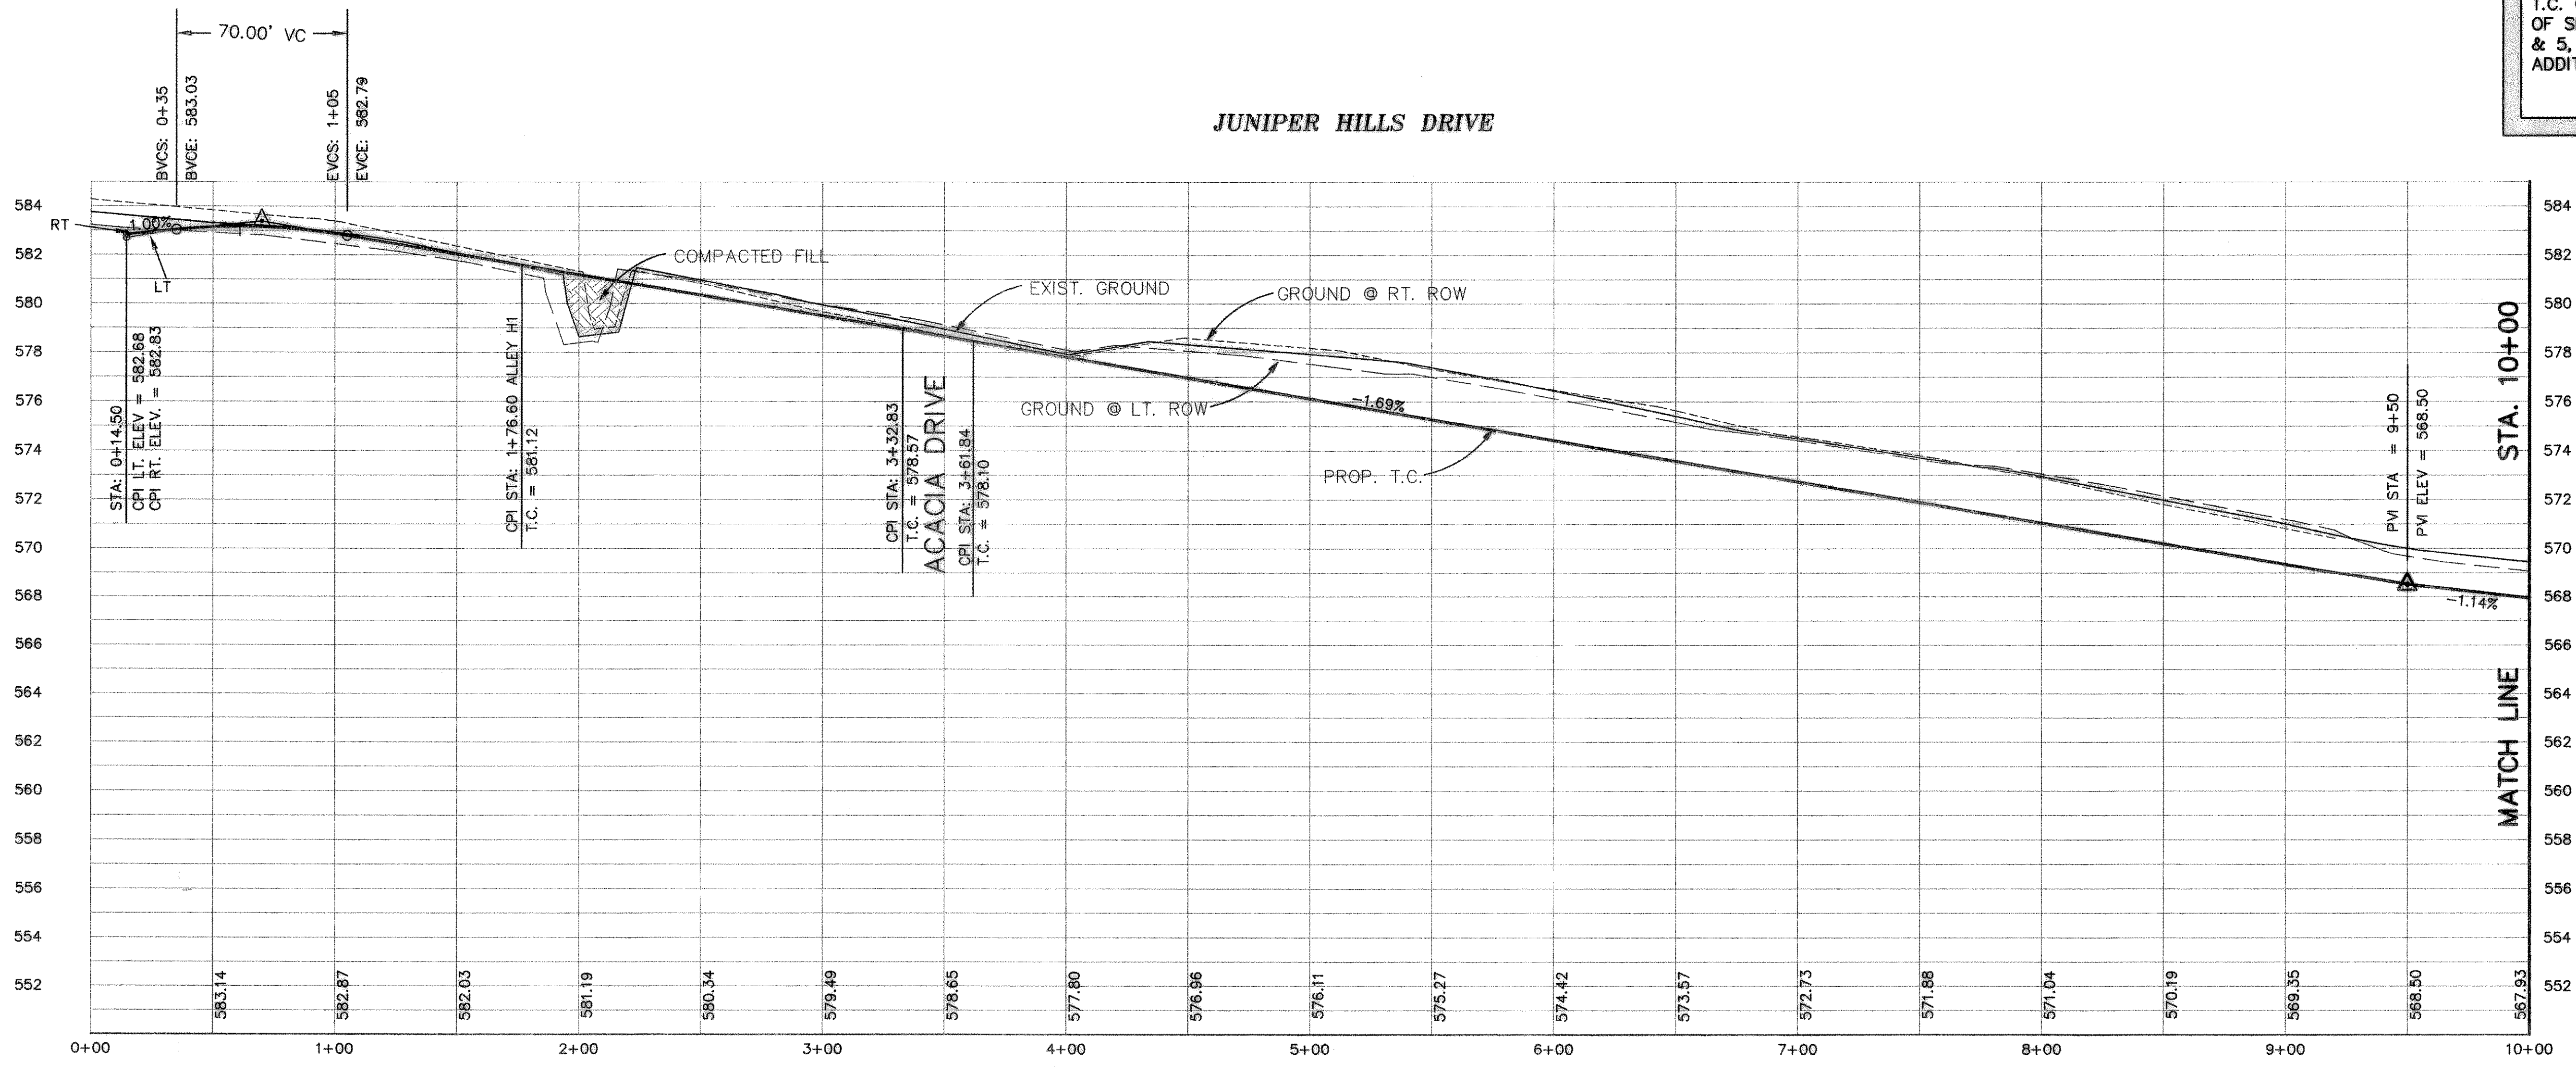

PAVING PLAN & PROFILE
 JUNIPER HILLS DRIVE STA: 0+00 TO 10+00
 TIMBER CREEK ESTATES
 CITY OF ROCKWALL, ROCKWALL COUNTY, TEXAS

REVISION	W.L.D.
CHECKED	K.E.B.
DRAWN	7/15/00
DATE	9913PV11
PROJECT	