


DOUPHRAITE & ASSOCIATES, INC.
 ENGINEERING - PROJECT MANAGEMENT - SURVEYING
 2235 RIDGE RD., # 200 ROCKWALL, TEXAS 75087
 PHONE: (972)771-9004 FAX: (972)771-9005

PLAN AND PROFILE
 ROCHELE ROAD
 TIMBER CREEK ADDITION
 CITY OF ROCKWALL, COUNTY OF ROCKWALL

REV. 12-3-03	LEAVE-OUT AROUND POWER POLE
REVISION	
W.L.D.	CHECKED
K.E.B.	DRAWN
07/00	DATE
9913PV13	PROJECT
33	OF

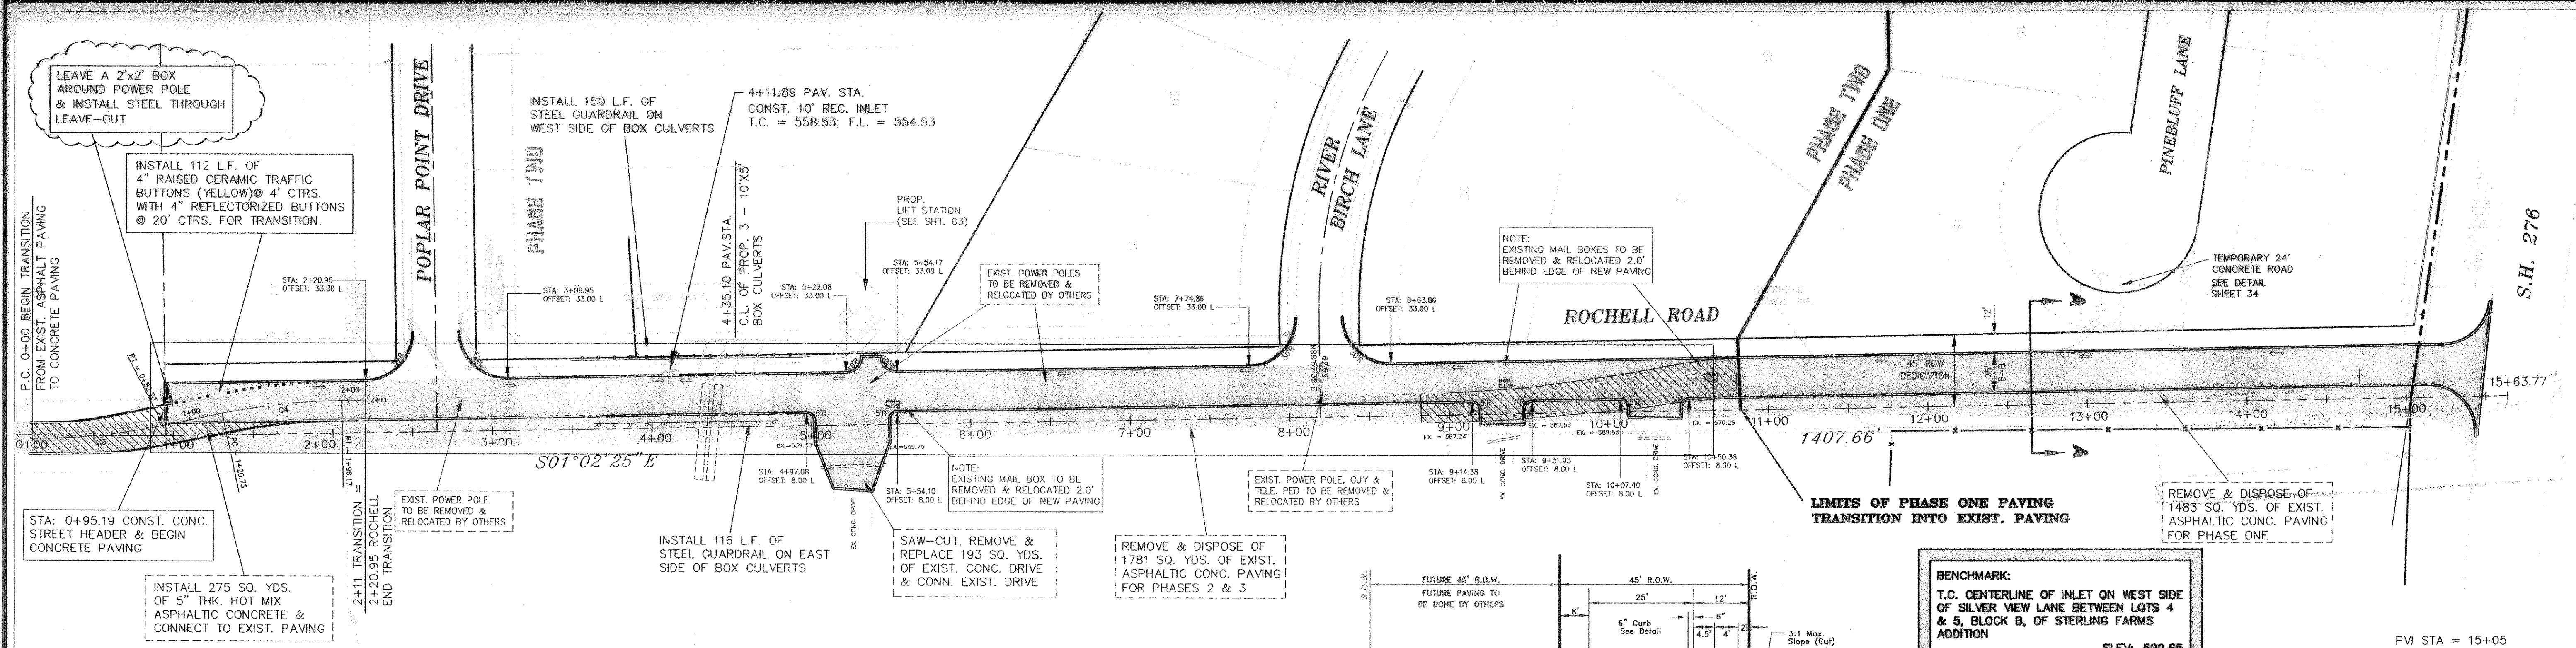

CURVE	DELTA	RADIUS	TANGENT	LENGTH	CHORD
3	11°50'46"	400.00	41.50	82.70	82.55
4	10°48'21"	400.00	37.83	75.44	75.33

