
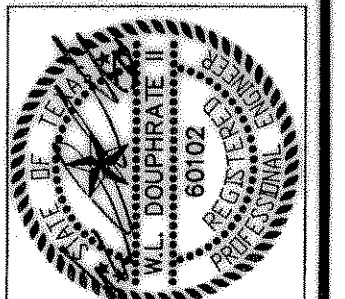


REVISED TO CONFORM TO CONSTRUCTION RECORDS.  
*[Signature]* DATE: 5/23/00

BENCHMARK:  
 T.C. CENTERLINE OF INLET ON WEST SIDE  
 OF SILVER VIEW LANE BETWEEN LOTS 4  
 & 5, BLOCK B, OF STERLING FARMS  
 ADDITION  
 ELEV: 599.65

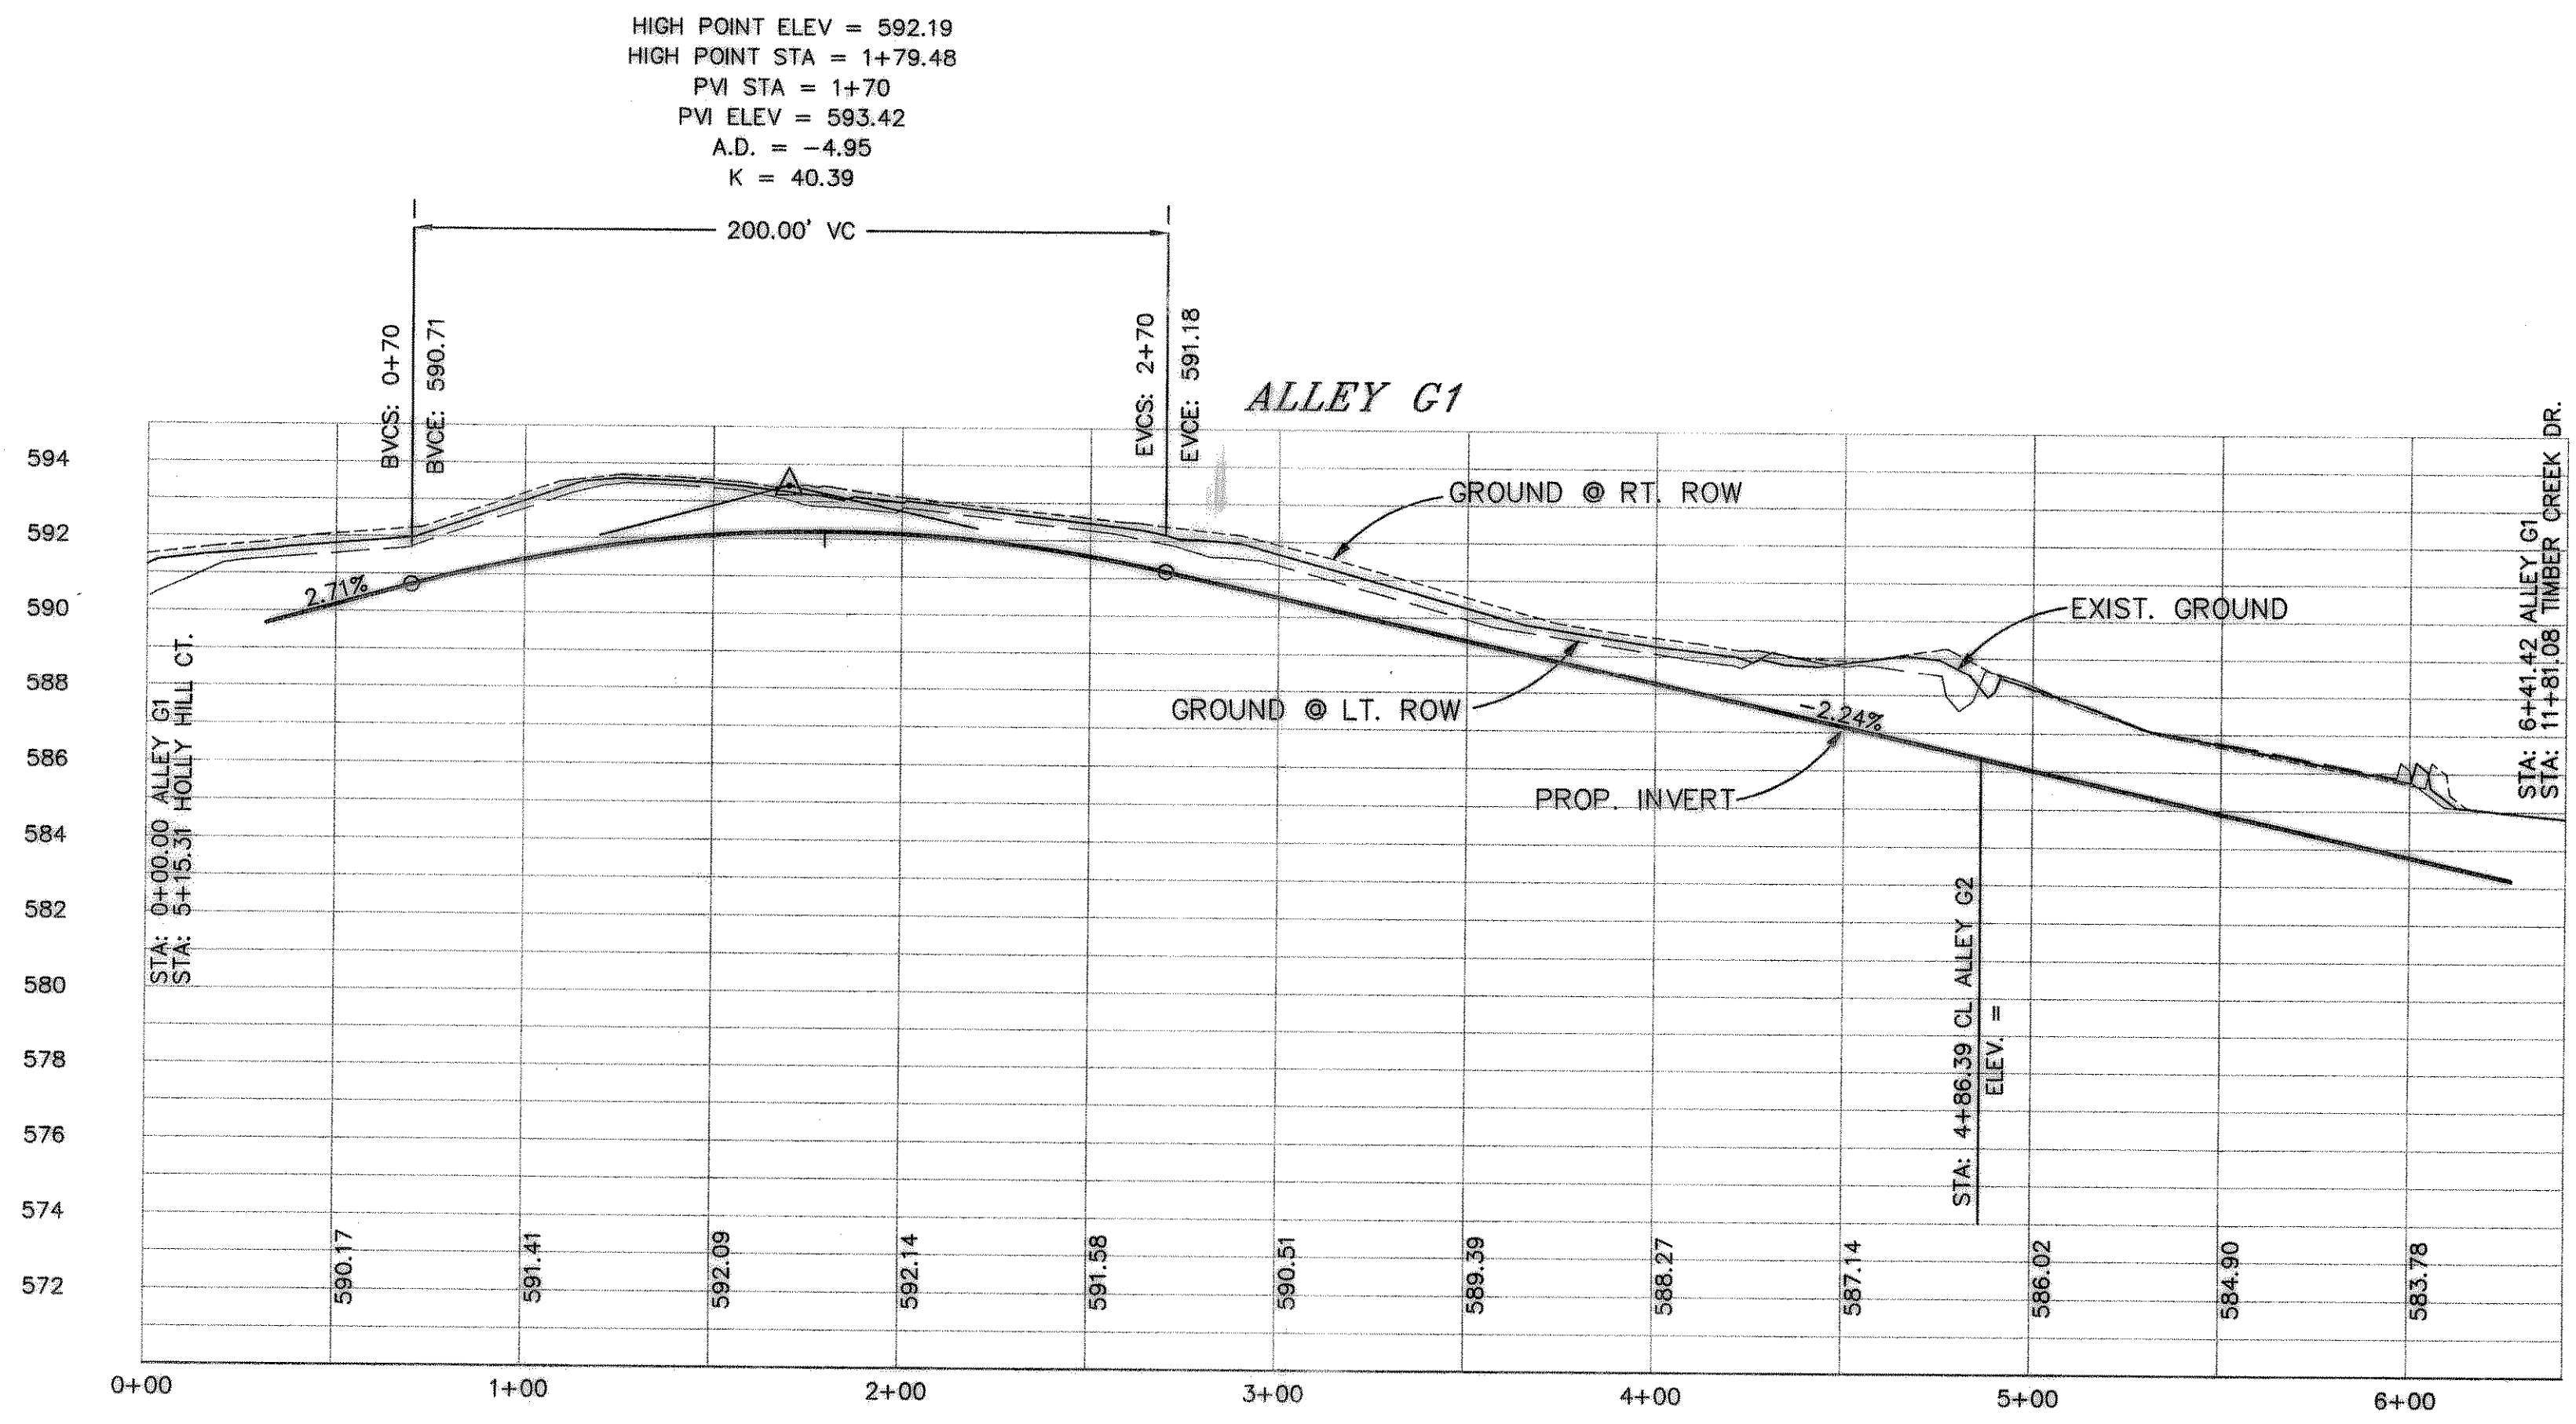

THE SEAL APPEARING ON THIS DOCUMENT WAS AUTHORIZED BY W.L. DOUPHRATE II, TEXAS P.E. NO. 00102 ON 2/9/01

**DOUPHRATE & ASSOCIATES, INC.**  
 ENGINEERING • PROJECT MANAGEMENT • SURVEYING  
 2235 RIDGE RD., # 200 ROCKWALL, TEXAS 75087  
 PHONE: (972)771-9004 FAX: (972)771-9005

**PAVING PLAN & PROFILE**  
**ALLEY G1**  
 TIMBER CREEK ESTATES  
 CITY OF ROCKWALL, ROCKWALL COUNTY, TEXAS

| REVISION            |
|---------------------|
| W.L.D.<br>CHECKED   |
| K.E.B.<br>DRAWN     |
| 7/17/00<br>DATE     |
| 9913PV18<br>PROJECT |