



THE SEAL APPEARING ON THIS DOCUMENT WAS AUTHORIZED BY W.L. DOUPHRATE, NO. 60102 ON 2/5/01

**DOUPHRATE & ASSOCIATES, INC.**  
 ENGINEERING - PROJECT MANAGEMENT - SURVEYING  
 2235 RIDGE RD., # 200 ROCKWALL, TEXAS 75087  
 PHONE: (972)771-9004 FAX: (972)771-9005

**PAVING PLAN & PROFILE**  
**ALLEYS G3 & G4**  
 TIMBER CREEK ESTATES  
 CITY OF ROCKWALL, ROCKWALL COUNTY, TEXAS

REVISION
W.L.D. CHECKED
K.E.B. DRAWN
7/17/00 DATE
9913PV21 PROJECT
41 OF

REV. 10/17/00  
 REV. 01/08/01

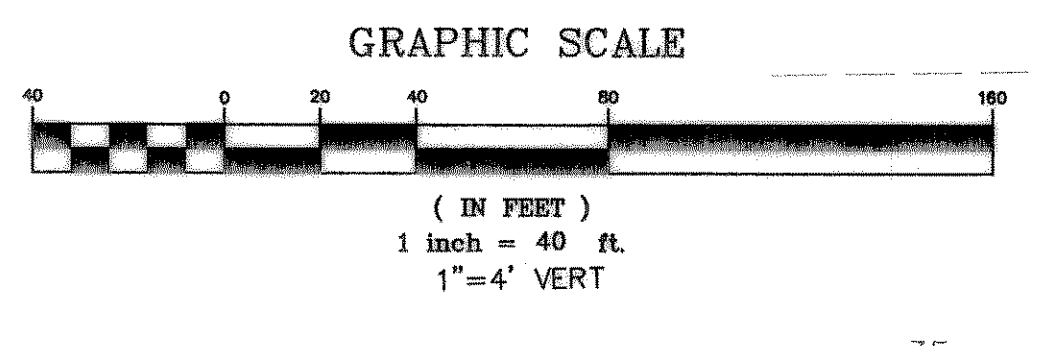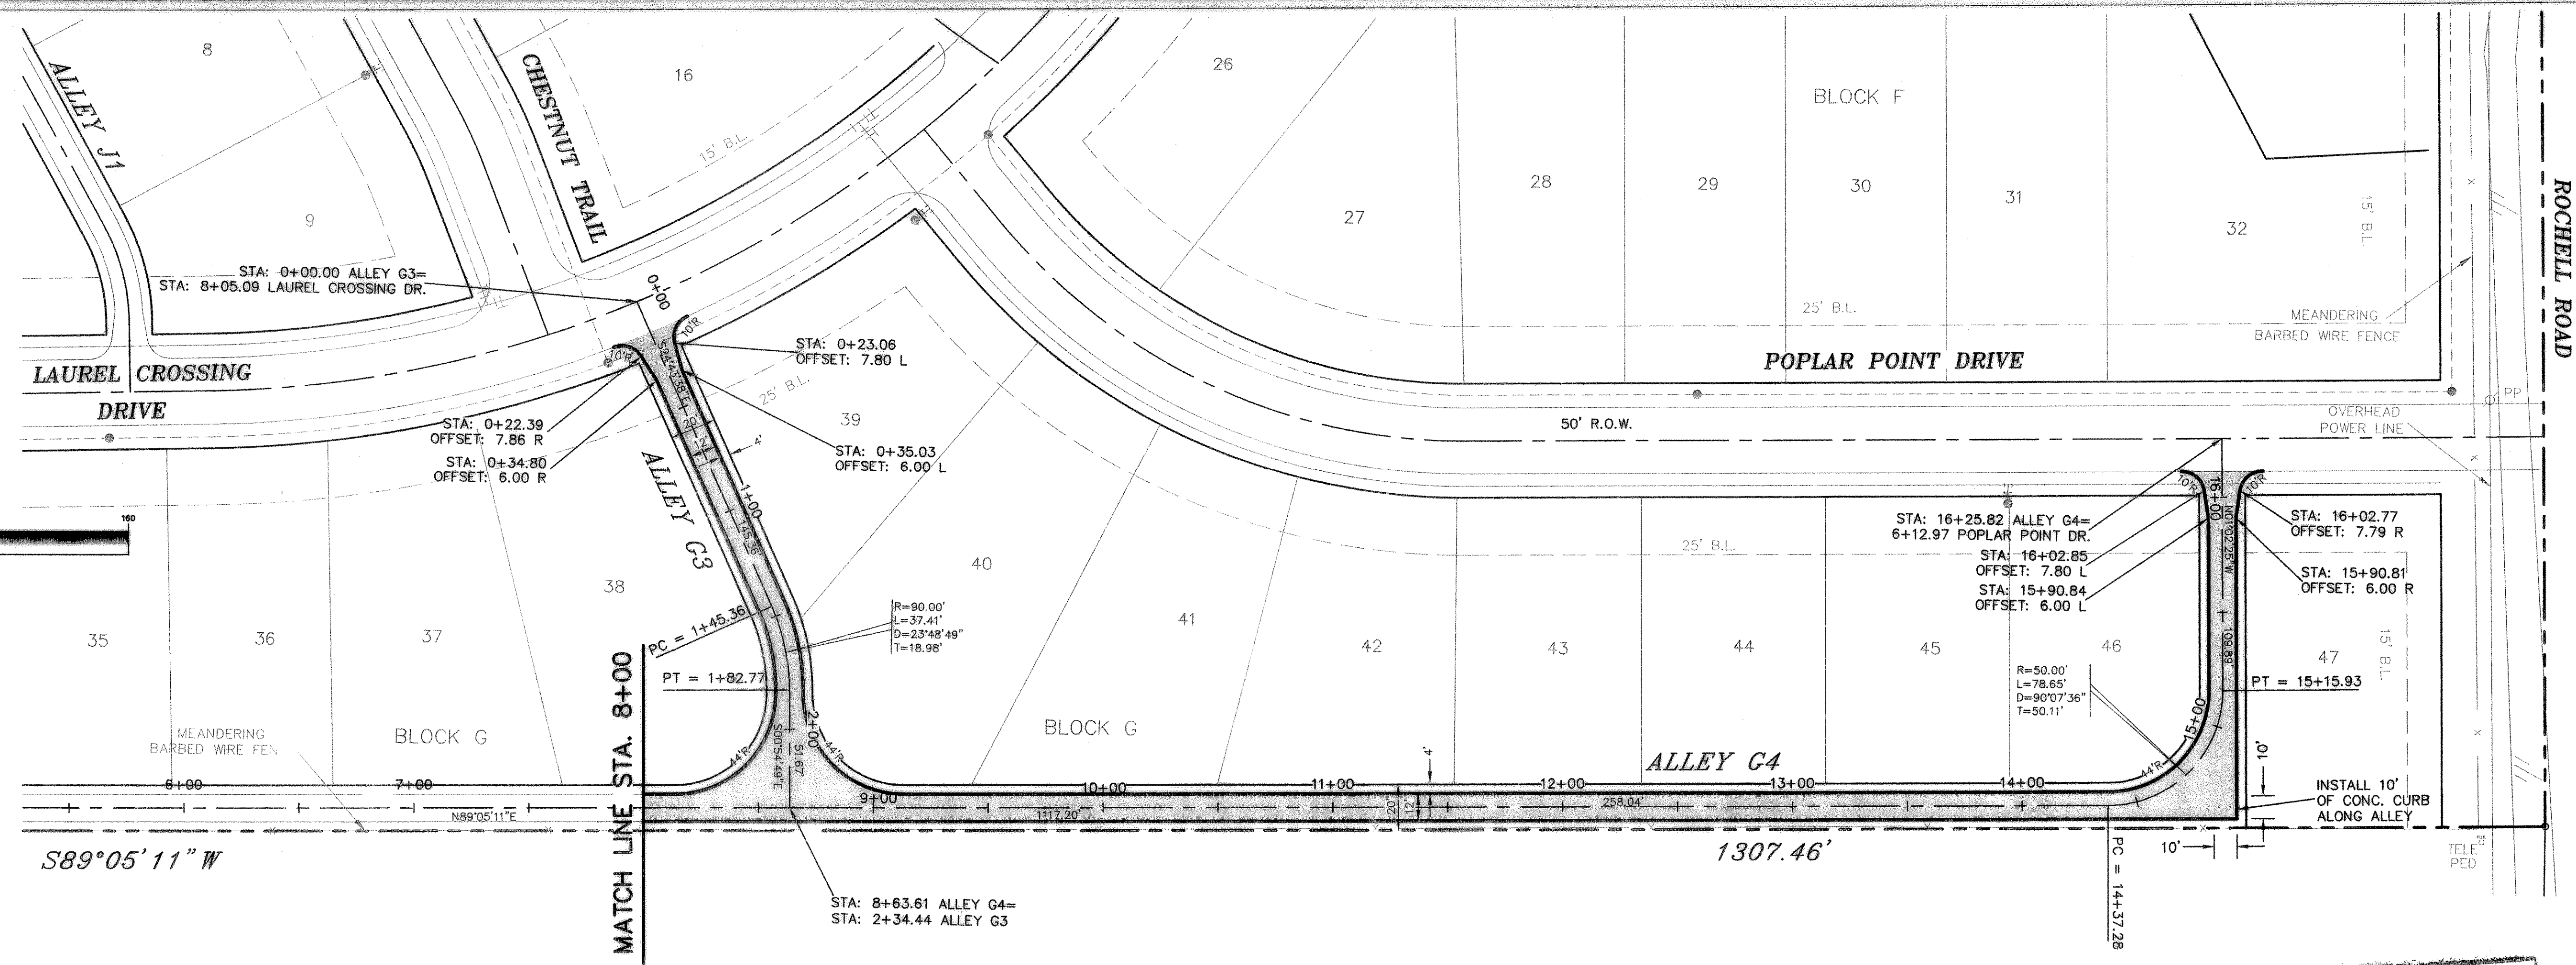

REVISED TO CONFORM TO CONSTRUCTION RECORDS.  
 DATE: 5/23/03

**BENCHMARK:**  
 T.C. CENTERLINE OF INLET ON WEST SIDE OF SILVER VIEW LANE BETWEEN LOTS 4 & 5, BLOCK B, OF STERLING FARMS ADDITION  
 ELEV: 599.65

