


THE SEAL APPEARING ON THIS DOCUMENT WAS AUTHORIZED BY W.L. DOUPHRATE, LICENSE NO. 60102 ON 7/11/11

DOUPHRATE & ASSOCIATES, INC.
 ENGINEERING • PROJECT MANAGEMENT • SURVEYING
 2235 RIDGE RD., # 200 ROCKWALL, TEXAS 75087
 PHONE: (972)771-9004 FAX: (972)771-9005

HIGH POINT ELEV = 568.04
 HIGH POINT STA = 0+24.18
 PVI STA = 0+40
 PVI ELEV = 568.10
 A.D. = -1.70
 K = 29.49

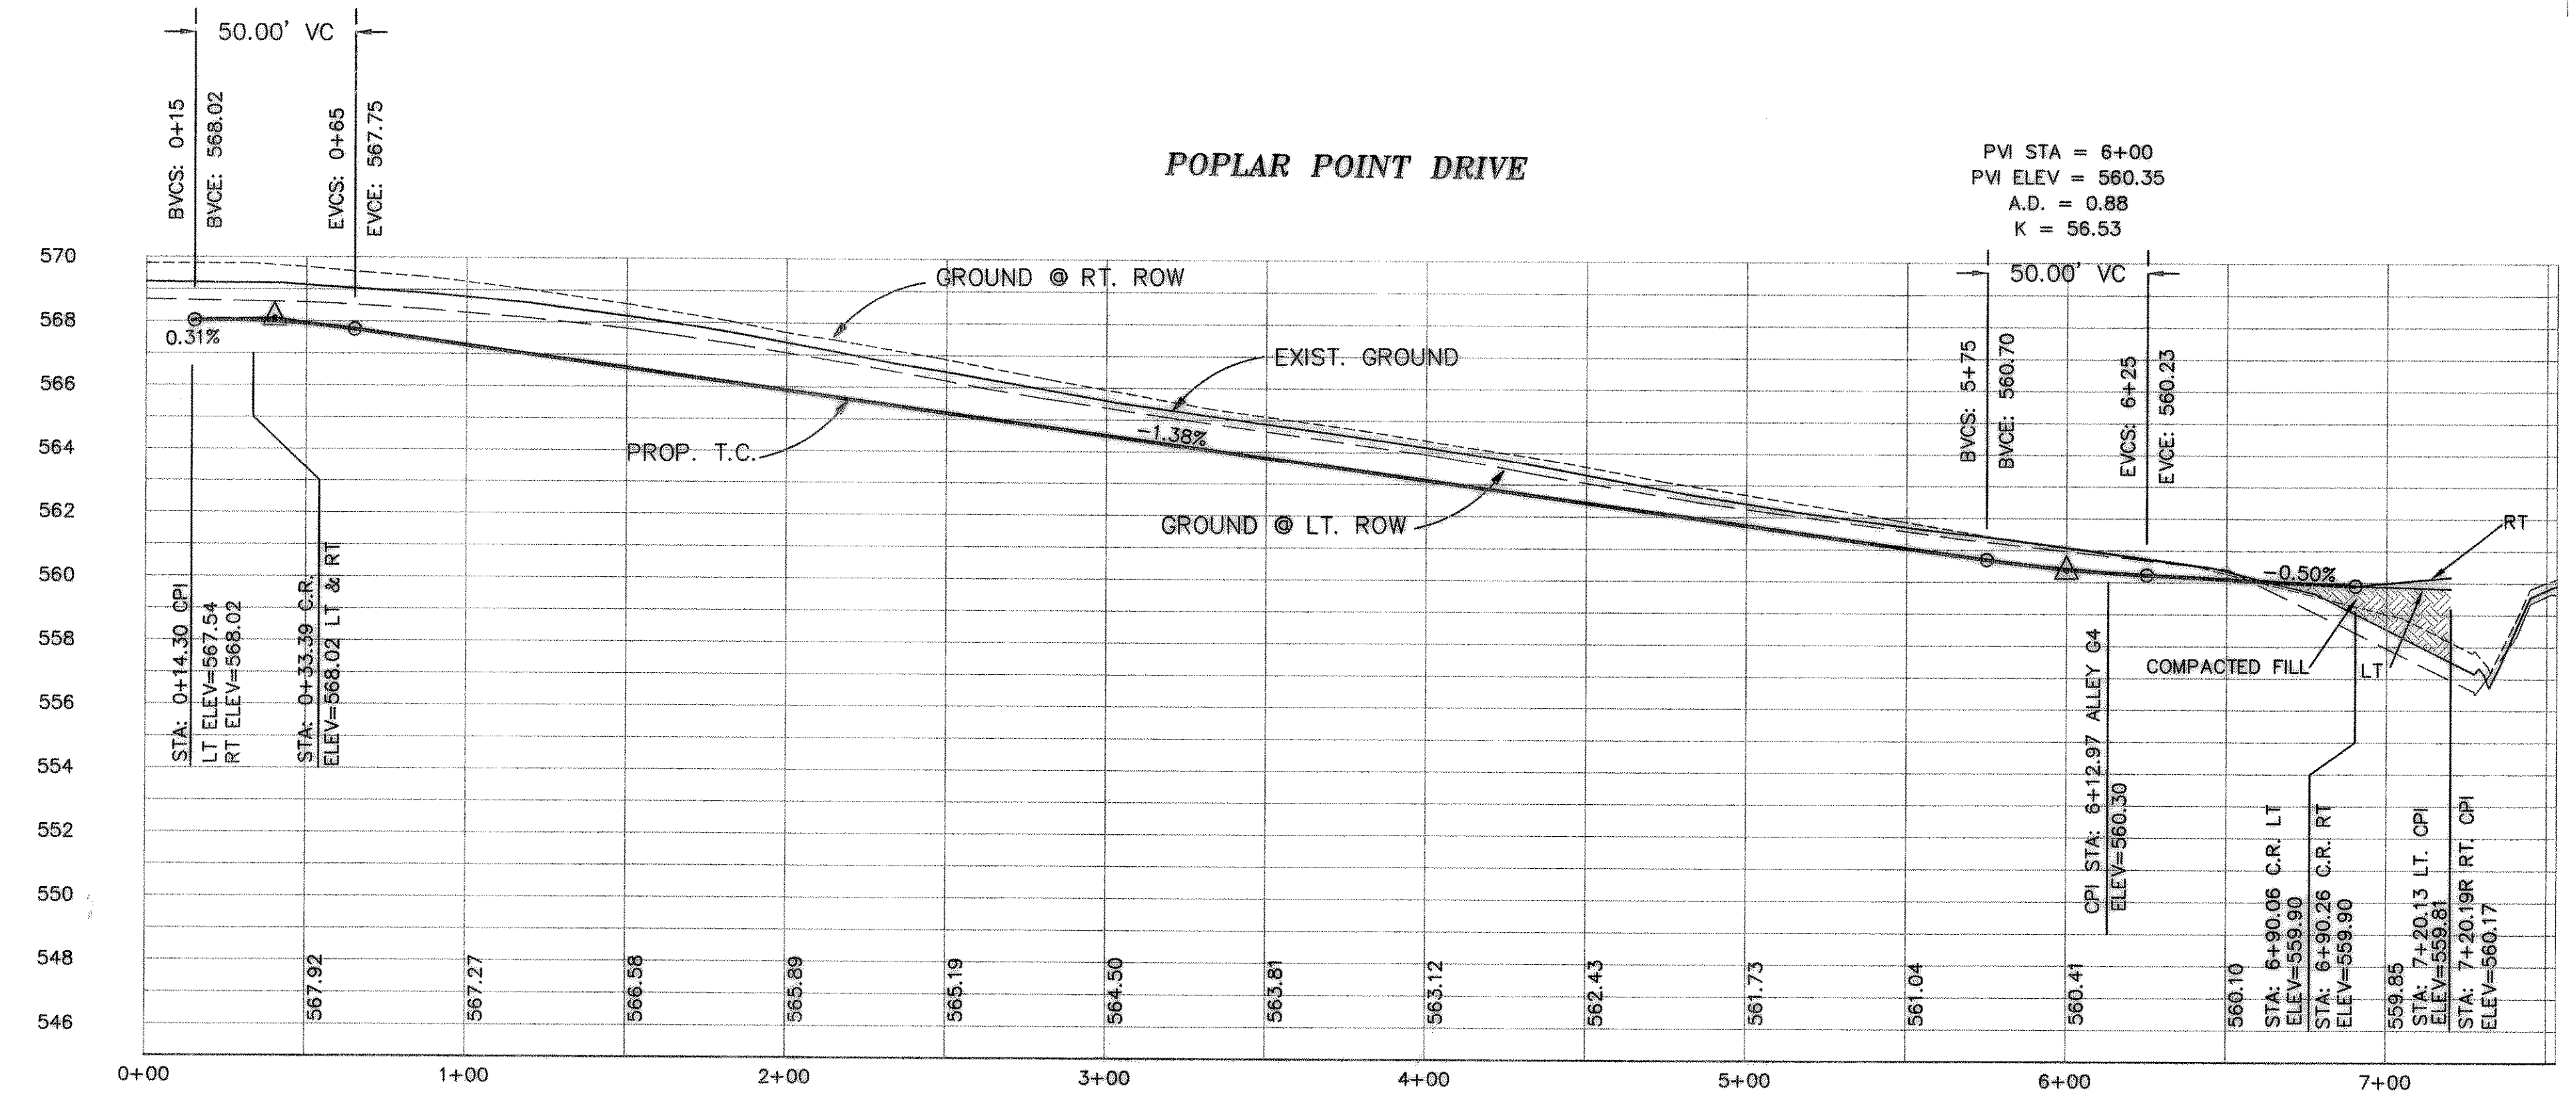

PVI STA = 6+00
 PVI ELEV = 560.35
 A.D. = 0.88
 K = 56.53

REVISED TO CONFORM TO CONSTRUCTION RECORDS.
WLD
 DATE: 5/23/02

BENCHMARK:
 T.C. CENTERLINE OF INLET ON WEST SIDE OF SILVER VIEW LANE BETWEEN LOTS 4 & 5, BLOCK B, OF STERLING FARMS ADDITION
 ELEV: 599.65

PLAN AND PROFILE
 POPLAR POINT DRIVE
 TIMBER CREEK ESTATES
 CITY OF ROCKWALL, COUNTY OF ROCKWALL

REVISION	
CHECKED	W.L.D.
DRAWN	K.E.B.
DATE	7/25/00
PROJECT	9913PV25
	44 OF