



DOUPHRATE & ASSOCIATES, INC.
 ENGINEERING • PROJECT MANAGEMENT • SURVEYING
 2235 RIDGE RD., # 200 ROCKWALL, TEXAS 75087
 PHONE: (972)771-9004 FAX: (972)771-9005

PLAN AND PROFILE
 ALLEY H1
 TIMBER CREEK ESTATES
 CITY OF ROCKWALL, COUNTY OF ROCKWALL

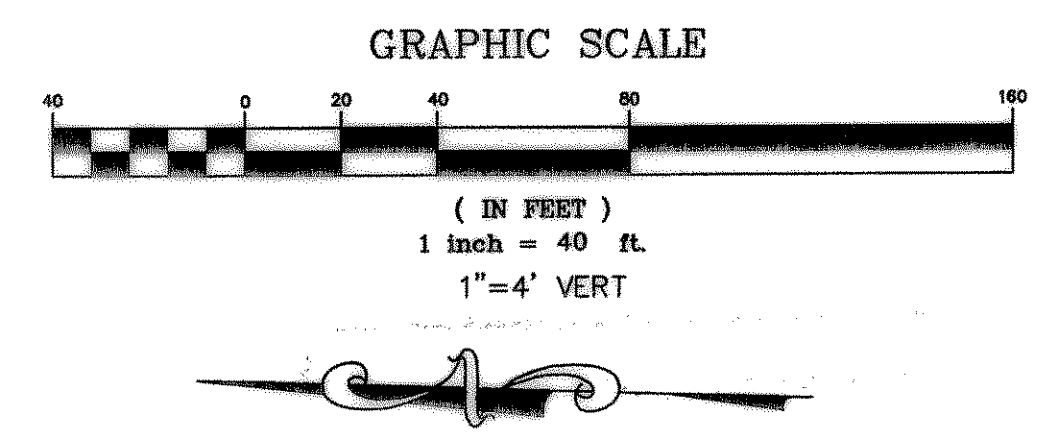


REVISED TO CONFORM TO CONSTRUCTION RECORDS.
 DATE: 5/27/02

BENCHMARK:
 T.C. CENTERLINE OF INLET ON WEST SIDE
 OF SILVER VIEW LANE BETWEEN LOTS 4
 & 5, BLOCK B, OF STERLING FARMS
 ADDITION
 ELEV: 599.65

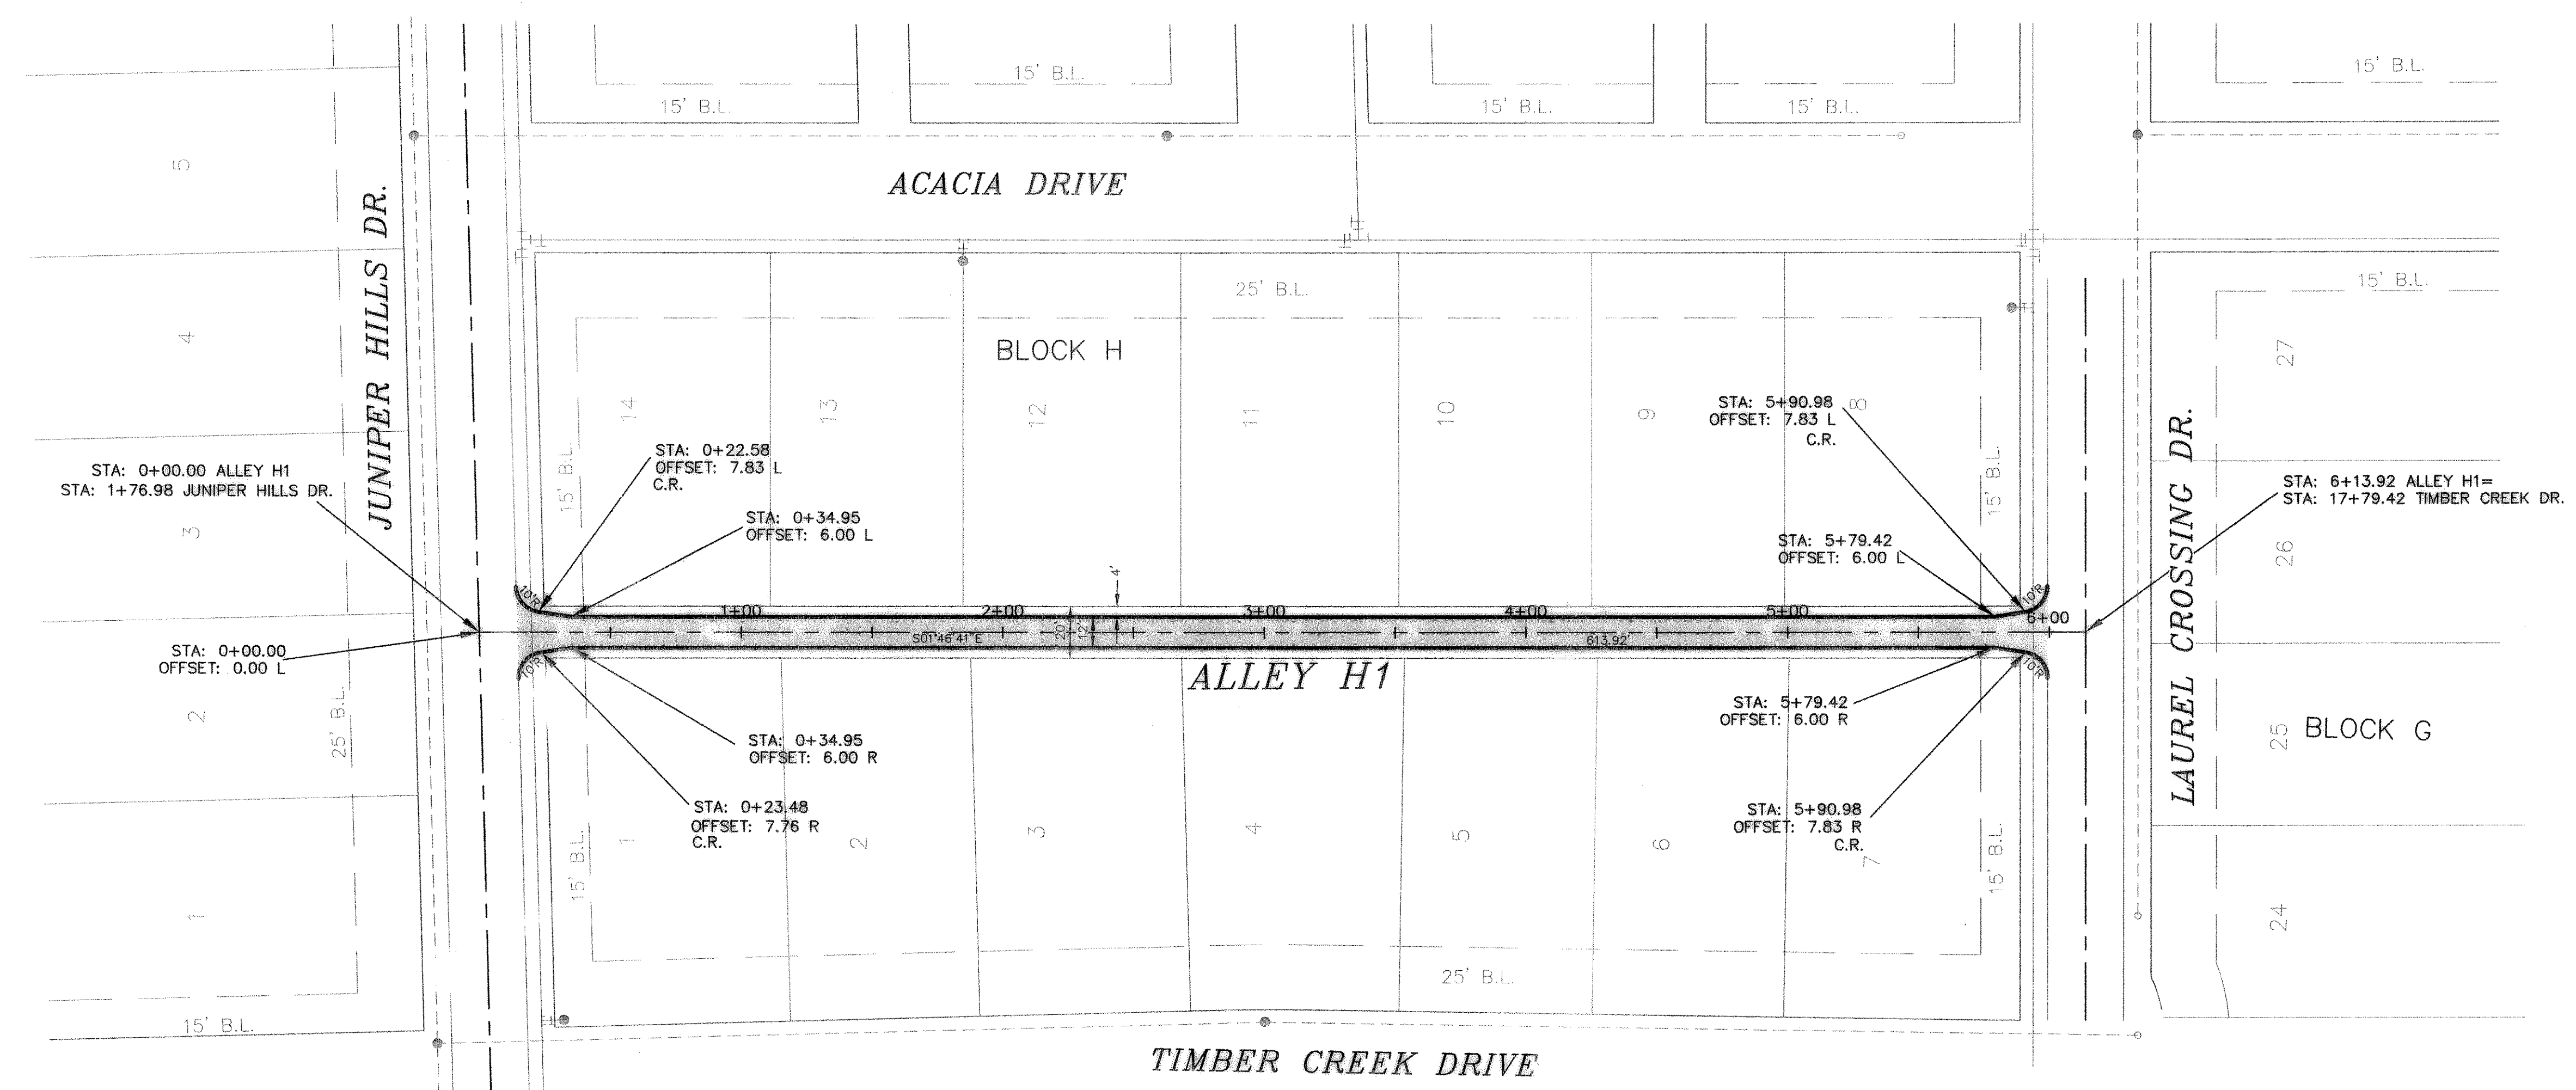

HIGH POINT ELEV = 584.40
 HIGH POINT STA = 5+69.20
 PVI STA = 5+74
 PVI ELEV = 584.50
 A.D. = -1.72
 K = 29.13

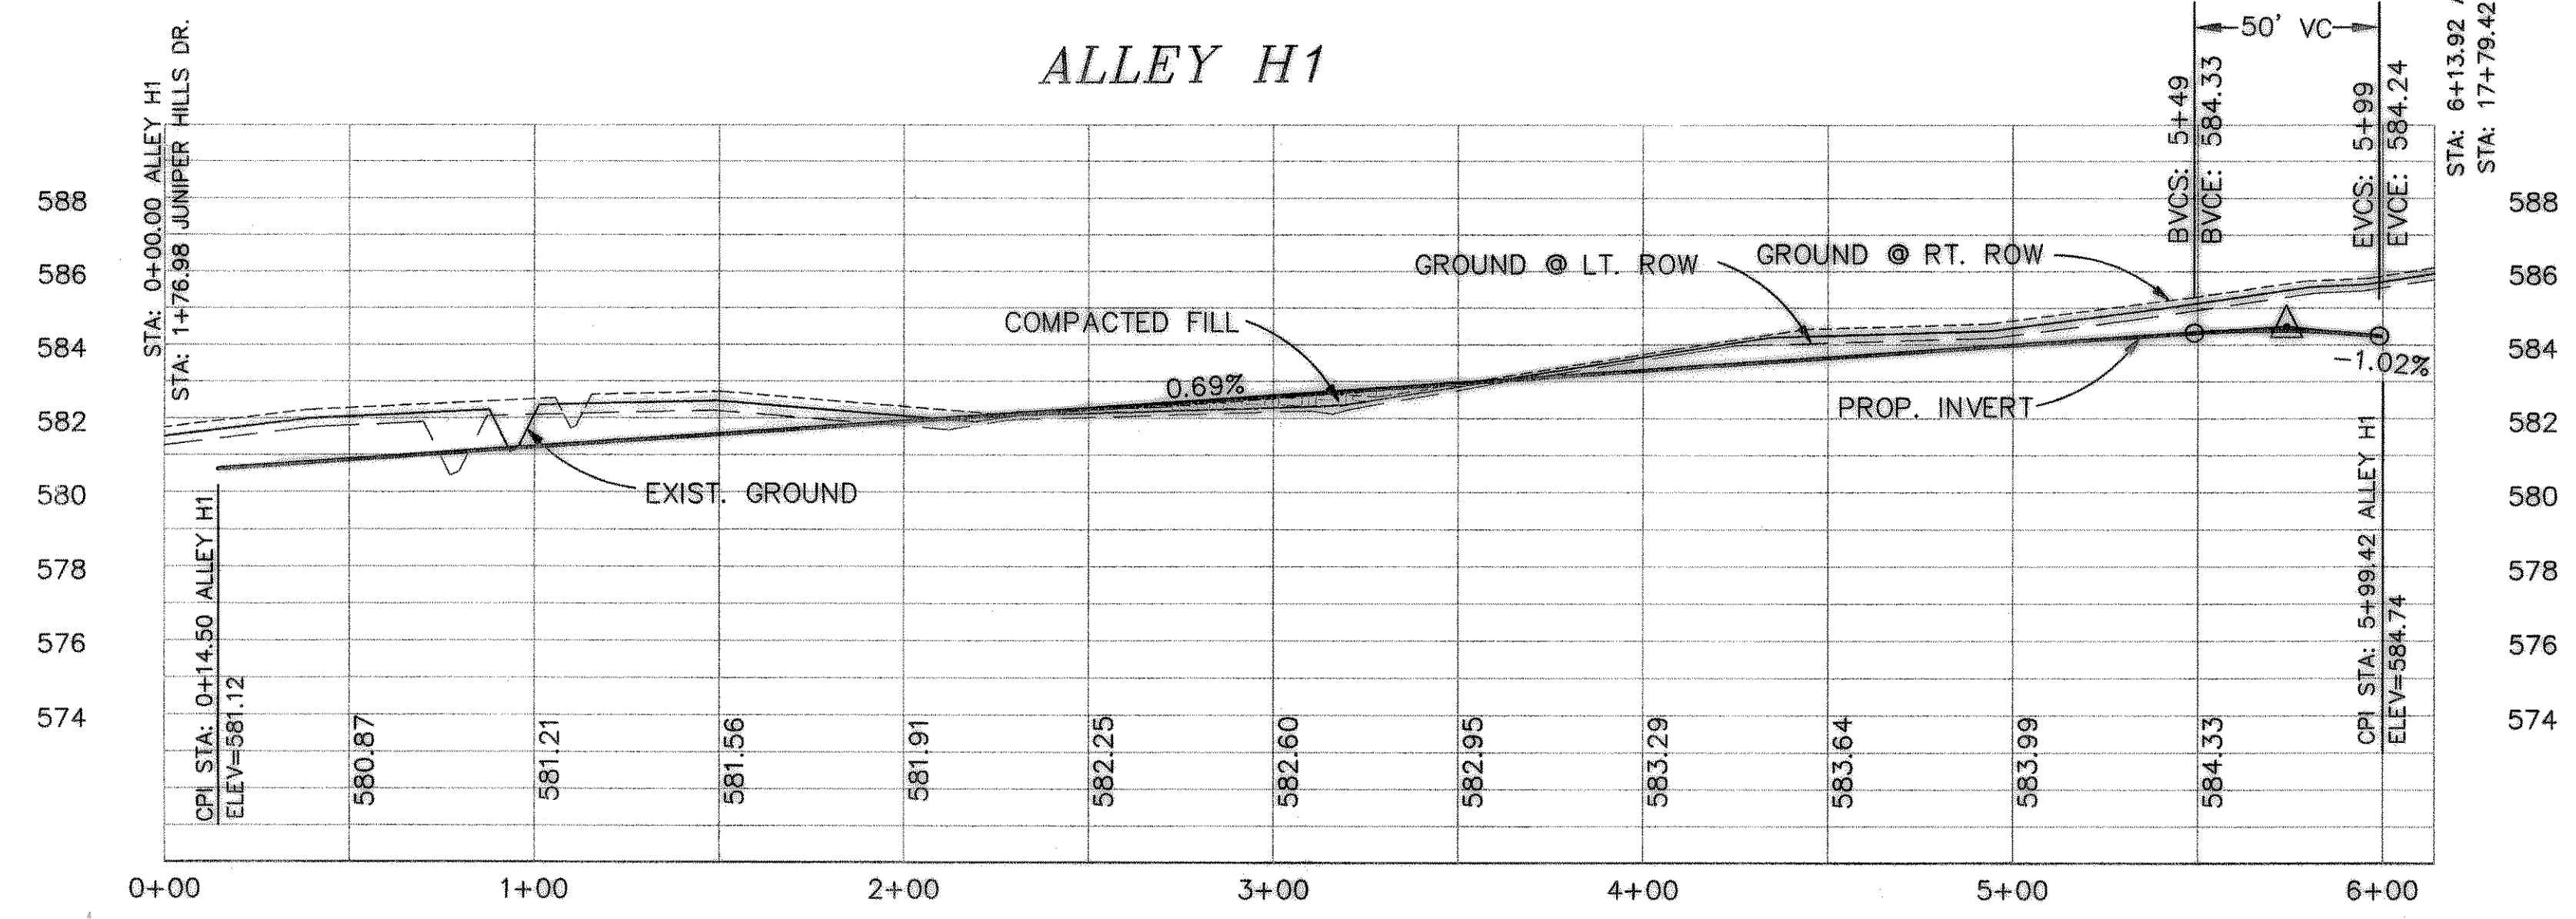

REVISION	W.L.D.
CHECKED	K.E.B.
DRAWN	07/25/00
DATE	9913PV26
PROJECT	45 OF