
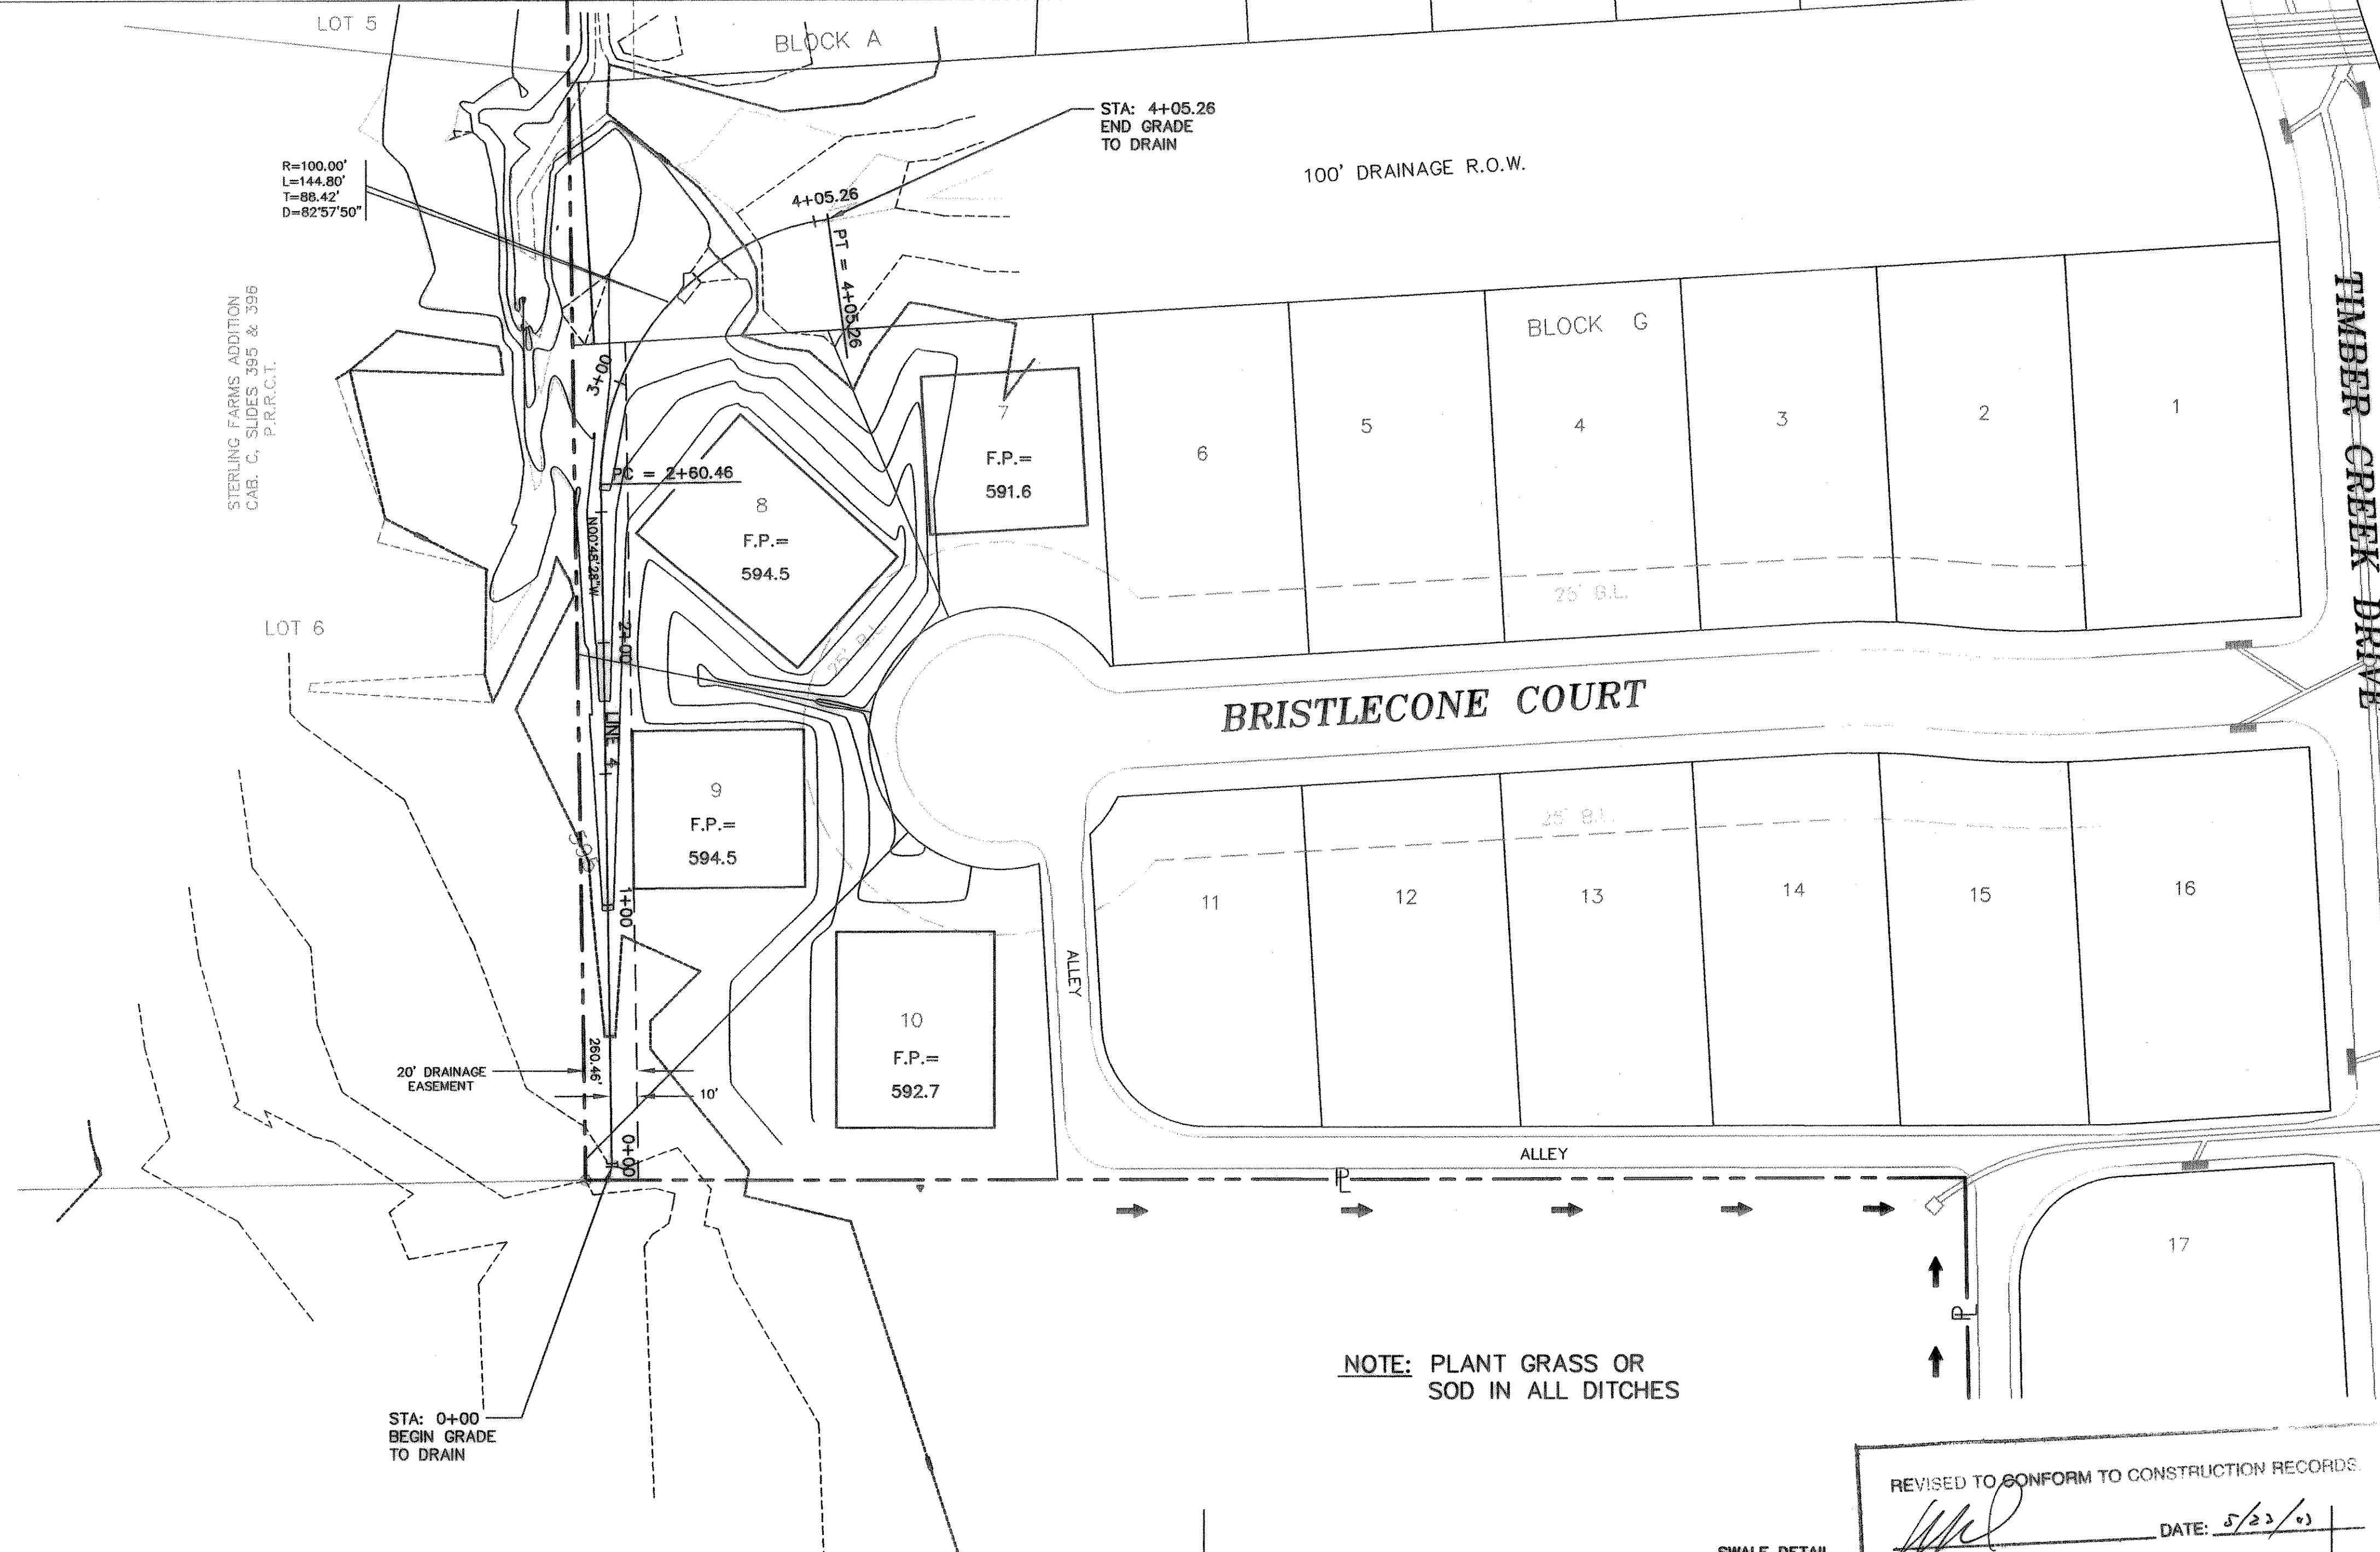


THE SEAL APPEARING ON THIS DOCUMENT WAS AUTHORIZED BY W.L. DOUPHRAE II TEXAS P.E. NO. 90102 ON 6/11/02




DOUPHRAE & ASSOCIATES, INC.
 ENGINEERING - PROJECT MANAGEMENT - SURVEYING
 2285 RIDGE RD., # 200 ROCKWALL, TEXAS 75087
 PHONE: (972)771-9004 FAX: (972)771-9005

GRADE TO DRAIN
 LINE 4
 TIMBER CREEK ESTATES
 CITY OF ROCKWALL, COUNTY OF ROCKWALL

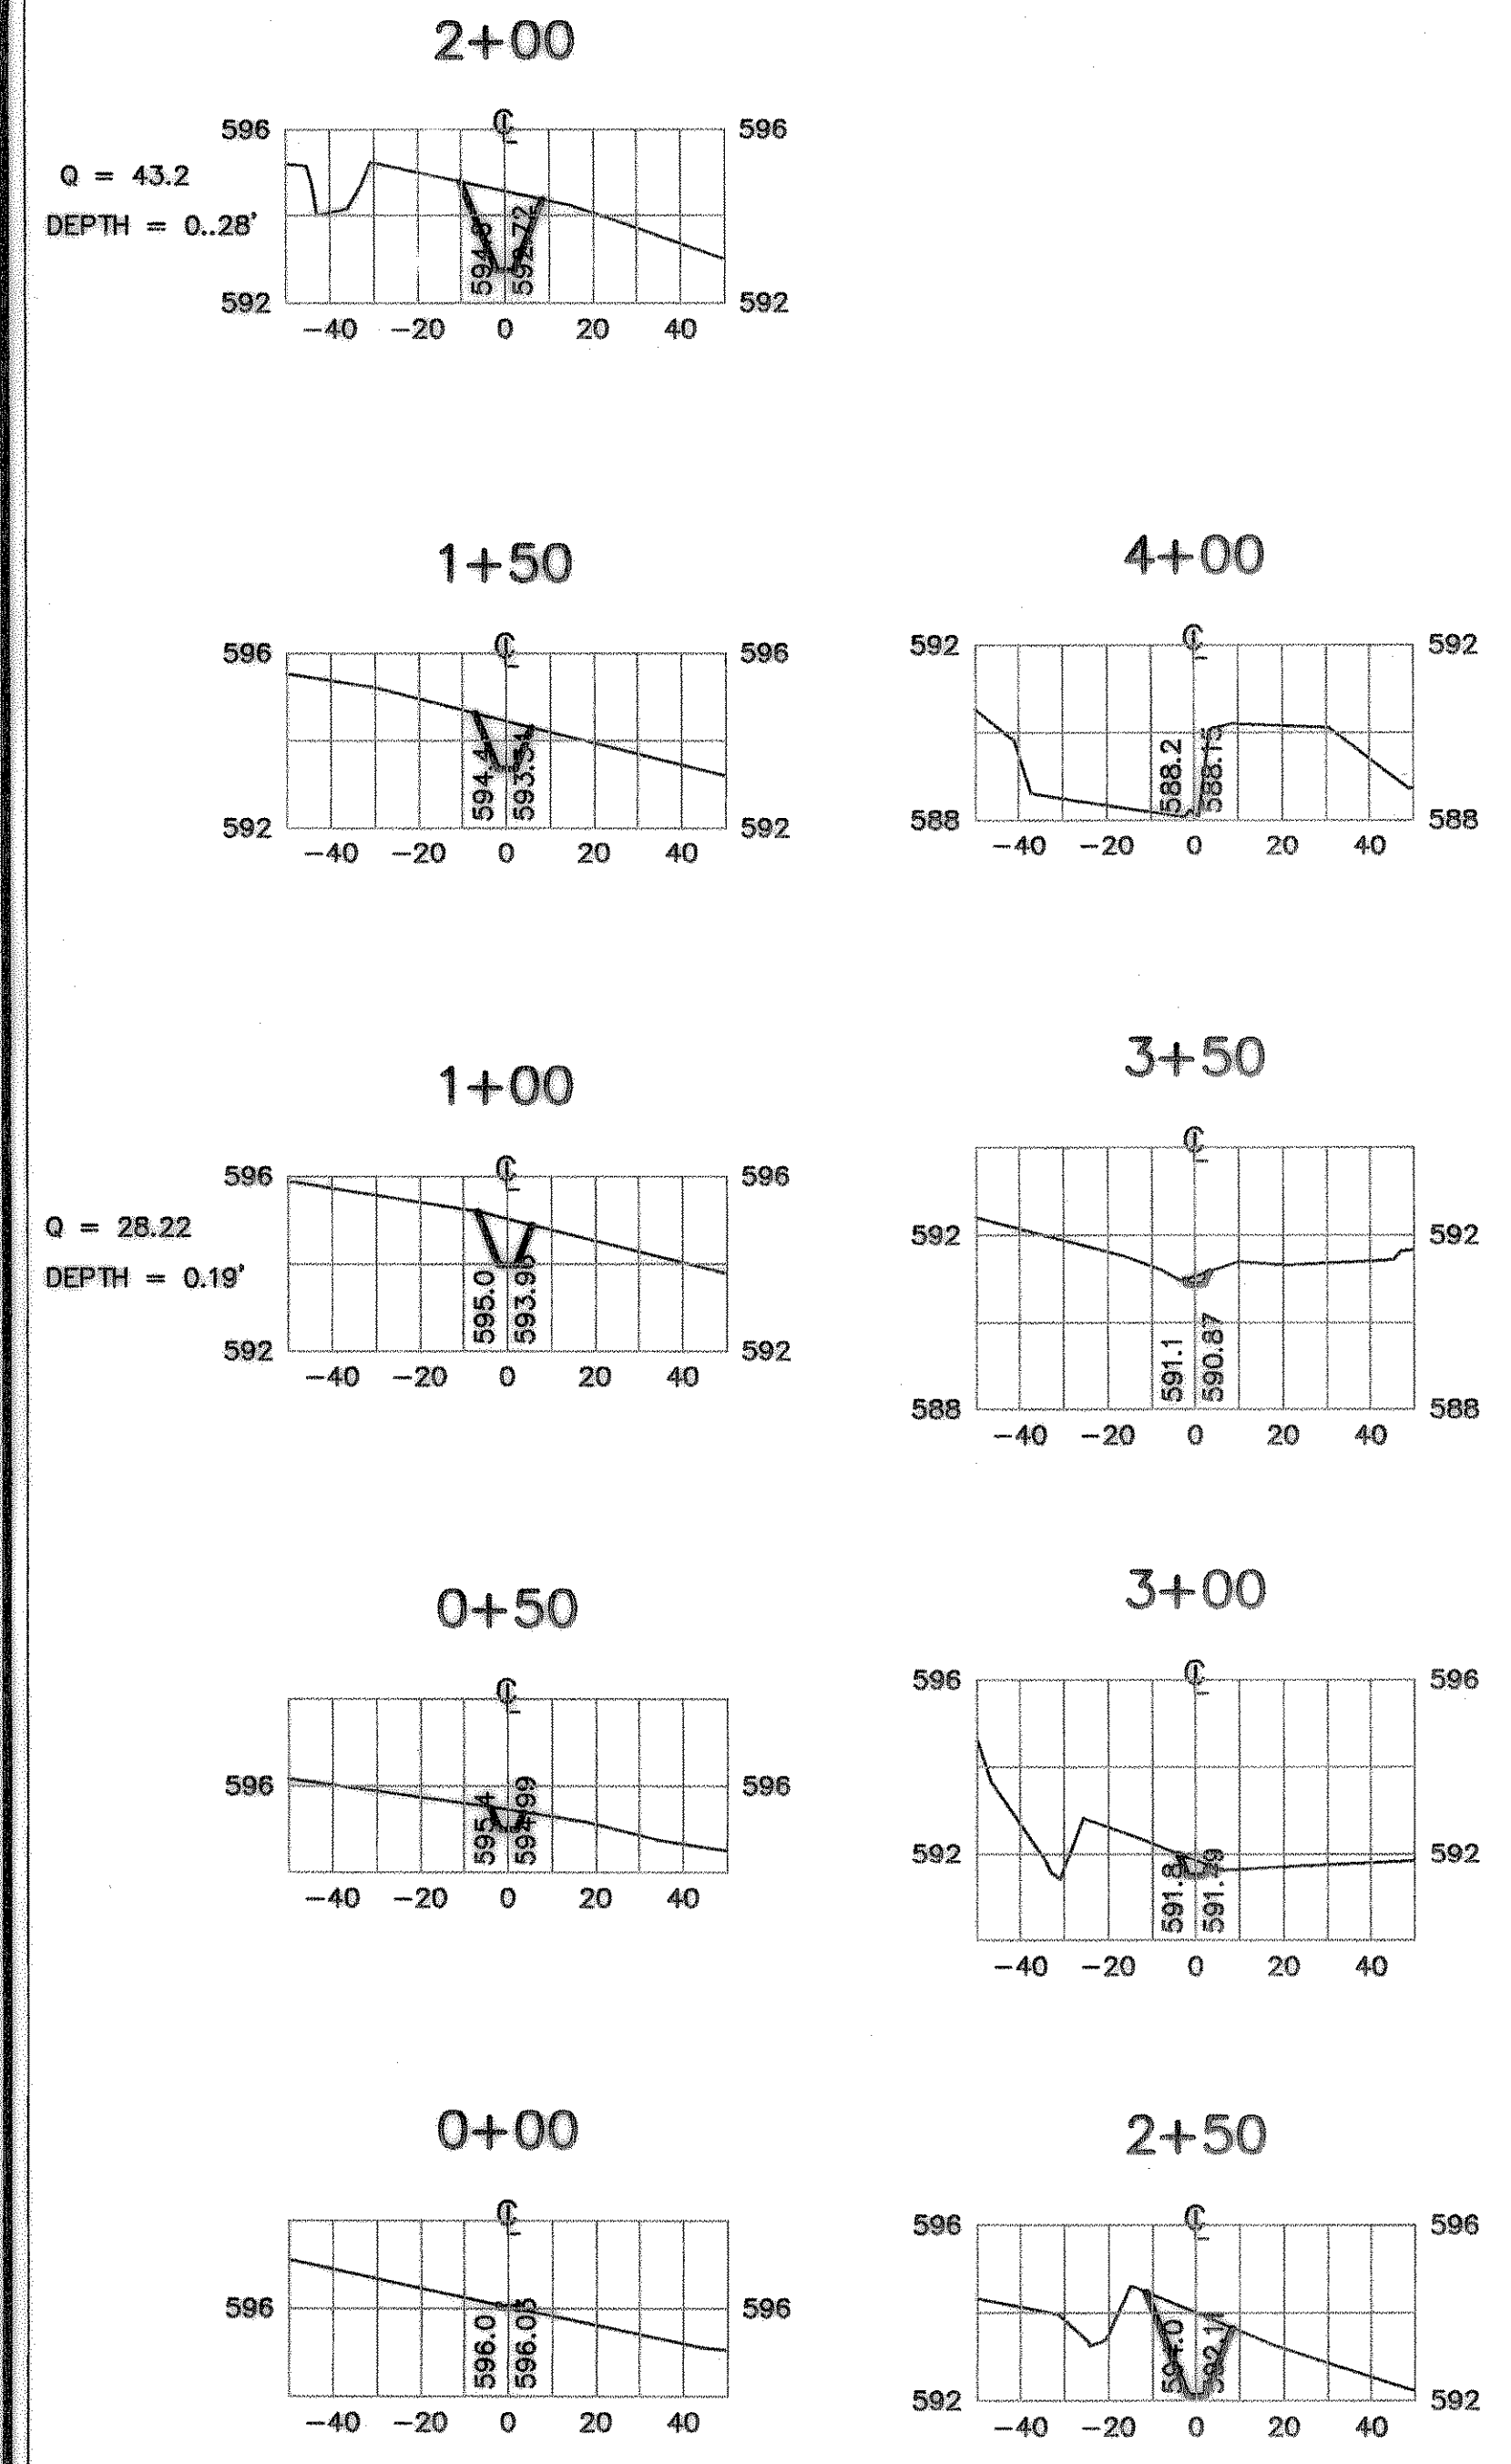

NOTE: PLANT GRASS OR SOD IN ALL DITCHES

REVISED TO CONFORM TO CONSTRUCTION RECORDS.
 DATE: 5/23/02

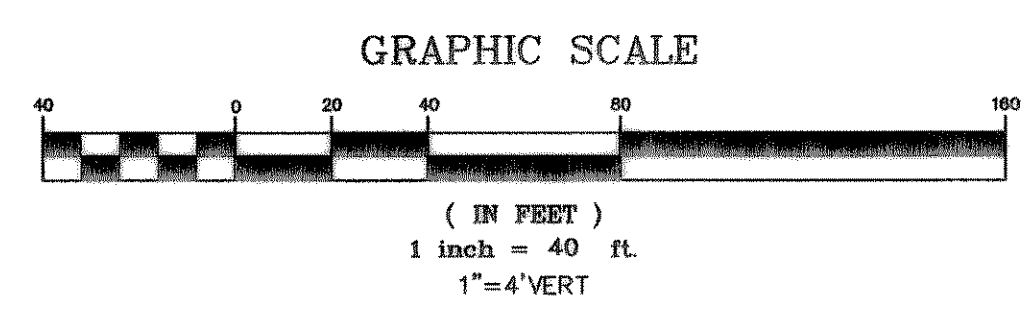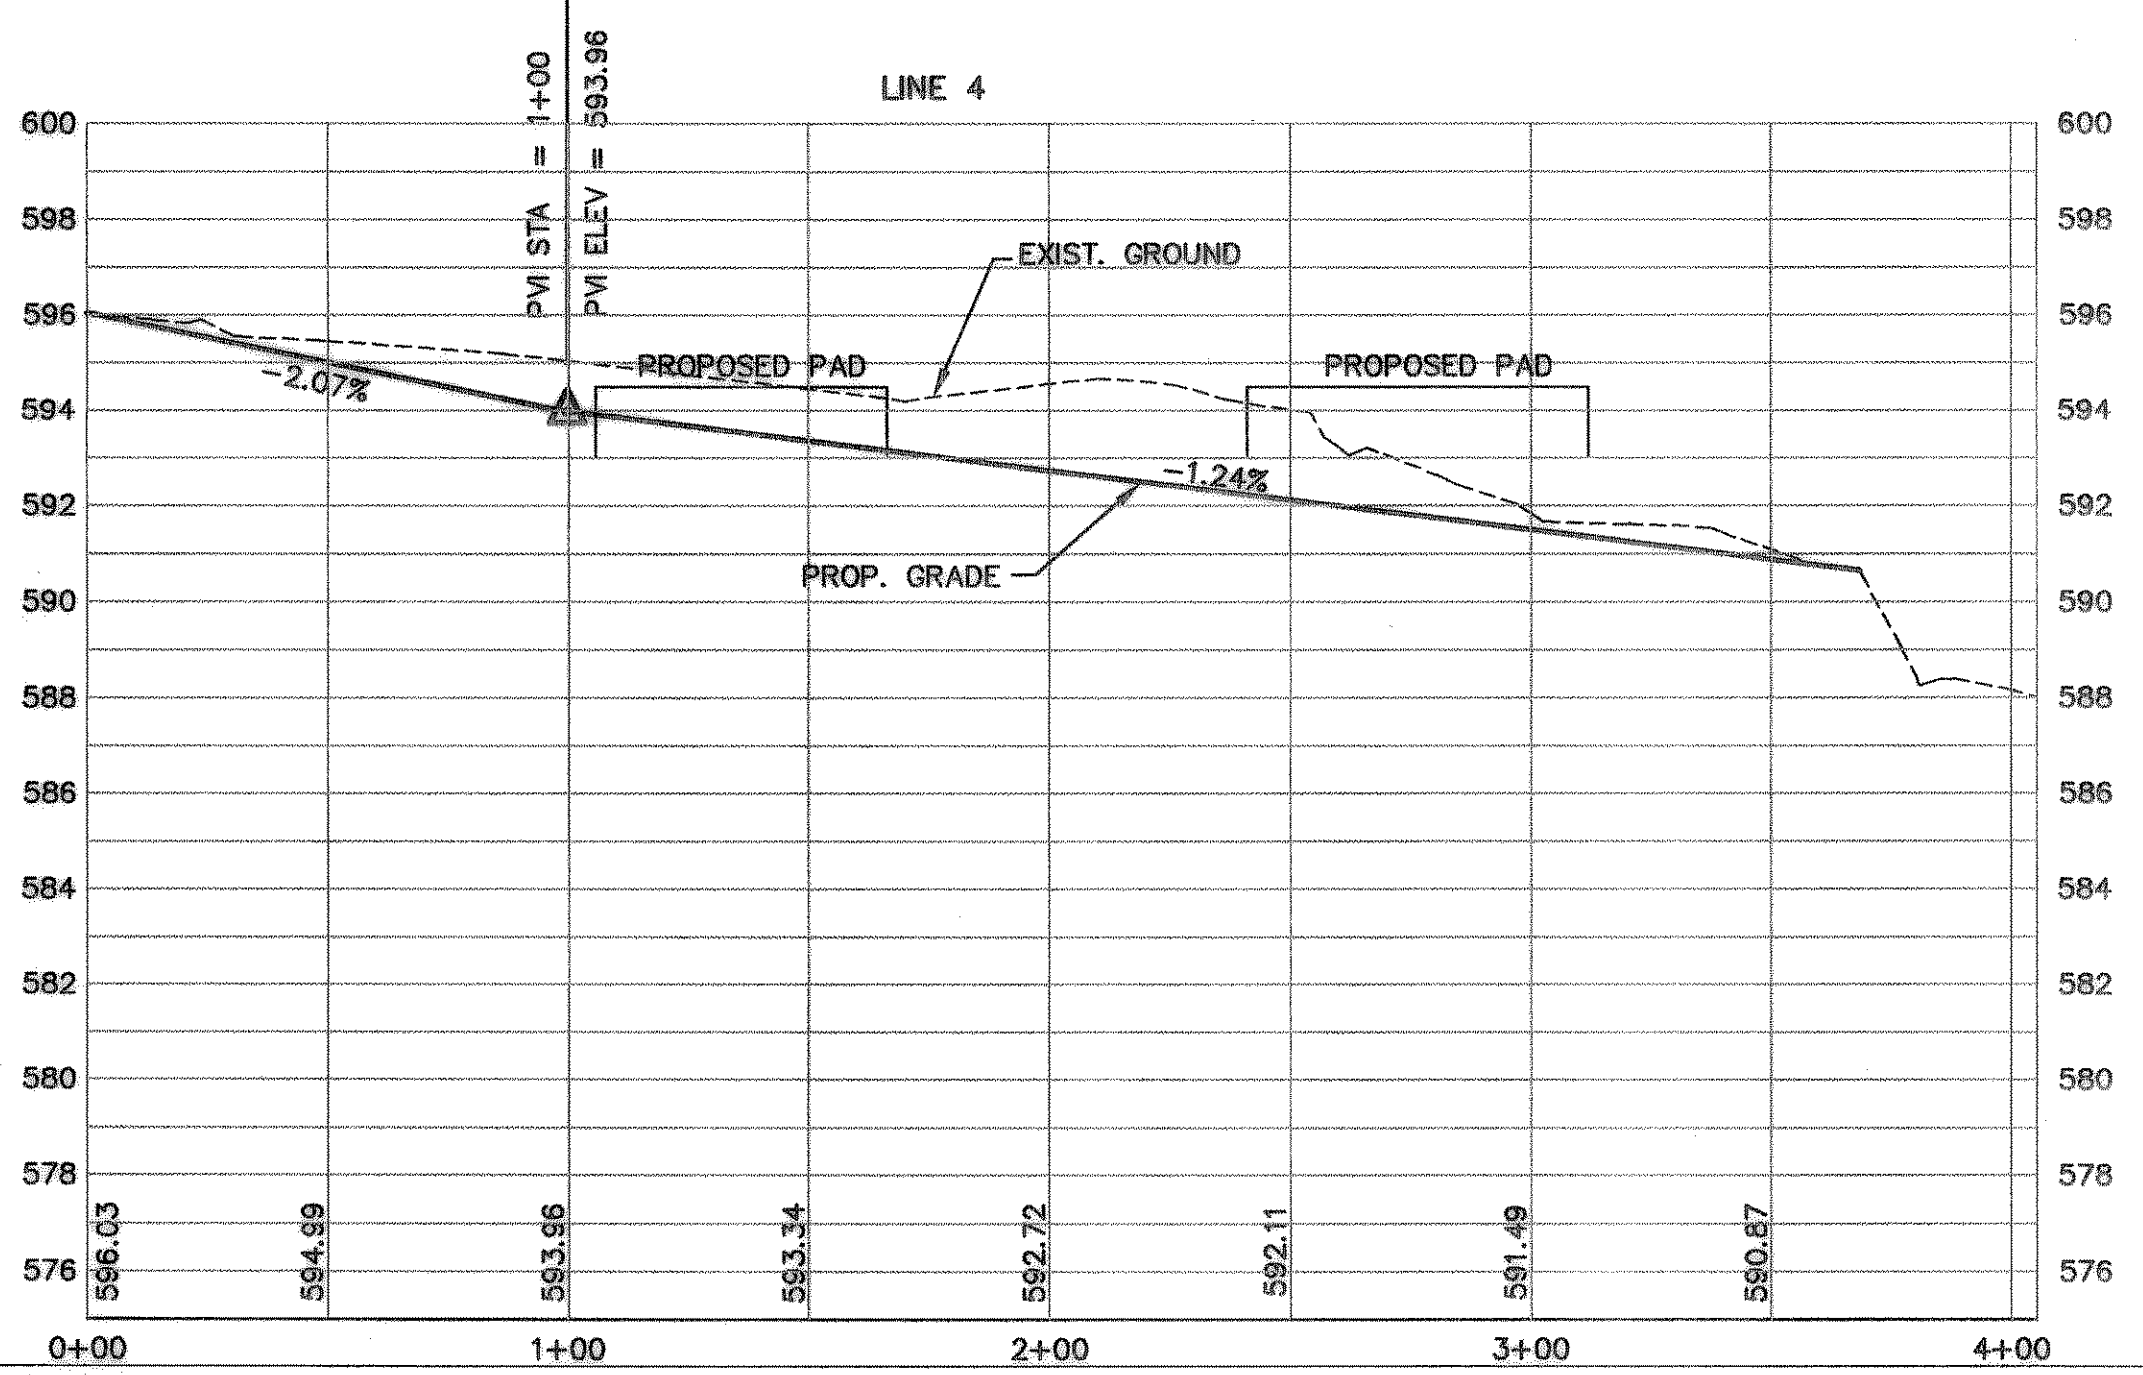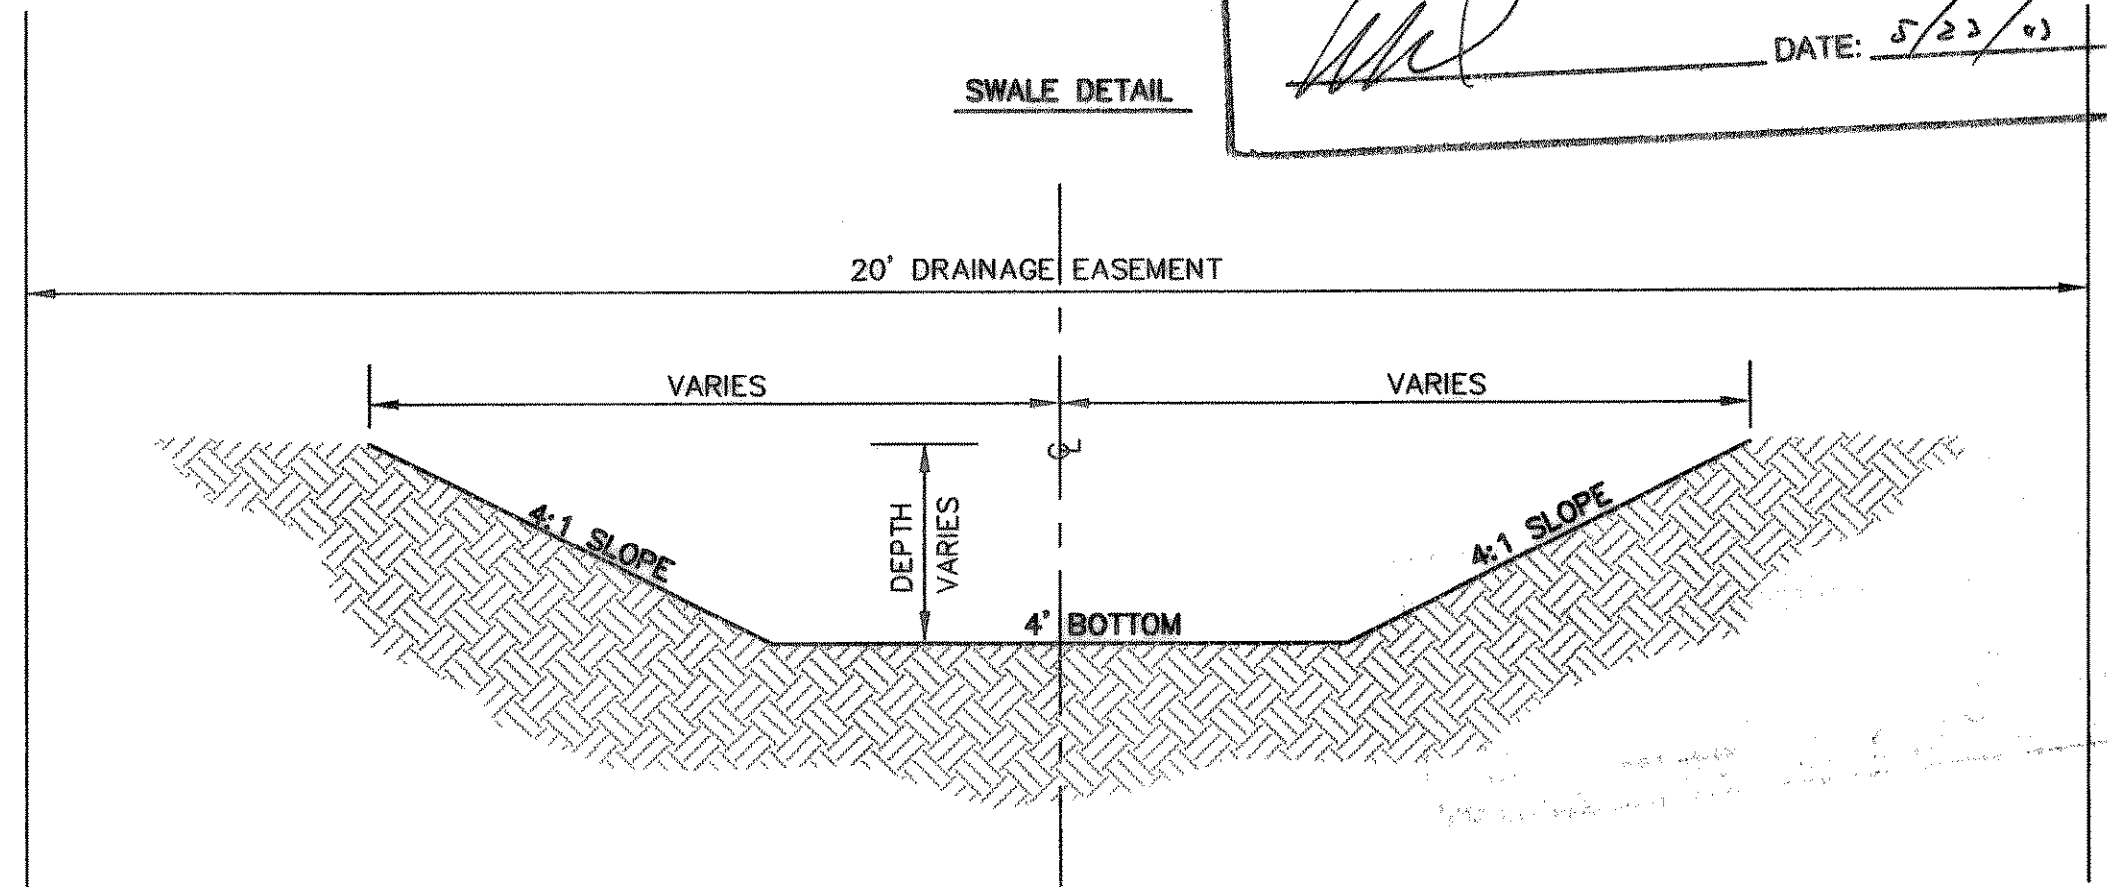

PHASE 1 - ONLY
RECORD DRAWINGS:
 THE INTENT OF THE OWNER AND ENGINEERS WAS TO CONSTRUCT THESE FACILITIES ACCORDING TO THESE PLANS AS APPROVED BY THE CITY OF ROCKWALL. THE LINES AND GRADES WERE SET ON THE GROUND FOR CONSTRUCTION ACCORDING TO SAID PLANS. THE CITY OF ROCKWALL INSPECTED THE CONSTRUCTION. THE OWNER NOR ENGINEER DID NOT VERIFY LINES OR GRADES AFTER CONSTRUCTION. WE ARE NOT AWARE OF ANY CHANGES OR REVISIONS TO THESE PLANS DURING CONSTRUCTION EXCEPT AS NOTED. DATED 6/11/02.

REVISION	
W.L.D.	
CHECKED	
K.E.B.	
DRAWN	
DATE	01/01
PROJECT	9913GRD4
	5C
	OF