

GENERAL NOTES:

1. TOPOGRAPHIC SURVEY PREPARED BY PEISER SURVEYING CO. DATED, 08/13/09.
2. ALL WORK WITHIN TXDOT R.O.W. SHALL BE PER TXDOT STANDARDS AND SPECIFICATIONS.
3. SEE SHEET 2 FOR DRIVEWAY CONSTRUCTION.
4. TRAFFIC CONTROL TO BE PER TXDOT STANDARDS AND SPECIFICATIONS.
5. CONTRACTOR TO COORDINATE CONSTRUCTION W/ADJOINING BUSINESS.
6. CONTRACTOR TO CONTACT TXDOT INSPECTOR 48 HOURS PRIOR TO CONSTRUCTION.
7. EXISTING STRIPING TO BE REMOVED BY WATER OR SAND BLASTING. NO GRINDING OF THE EXISTING STRIPING WILL BE ALLOWED.


RECORD DRAWING

THE IMPROVEMENTS SHOWN ON THIS PLAN WERE COMPLETED IN GENERAL COMPLIANCE WITH THE DESIGN PLANS TO THE BEST OF OUR KNOWLEDGE. THIS DETERMINATION WAS MADE BASED ON POST-CONSTRUCTION SURVEY DATA AND INFORMATION PROVIDED BY THE CONTRACTOR.

SIGNED: *[Signature]* DATE: 12/6/10
 VASQUEZ ENGINEERING, TEXAS REG. F-12286

LEGEND


- PROPERTY LINE
- /// ASPH PVMT

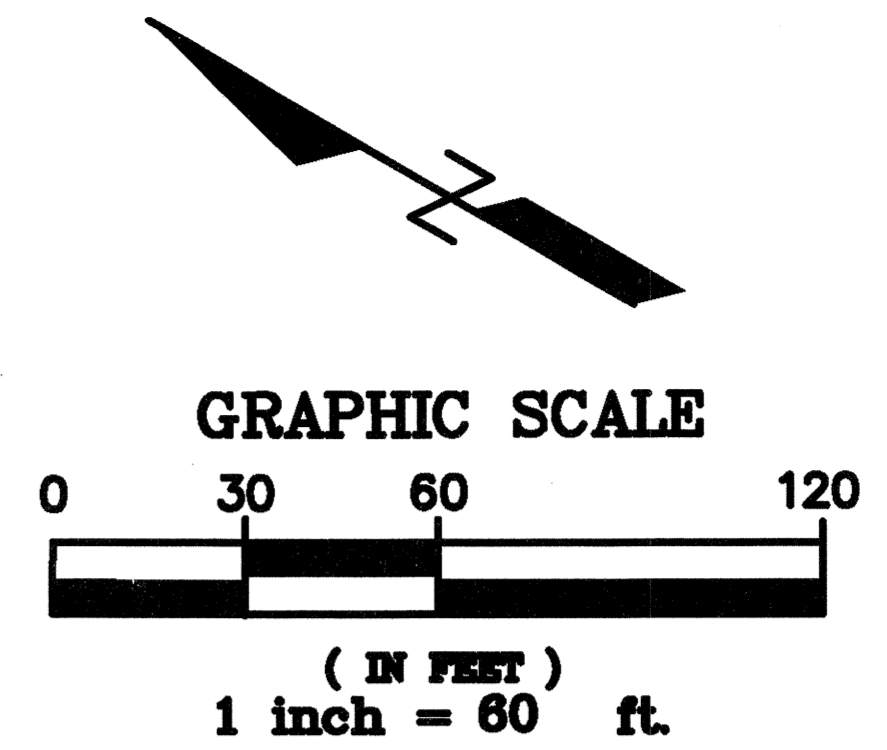

APP.	
NO.	
DATE	


VASQUEZ ENGINEERING
 4300 Alpha Road
 Building 1, Suite 100
 Dallas, Texas 75244
 Ph: 972-385-6212
 TX Registration # F-12286

EXISTING CONDITIONS

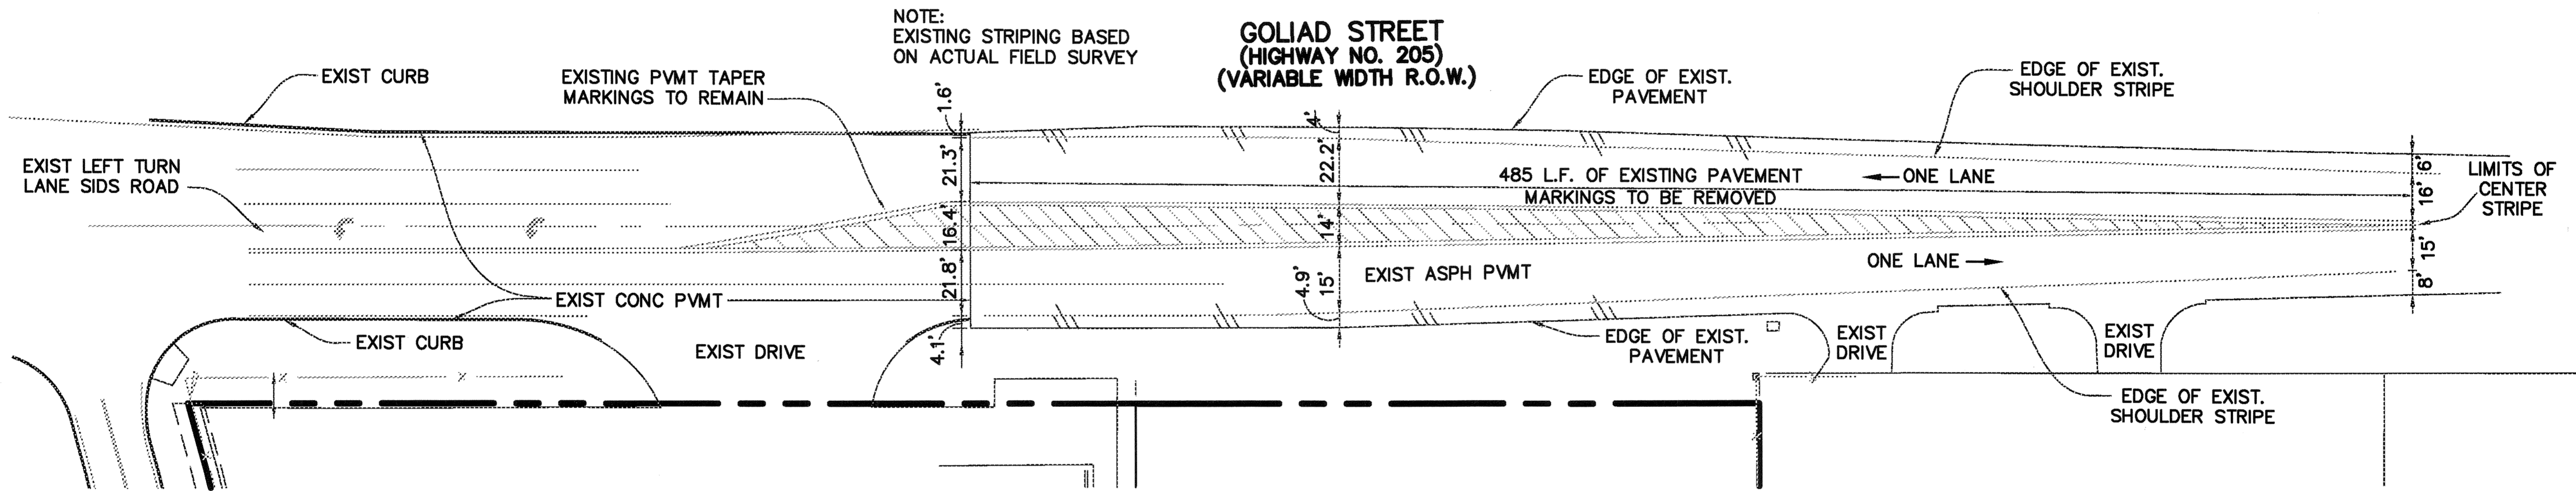


NOTE: ALL TRAFFIC MARKINGS AND STRIPING TO BE PER TXDOT STANDARDS & SPECIFICATIONS

GOLIAD STREET (HIGHWAY NO. 205) (VARIABLE WIDTH R.O.W.)

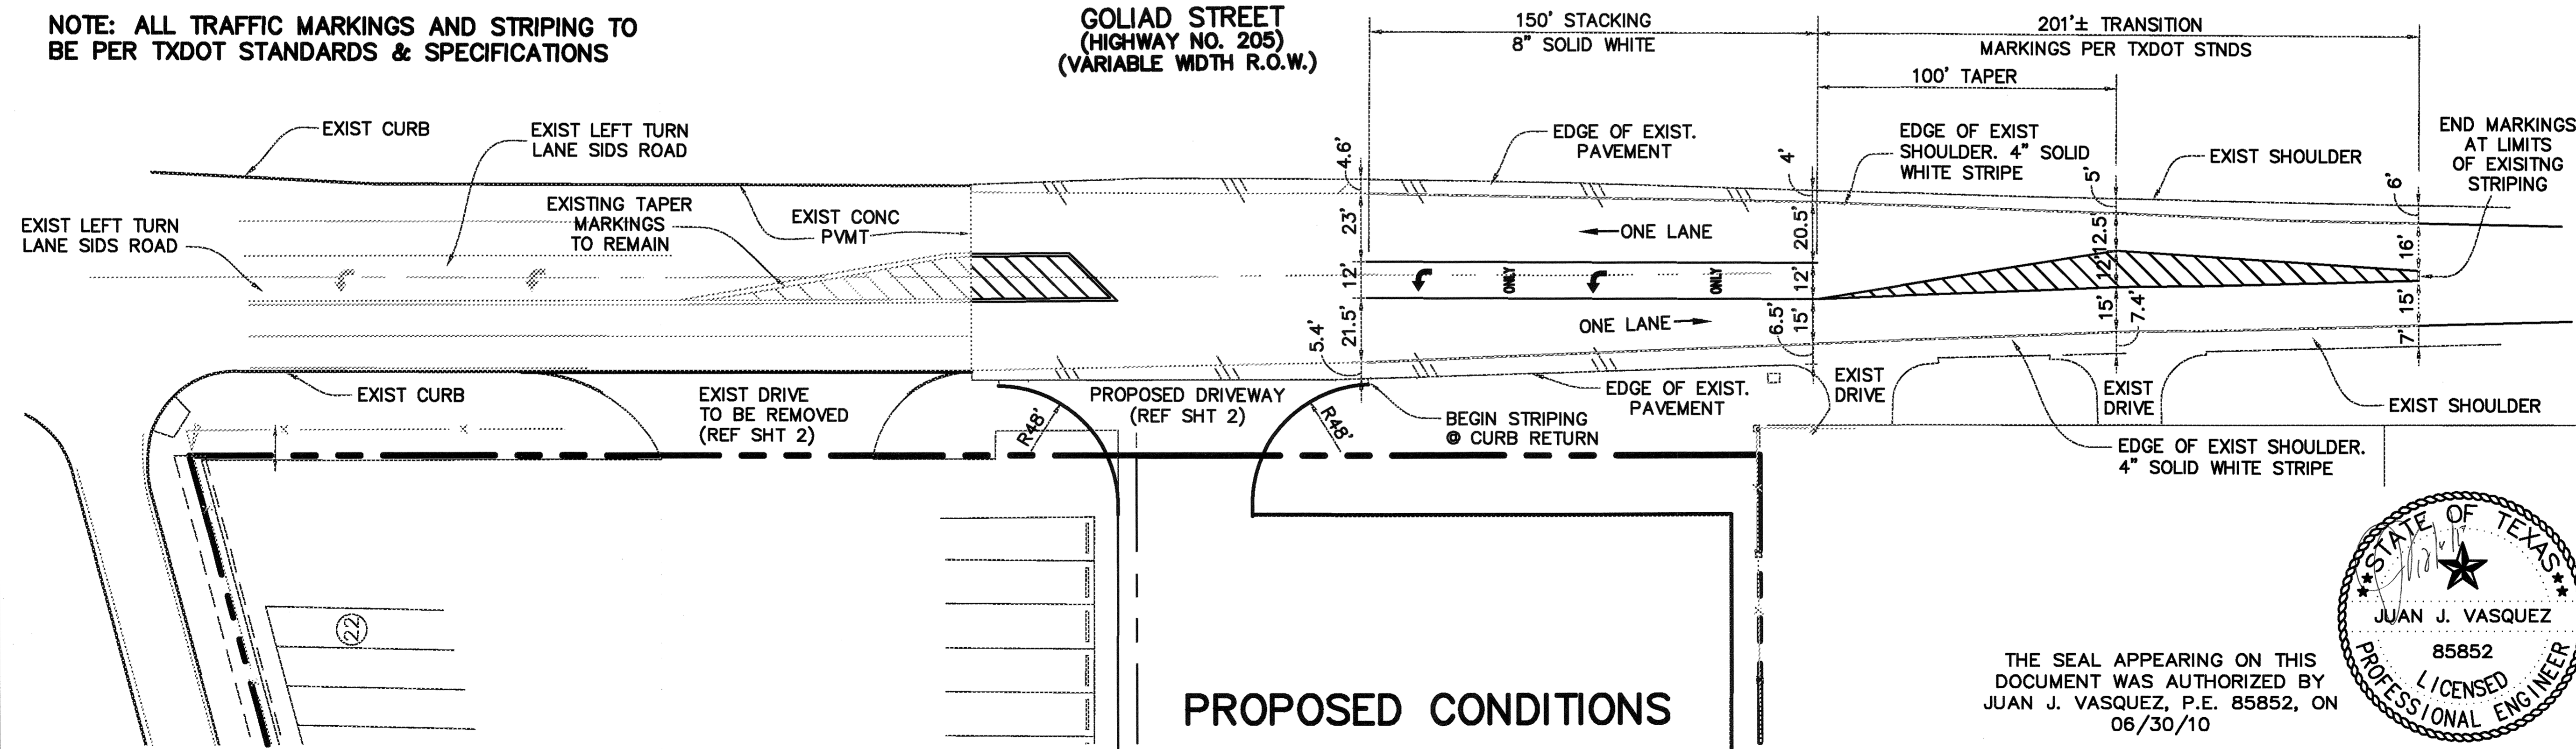

PROPOSED CONDITIONS

THE SEAL APPEARING ON THIS DOCUMENT WAS AUTHORIZED BY JUAN J. VASQUEZ, P.E. 85852, ON 06/30/10

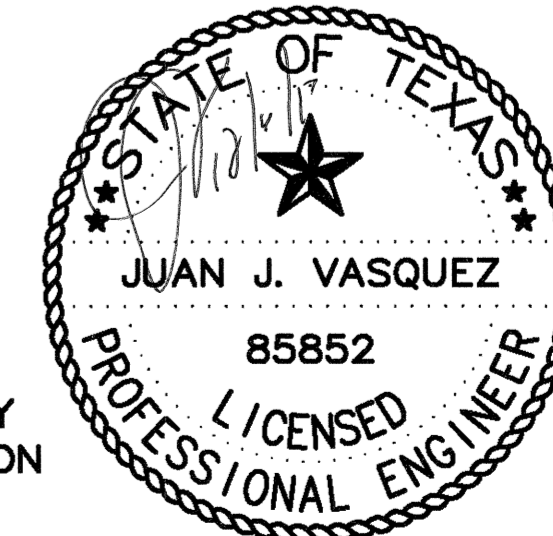

TRANSSAM TRUCKING, INC.
 2670 SOUTH GOLIAD
 ROCKWALL, TEXAS 75087
 PHONE: 972-722-0673
 FAX: 972-961-9050

STRIPING & LAYOUT PLAN
 TRANSSAM TRUCKING, INC.
 LOT 1, BLOCK A
 CITY OF ROCKWALL, ROCKWALL COUNTY, TEXAS

Scale: 1" = 60'
 Designed by: J.J.V.
 Drawn by: J.N.M.
 Checked by: J.J.V.
 06/30/10

SHEET 1