

PAVING, GRADING & DRAINAGE

FOR

TRANSAM TRUCKING


LOT 1, BLOCK A, JAMES HELWIG SUBDIVISION

IN THE

CITY OF ROCKWALL

ROCKWALL COUNTY, TEXAS

OWNER:
TRANSAM TRUCKING, INC.
2670 SOUTH GOLIAD
ROCKWALL, TX. 7502
CONTACT: JOHN BLEDSOE, VP-GM
PHONE: 972-722-0673
FAX: 972-961-9050

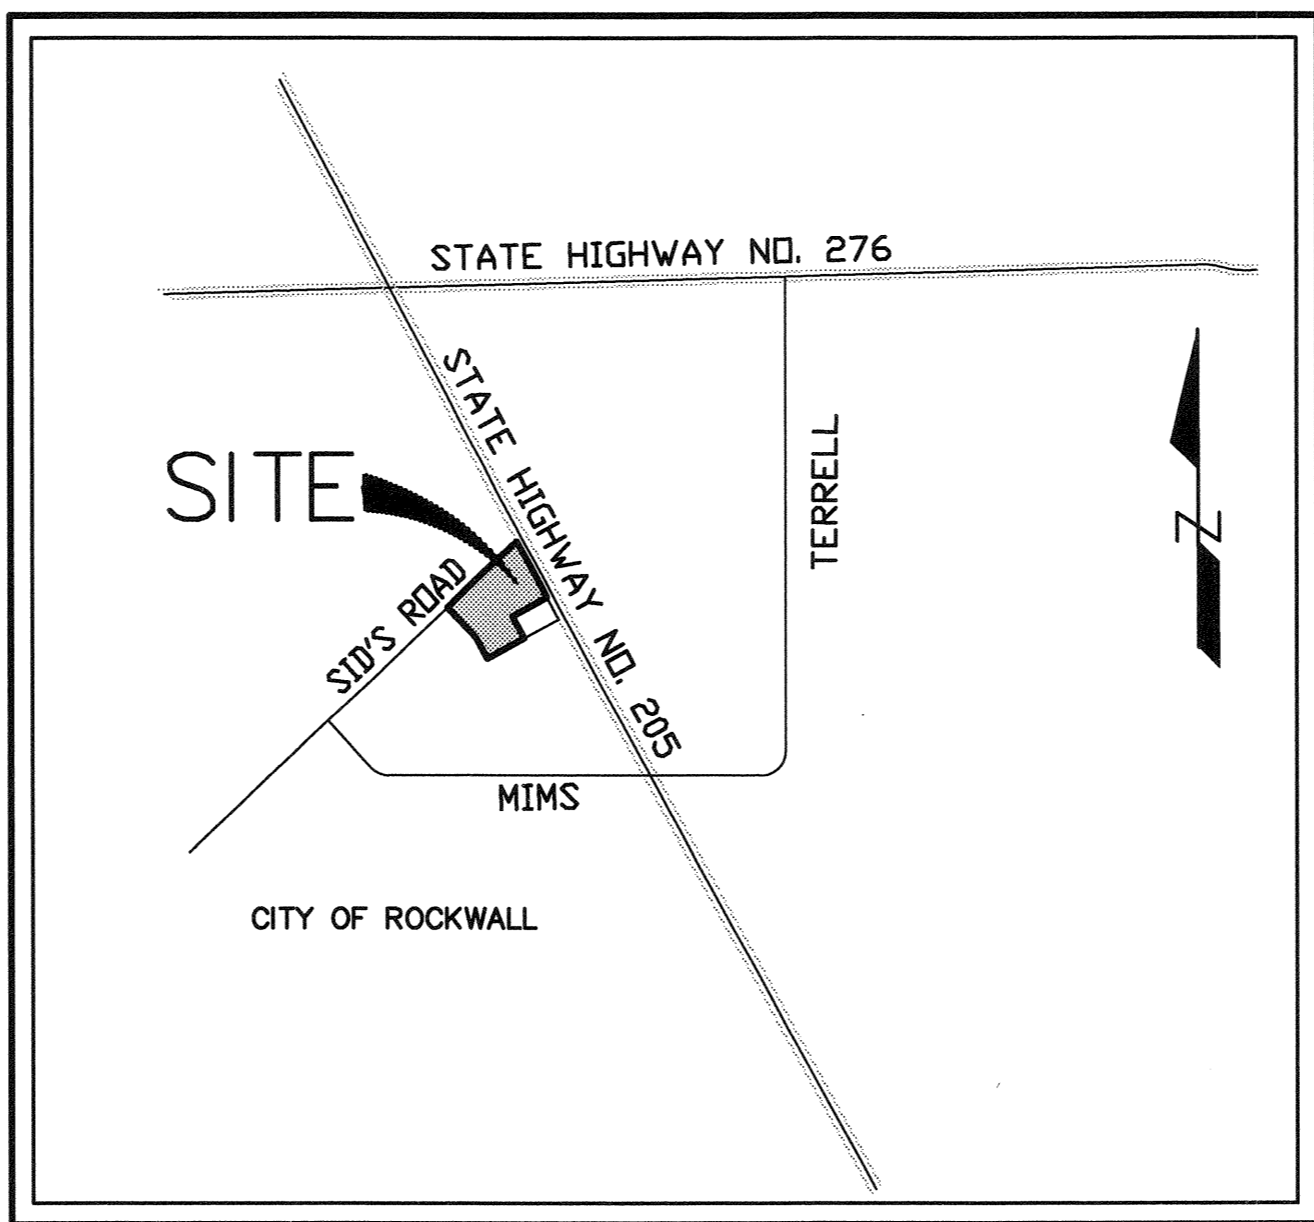

LOCATION MAP
N.T.S.

SHEET INDEX


- FINAL REPLAT
 - SP1 SITE PLAN
 - C1 PAVING & LAYOUT PLAN
 - C2 GRADING & DRAINAGE PLAN
 - C3 UTILITY PLAN
 - C4 STORM SEWER PROFILE
 - C5 DRAINAGE AREA MAP & DETENTION CALCULATIONS
 - C6 EROSION CONTROL PLAN
 - C7 GENERAL NOTES & DETAILS
-
- TXDOT PLANS
 - 1 STRIPPING & LAYOUT PLAN (FOR REFERENCE ONLY)
 - 2 DRIVEWAY PLAN (FOR REFERENCE ONLY)

NOTE: ORIGINAL DESIGN PREPARED BY TOMDEN ENGINEERING, LLP. PROJECT RELEASED TO VASQUEZ ENGINEERING ON MARCH 31, 2010.

RECORD DRAWING

THE IMPROVEMENTS SHOWN ON THIS PLAN WERE COMPLETED IN GENERAL COMPLIANCE WITH THE DESIGN PLANS TO THE BEST OF OUR KNOWLEDGE. THIS DETERMINATION WAS MADE BASED ON POST-CONSTRUCTION SURVEY DATA AND INFORMATION PROVIDED BY THE CONTRACTOR.

SIGNED: *Juan J. Vasquez* DATE: 12/6/10
JUAN J. VASQUEZ
85852
LICENSED PROFESSIONAL ENGINEER
VASQUEZ ENGINEERING, TEXAS REG. F-12266

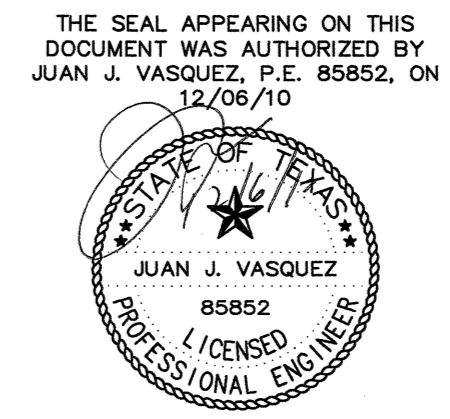

VASQUEZ ENGINEERING
4300 Alpha Road
Building 1, Suite 100
Dallas, Texas 75244
Ph: 972-385-6212
TX Registration # F-12266