



DRIVE-THRU
SCALE: 1"=10'

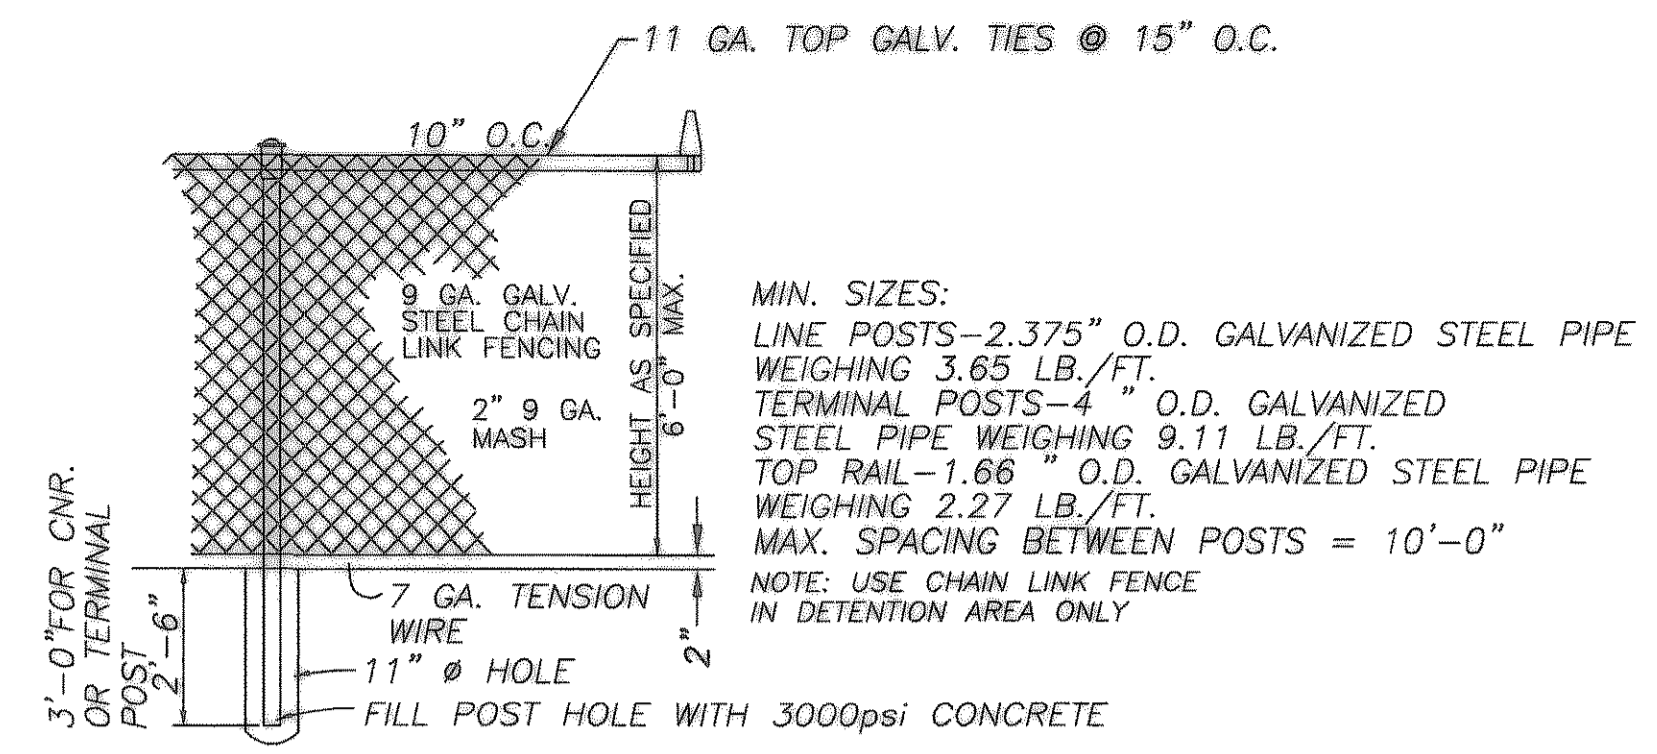


CHAIN LINK FENCE

N.T.S.

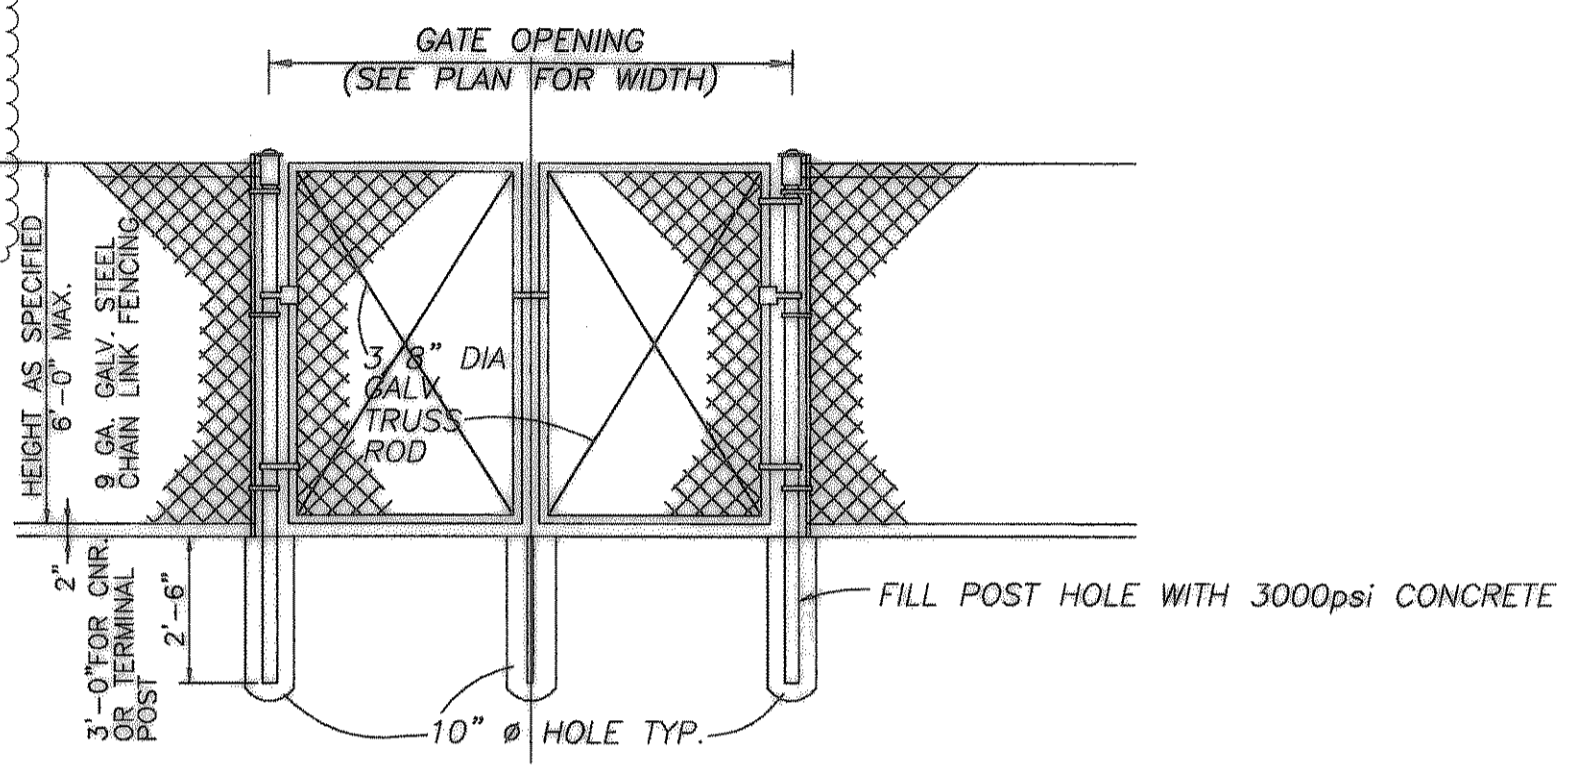


DOUBLE SWING GATE

POSTS-4" O.D. STEEL PIPE WEIGHING 9.11 LB./FT.
ALL POSTS AND FITTINGS TO BE GALVANIZED
NOTE: USE IN DETENTION POND ONLY

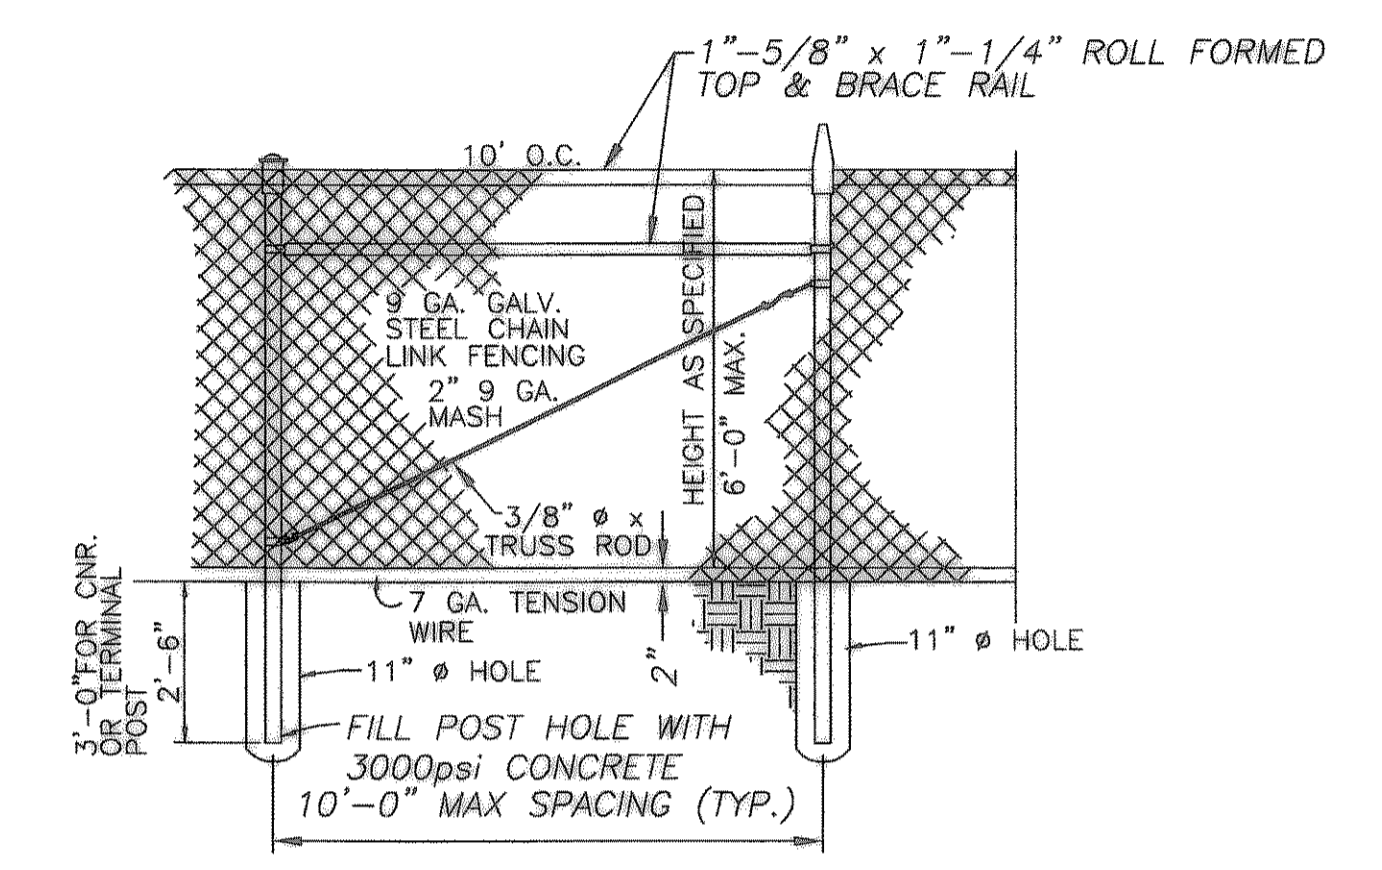


CORNER POST

N.T.S.

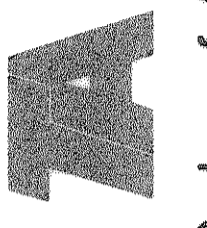

TRAVEL CENTERS OF AMERICA - Protolite
Interstate 30 at State Highway 205
Rockwall, Texas 75087

PROJECT NO: TAR2TX

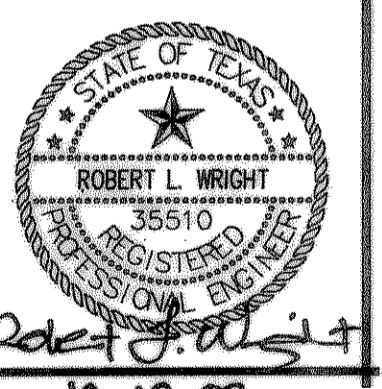

10-18-02
REVISIONS: CONSTRUCTION SET DOCUMENTS; CONSTRUCTION BULLETIN #1 10/18/02

REVISIONS PER OWNER'S COMMENTS
REVISIONS PER CITY COMMENTS

CHECKED BY: JEM

Sheet:
CONSTRUCTION DETAILS
C-10
Of:
Date: SEPTEMBER 25, 2002

RECORD DRAWING
REVISED TO REFLECT KNOWN CHANGES MADE DURING CONSTRUCTION.
Robert L. Wright DATE 9-18-03

△ ADDED DIMENSIONS, RADII, NOTE