


CONSTRUCTION PLANS
 FOR
 PAVING, GRADING & DRAINAGE
 FOR
 TRAVELCENTERS OF AMERICA ADDITION
 ROCKWALL BUSINESS PARK
 ROCKWALL, TEXAS

OWNER:


OWNER:
 TRAVELCENTERS OF AMERICA
 24601 CENTER RIDGE RD. STE# 200
 WESTLAKE, OHIO 44145-5634
 (440)808-7378

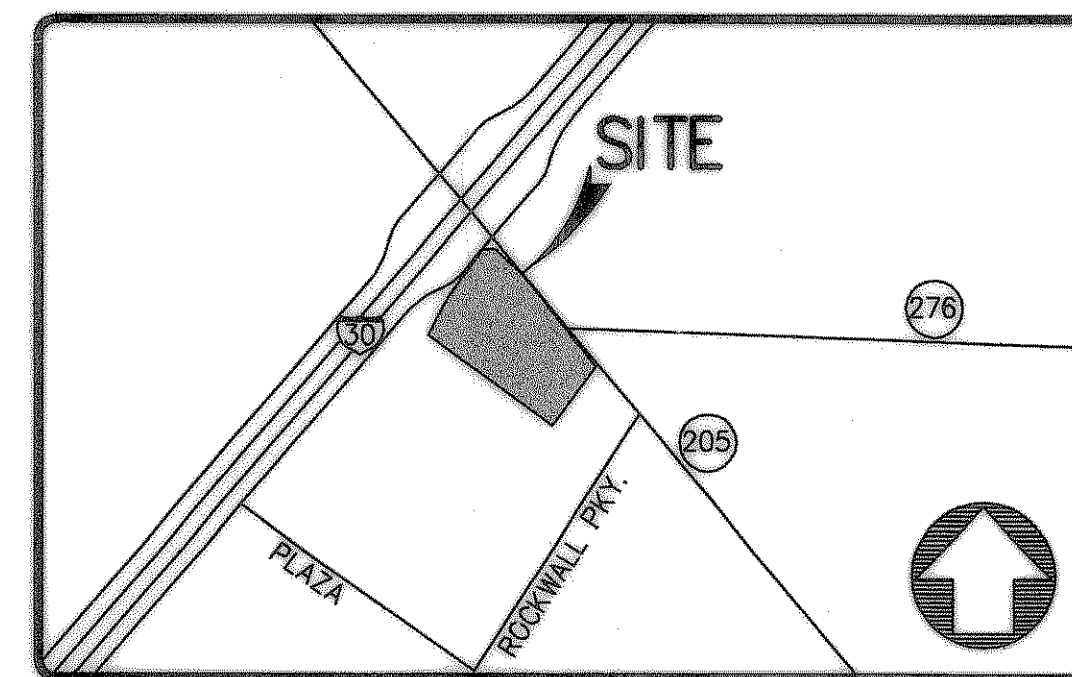

VICINITY MAP

SHEET INDEX


NO.	REV. DATE	TITLE
CS-1	10/18/02	COVER SHEET
C-1	10/18/02	FINAL PLAT
C-1A	10/18/02	FINAL PLAT
C-1B	10/18/02	NOTES
CD-1.0	10/18/02	DEMOLITION PLAN
C-2	10/18/02	SITE AND DIMENSIONAL CONTROL PLAN
C-3	10/18/02	GRADING PLAN
C-4	10/18/02	UTILITY PLAN
C-5	10/18/02	DRAINAGE AREA MAP
C-5A	10/18/02	STORM PROFILES
C-6	10/18/02	EROSION CONTROL PLAN
C-7	09/25/02	EROSION CONTROL DETAILS
C-8	10/18/02	CONSTRUCTION DETAILS
C-9	10/18/02	CONSTRUCTION DETAILS
C-10	10/18/02	CONSTRUCTION DETAILS
C-10A	10/18/02	CONSTRUCTION DETAILS
C-11	10/18/02	STORM DRAIN DETAIL
C-12	10/18/02	HEADWALL DETAILS

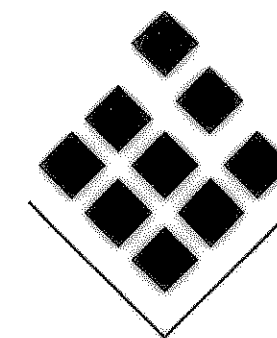

PATE ENGINEERS

8150 BROOKRIVER DR.
 SUITE S-700
 DALLAS, TEXAS, 75247
 PH. (214) 357-2981
 FAX (214) 357-2985

CONTACT: JAY E. MARSH, P.E.

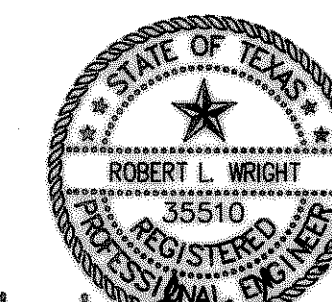

Robert L. Wright
 10-18-02

RECORD DRAWING
 REVISED TO REFLECT KNOWN CHANGES MADE DURING CONSTRUCTION.
Robert L. Wright DATE 8-18-03

CS-1

SEPTEMBER 5, 2002
 JOB NO. 078700200