



909 Lake Carolyn Parkway Suite 600 Irving, TX 75039 214.956.3400 T


214.351.2095 F wdpartners.com

Atlanta Boston Chicago Columbus Dallas Los Angeles Miami

Sacramento

TravelCenters of Americ
24601 Center Ridge Road, Suite 200
Westlake, Ohio 44145

Interstate 30 and State Highway 205 Rockwall, Texas

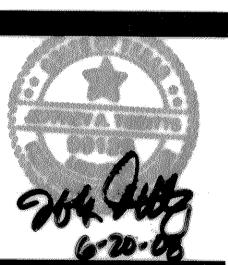

annieteres steller sich

1

ROTOTYPE

STORE NUMBI

WD PROJECT NUMBER

22