


CONSTRUCTION PLANS  
 FOR  
 PAVING, GRADING & DRAINAGE  
 FOR  
 TRAVELCENTERS OF AMERICA ADDITION  
 ROCKWALL BUSINESS PARK  
 ROCKWALL, TEXAS

OWNER:


OWNER:  
 TRAVELCENTERS OF AMERICA  
 24601 CENTER RIDGE RD. STE# 200  
 WESTLAKE, OHIO 44145-5634  
 (440)808-7378

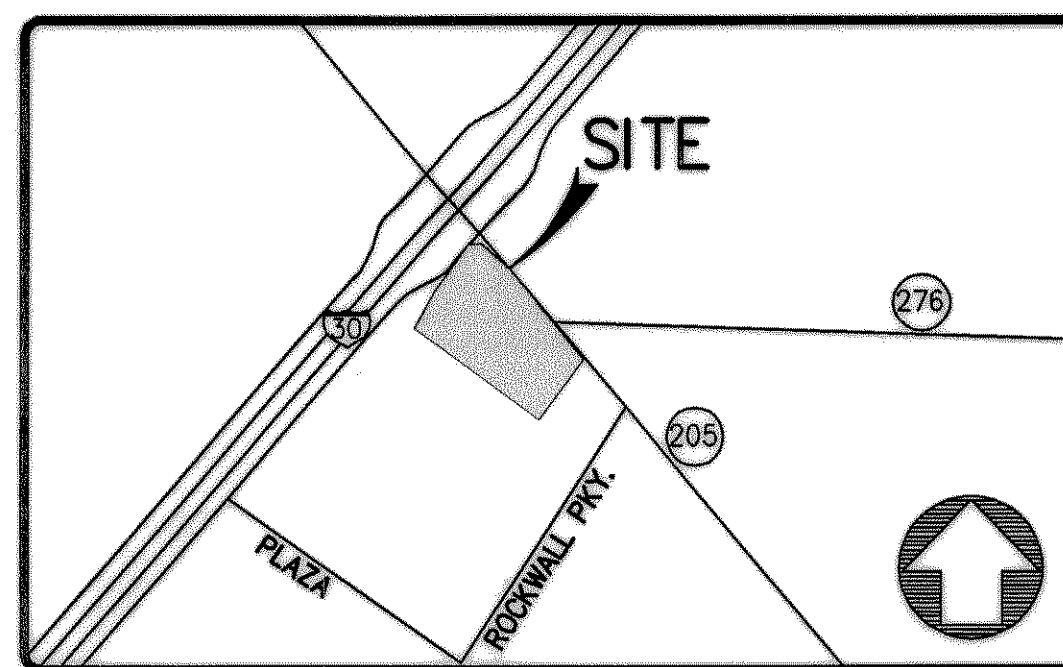

VICINITY MAP

SHEET INDEX

NO.	REV. DATE	TITLE
CS-1	07/27/04	COVER SHEET
	07/27/04	FINAL PLAT
	07/27/04	FINAL PLAT
	07/27/04	FINAL PLAT
C-1B	07/27/04	NOTES
C-2	07/27/04	SITE AND DIMENSIONAL CONTROL PLAN
C-3	07/27/04	GRADING PLAN
C-4	08/16/04	UTILITY PLAN

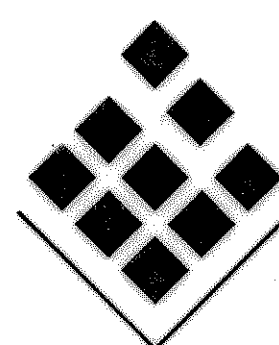


PATE ENGINEERS

8150 BROOKRIVER DR.  
 SUITE S-700  
 DALLAS, TEXAS, 75247  
 PH. (214) 357-2981  
 FAX (214) 357-2985

CONTACT: JAY E. MARSH, P.E.

RECORD DRAWING  
 REVISED TO REFLECT KNOWN CHANGES MADE DURING CONSTRUCTION.  
 DATE 11/09/04

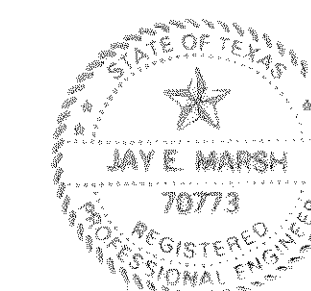

CS-1

AUGUST 16, 2004  
 JOB NO. 078700402