


# DEVELOPMENT PLANS FOR Trend Tower at the Harbor CITY OF ROCKWALL, TEXAS

Trend Tower at the Harbor

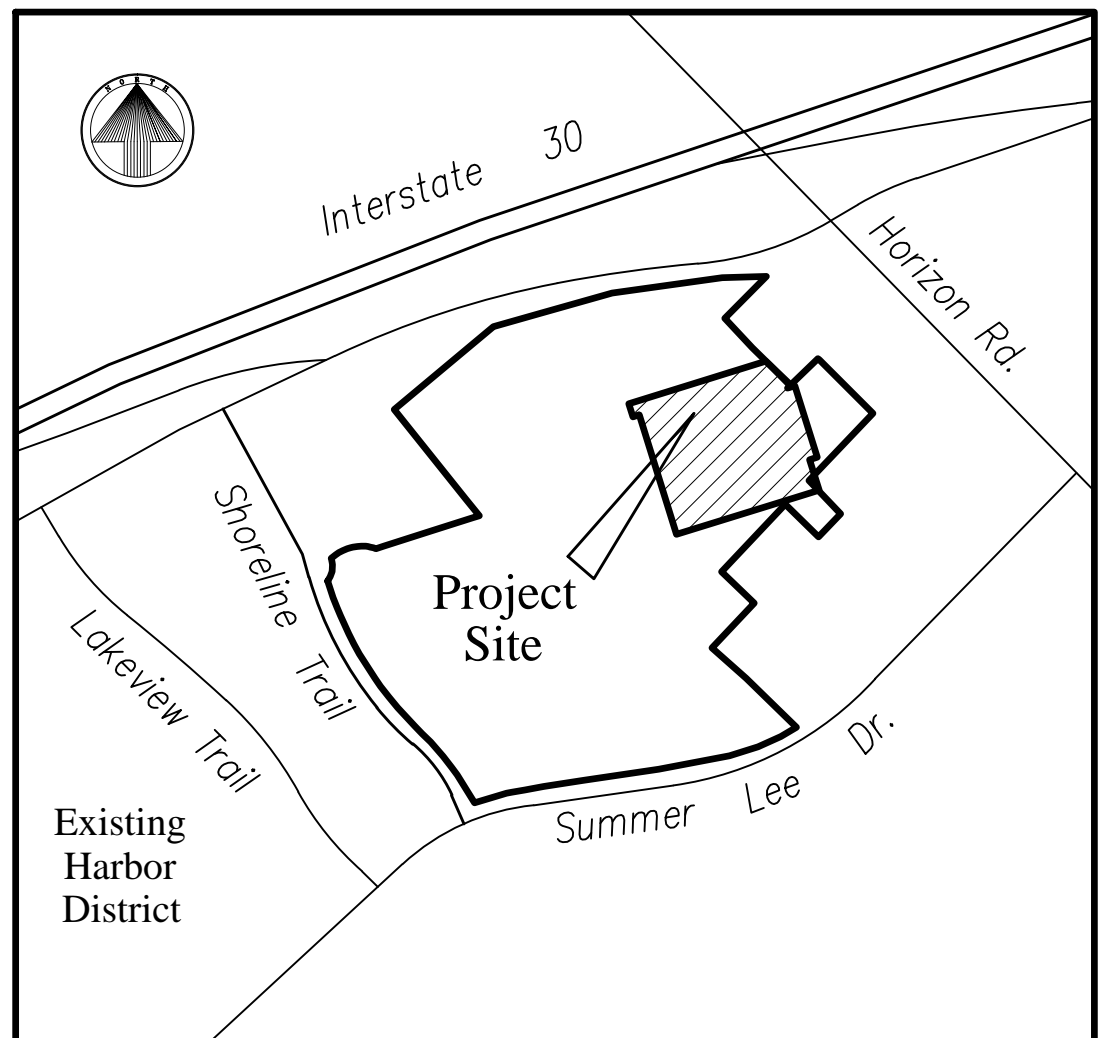

LOCATION MAP

INDEX of SHEETS

<u>Sheet No.</u>	<u>Title</u>
1	Cover Sheet
2	Final Plat
3	Erosion Control Plan
4	Site Plan
5	Paving Plan
6	Grading Plan
7	Harbor District Overall Drainage Map
8	Storm Sewer Plan
9	Storm Sewer Plan and Profile
10	Utility Plan
11	Sanitary Sewer Profiles

05/09/2014



~ Engineer ~



**F.C. CUNY CORPORATION**

#2 Horizon Court • Heath, Texas 75032 • (469) 402-7700  
Texas Registered Engineering Firm F-7449

Developer  
Harbor Heights Investors, L.P.  
#2 Horizon Court, Suite 1000  
Heath, Texas 75032  
(972) 772-9400

RECORD DRAWINGS  
May 9, 2014