


SCALE: H: 1"=40'
V: 1"=40'

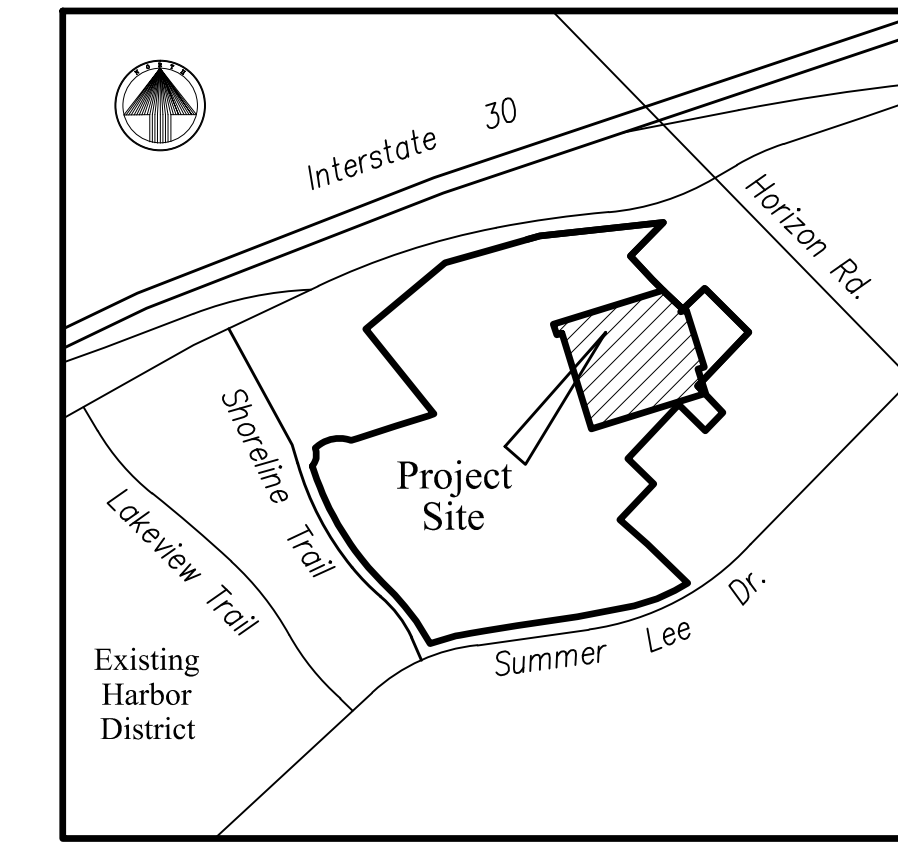

LOCATION MAP


Revision	Date	Description

Owner:
Harbor Heights Investors L.P.
#2 Horizon Court • Heath, Texas 75032 • 469-772-9400

Trend Tower at the Harbor
Rockwall, Texas

~ Civil Engineer ~
F.C. CUNY CORPORATION
#2 Horizon Court • Heath, Texas 75032 • (469) 402-7700
Texas Registered Engineering Firm F-7449

05/09/2014

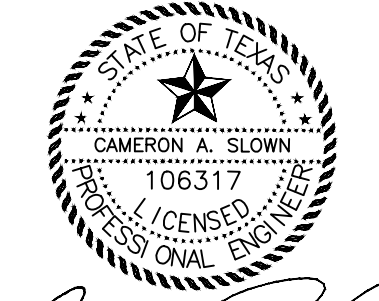

Cameron A. Slown

Drawn By: F.C. CUNY	Checked By: F.C. CUNY
Date: 05/12	Project No.:
Sheet Title: Sanitary Sewer Profile	
Scale: 1"=40'	Sheet No.: