


Development Plans

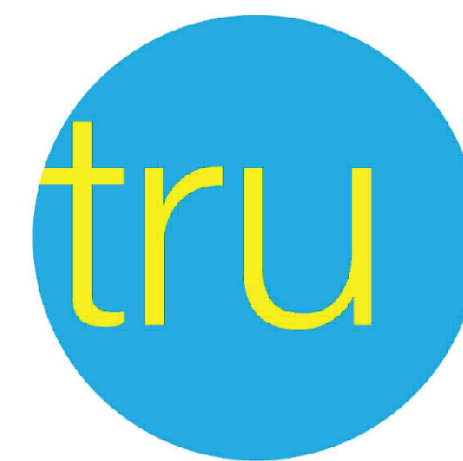


by HILTON™

TRU by Hilton

City of Rockwall ~ Rockwall County, Texas

Index of Sheets

<u>Sheet No.</u>	<u>Title</u>
1	Cover Sheet
--	Final Plat
2	Demolition Plan
3	Erosion Control Plan
4	Site Plan
4A	Streetscape Plan
5	Paving Plan
6	Grading Plans
7	Pre Developed Drainage Area Map
8	Post Developed Drainage Area Map
9	Storm Sewer Plan and Profiles
10	Utility Plan and Profiles
--	Retaining Wall Plans

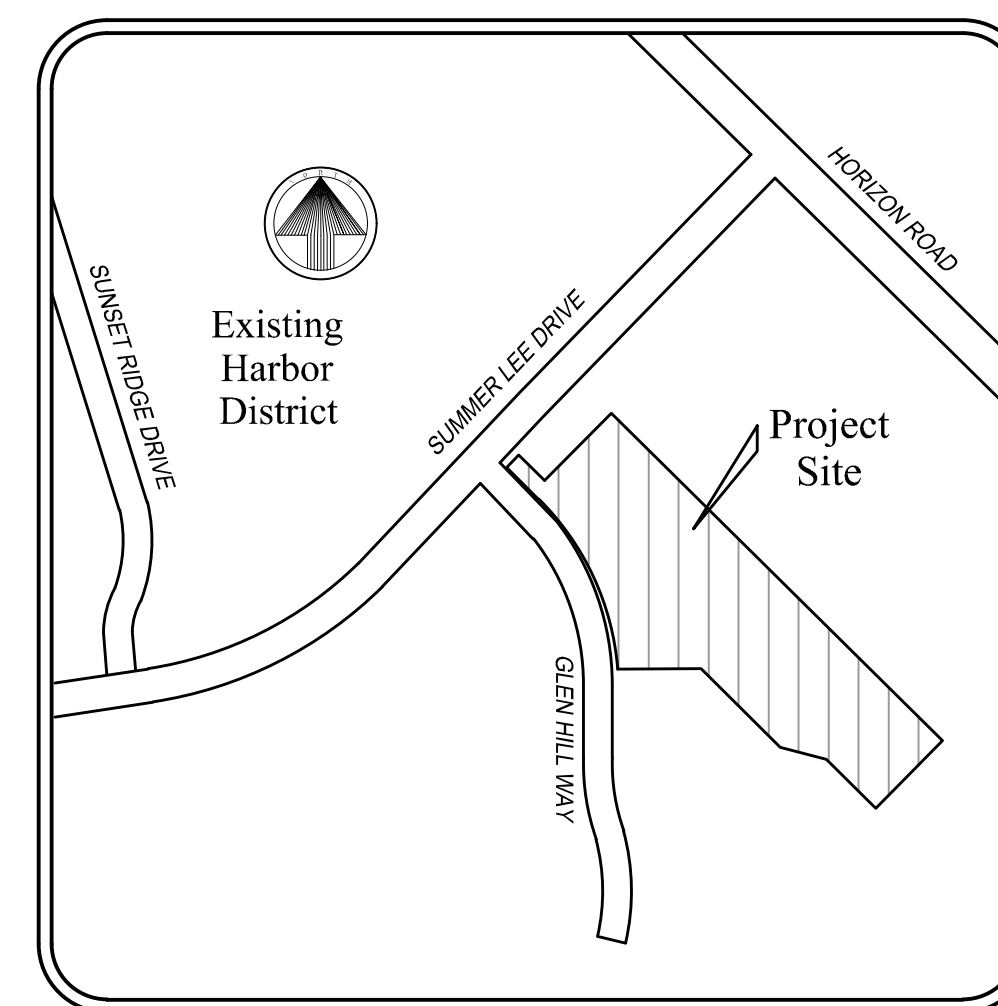

LOCATION MAP

Construction Note

All construction to be by City of Rockwall Standards and NCTCOG 4th Edition Standards.

Owner:
MHC Rockwall, LLC
C/O McNeill Hotel Company
1468 Kimbrough Road, Suite 103
Germantown, TN 38138

Engineer:
F.C. Cuny Corp. 
#2 Horizon Court
Suite 500
Heath, Texas 75032
469.402.7700
Texas Registered Engineering Firm F-7449

Record Drawings

September 2020

