



**teague nall and perkins, inc**  
823 Walters Creek Blvd., Suite M000  
Allen, Texas 75013  
214.461.9867 ph 214.461.9864 fx  
www.tnphinc.com  
TBP#: F-230; TBPL#: 10011600, 1011601, 10194381



PROJECT:  
**TRU by HILTON**  
2800 SUMMER LEE DRIVE  
ROCKWALL, TEXAS 75087  
CLIENT:  
**MHC Rockwall, LLC.**  
1468 KIMBROUGH ROAD, SUITE 103  
GERMANTOWN, TENNESSEE 38188


©2018 GARY BRINK & ASSOC.  
Any duplication, reproduction, or use by any other party is prohibited unless prior written authorization is received from GARY BRINK & ASSOC.

PROJECT: 201709  
DRAWN BY: C.A.S.  
DATE: 9/2/2020  
SCALE: AS NOTED


CASE NO.

STREETSCAPE  
PLAN

**C4A.0**

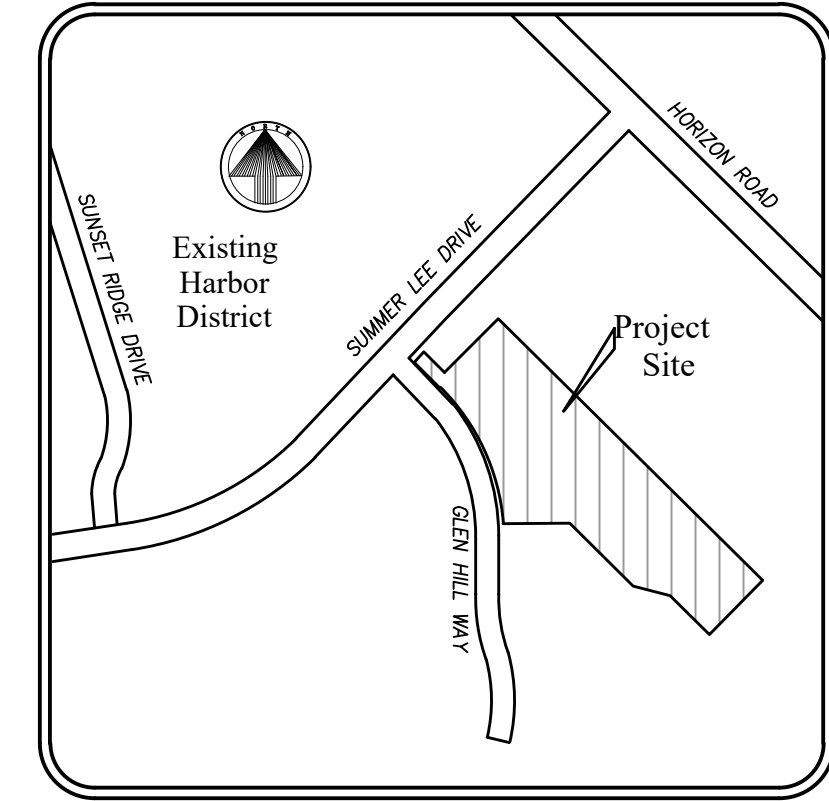


**LOCATION MAP**

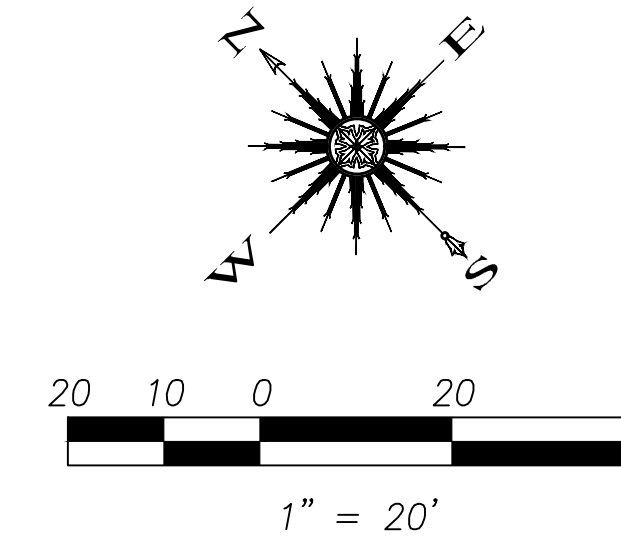

**TREE PLANTING NOTE:**  
TREES SHOWN ON THIS PLAN ALONG SUMMER LEE DRIVE AND GLEN HILL WAY ARE CEDAR ELM PER THE PD-32 ORDINANCE. RE: LANDSCAPE PLAN FOR FURTHER INFORMATION

**SITE LEGEND**

- SITE STREET LIGHTS, BEGA 9701 MH 100W METAL HALIDE FIXTURE ON BEGA 1108 HR 11'-8" TAPERED ROUND POLE WITH INTEGRAL BANNER ARMS, POWDER COAT COLOR RAL#7003 MOSS GREY.
- LANDSCAPE UP LIGHTS, ALL STREET TREES WITHIN THE RIGHT OF WAY SHALL BE UPLIGHT WITH (2) B-K LIGHTING HP2-PAR2020-TR-59-SAP-11-XXX-AH/CPC, UNLESS MORE SHOWN ON PLAN FOR LARGER TREES.
- SITE BENCH 72" LONG, LANDSCAPE FORMS, SCARBOROUGH TYPE. WITH BENCH BACK AND CENTER ARM. COLOR TO BE RAL # 7003 MOSS GREY.
- SITE LITTER RECEPTACLES TOP OPENING LANDSCAPE FORMS, COLOR RAL #7003 MOSS GREY, SCARBOROUGH TYPE. STRAP TYPE TO MATCH BENCH.
- PROPOSED STREET TREE. RE: LANDSCAPE PLAN FOR TYPE AND SIZE

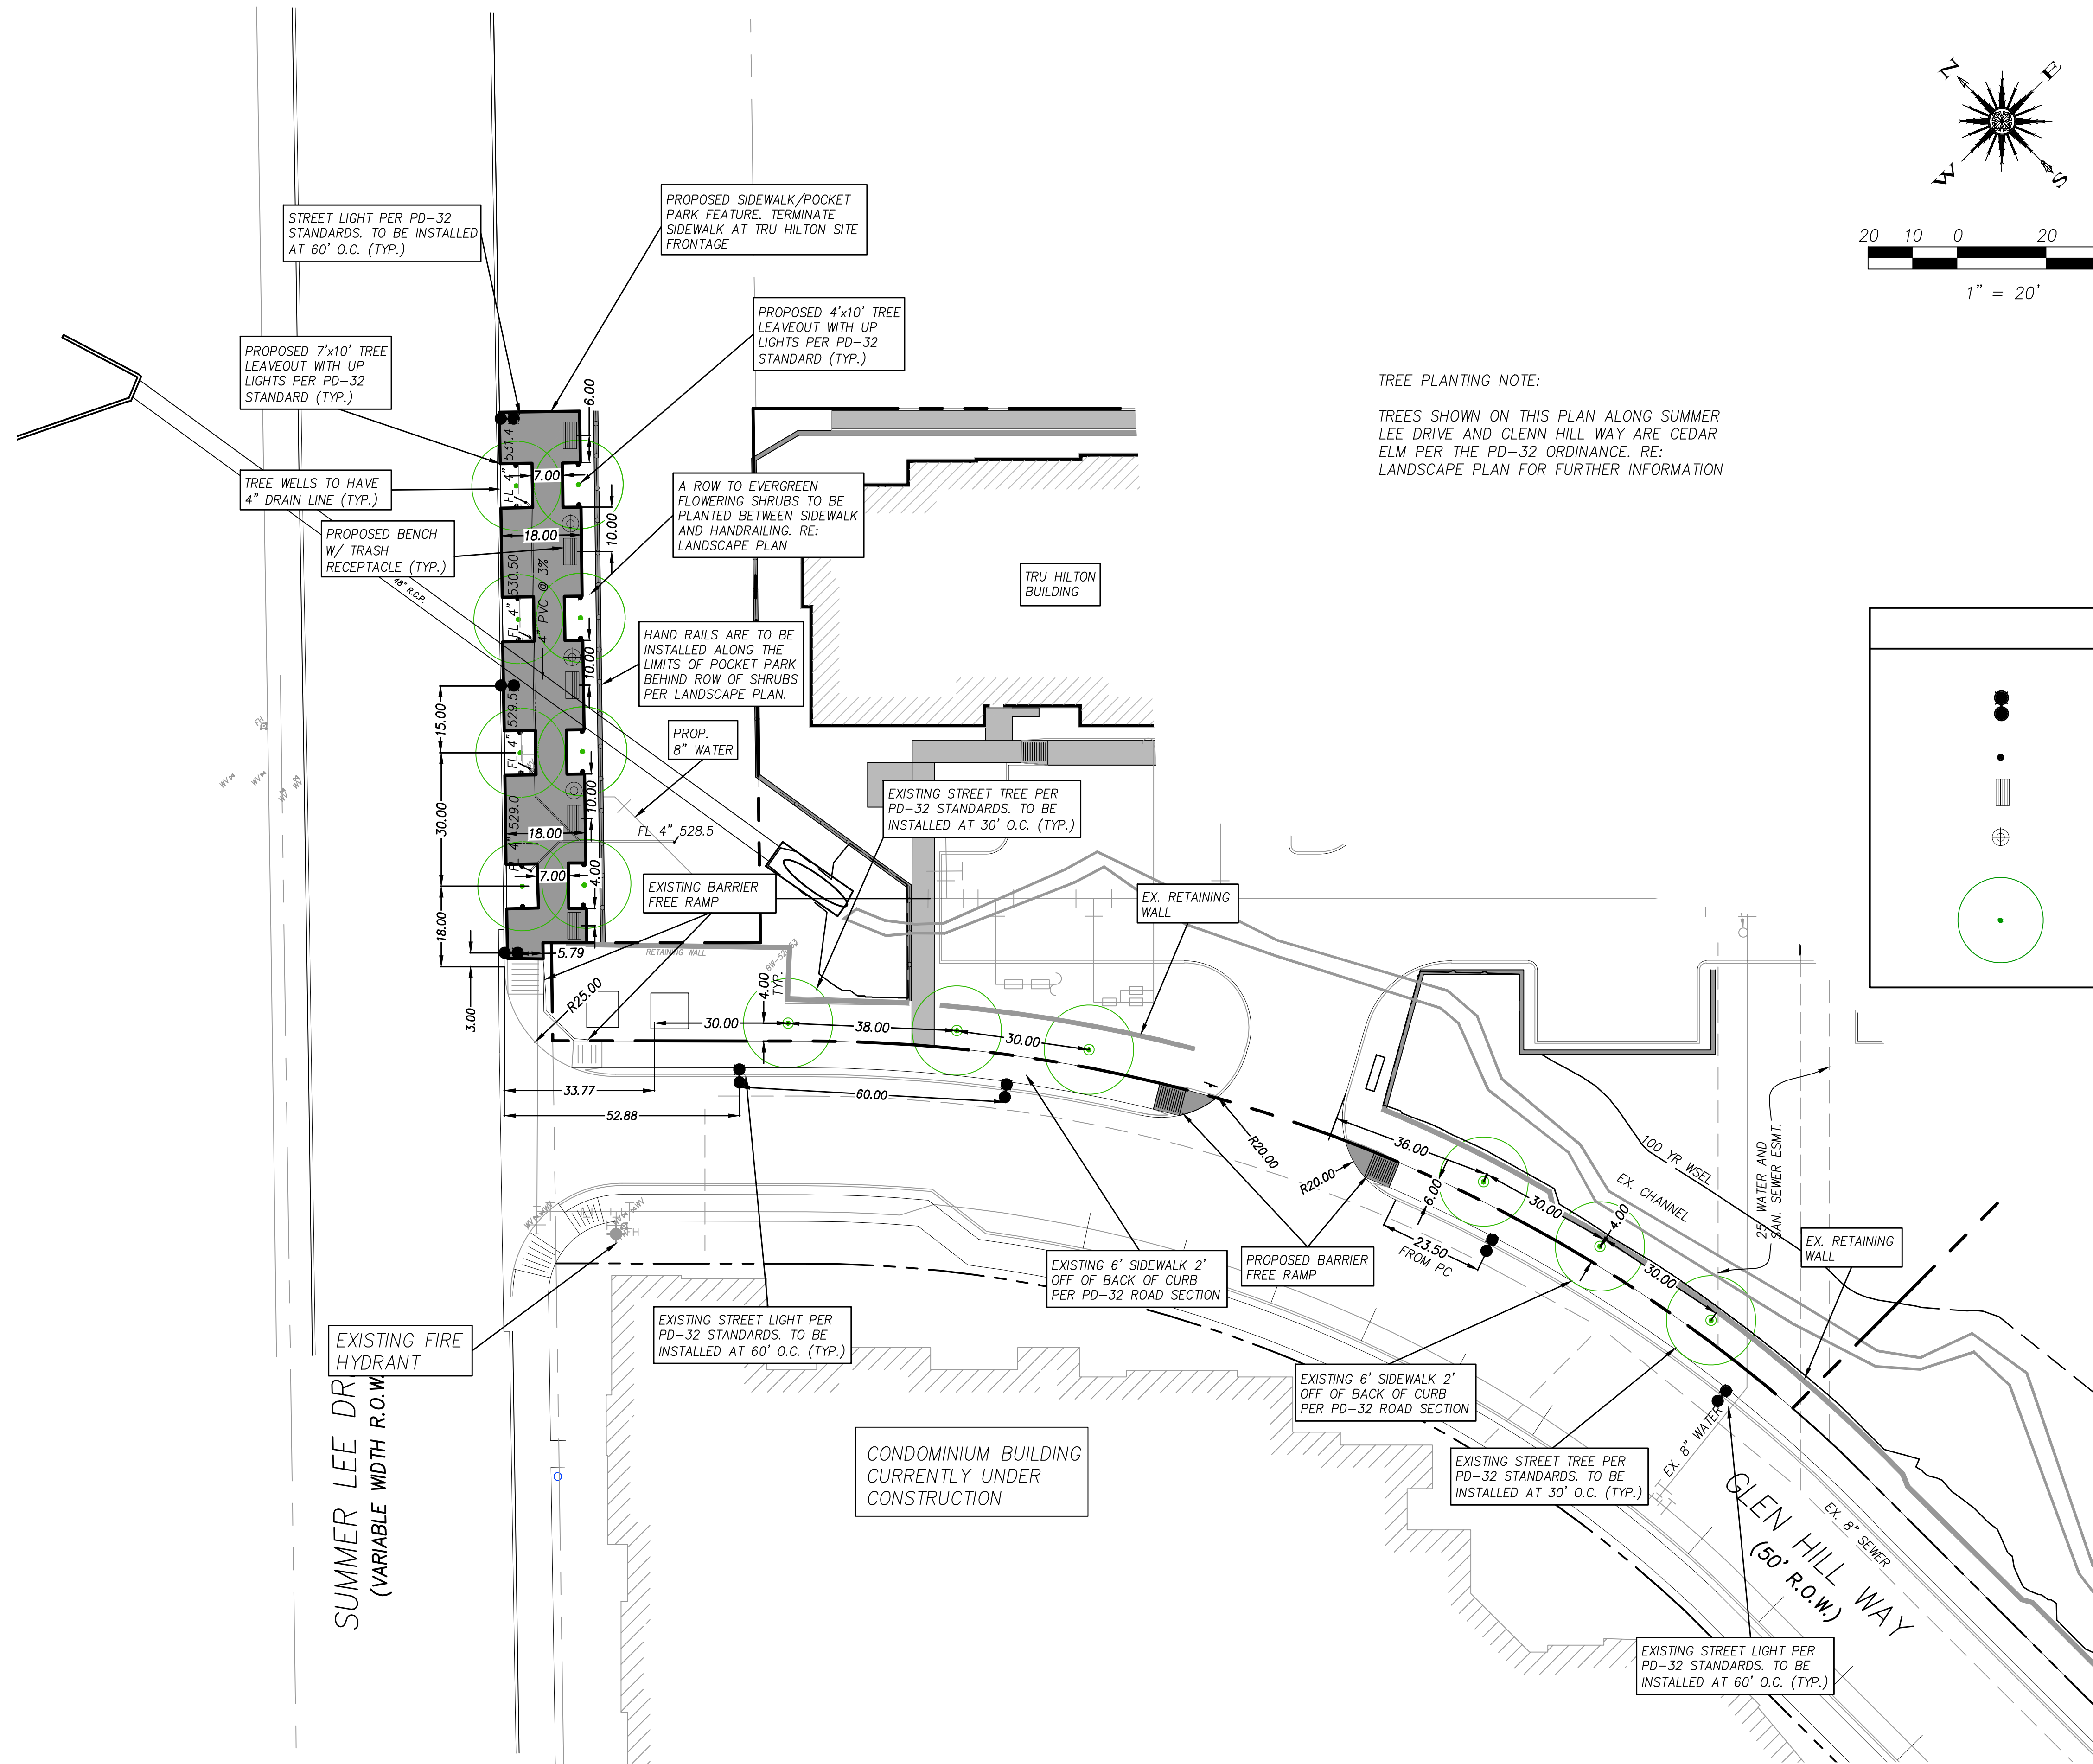

9/2/2020



*C.A.S.*

SP 2018-017  
RECORD DRAWINGS