
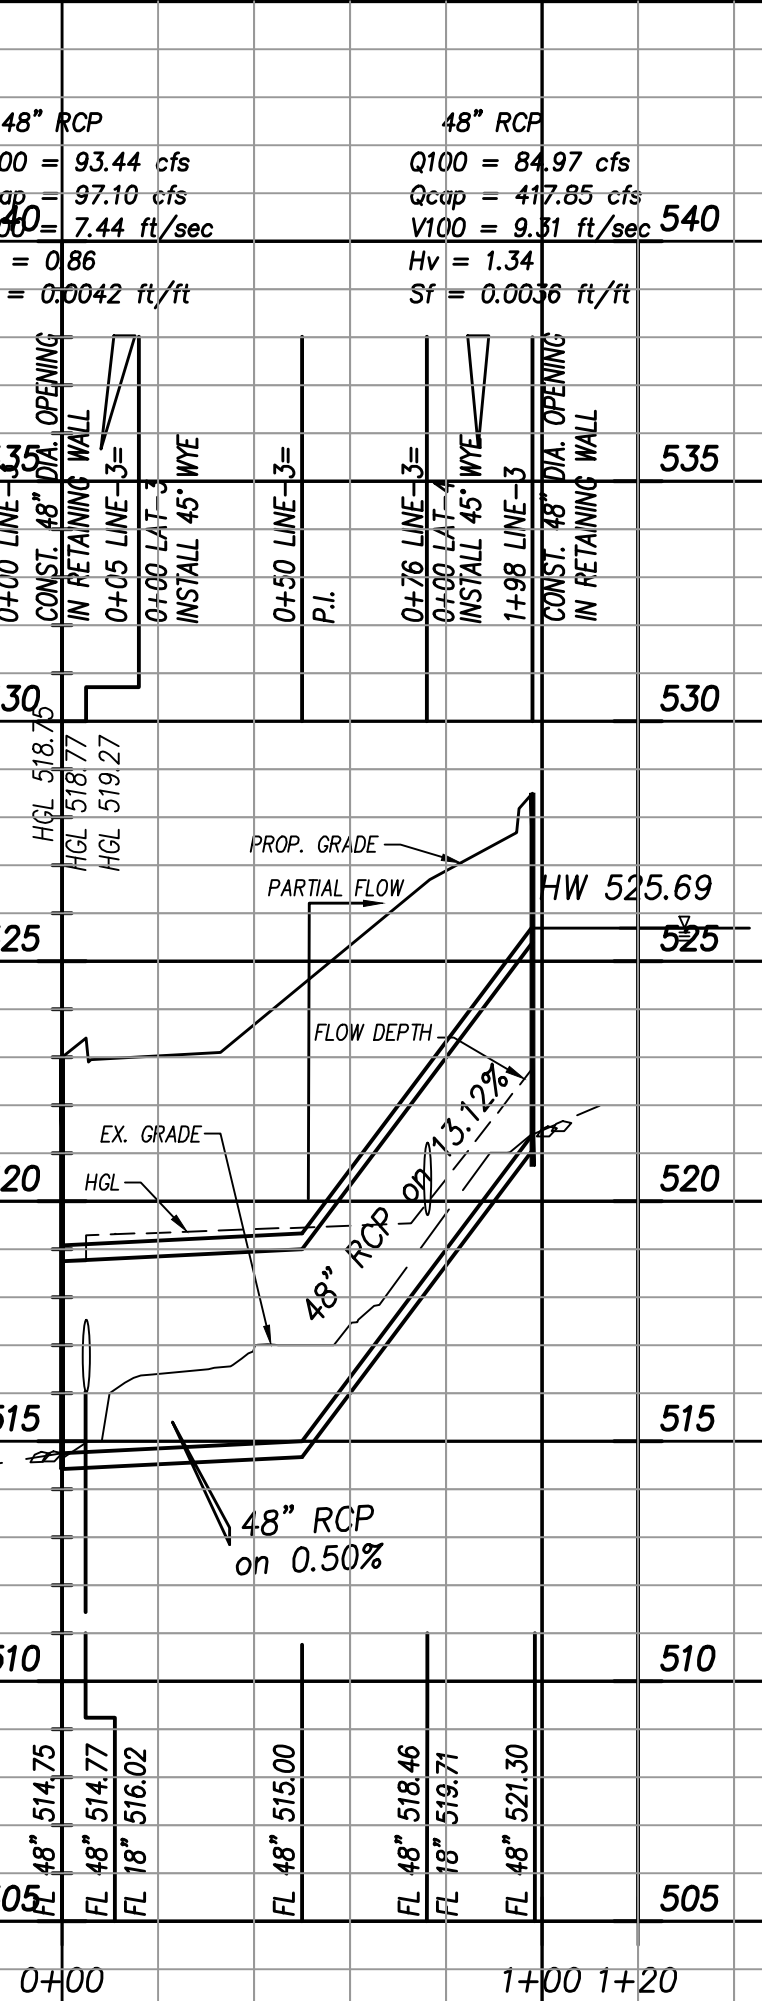
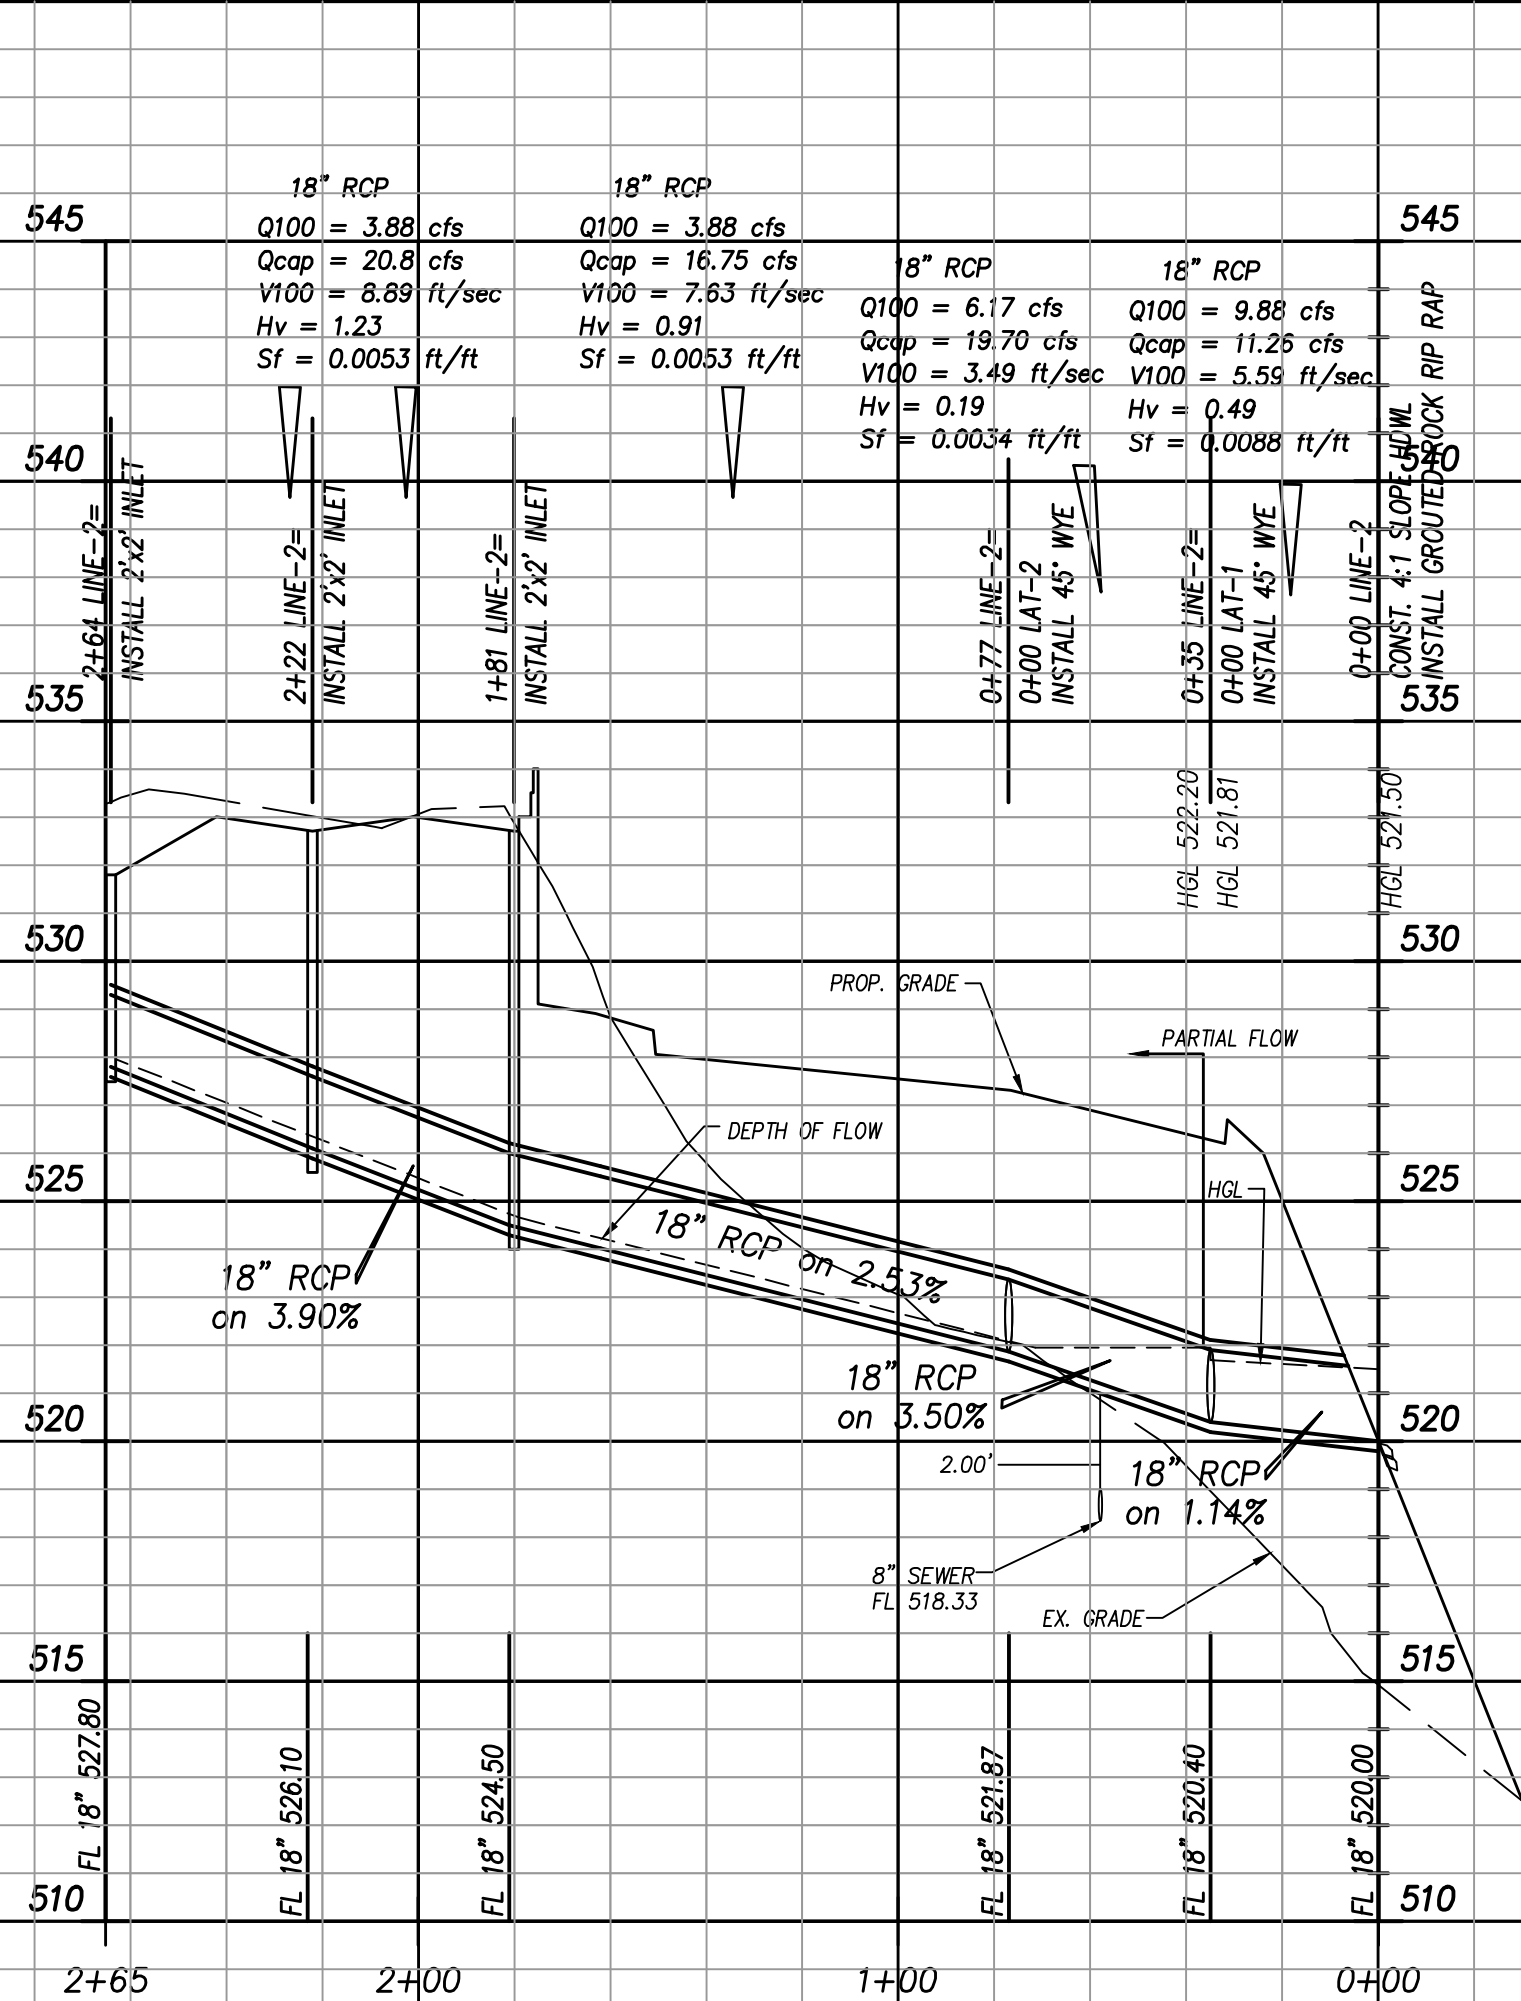



LINE 1

LINE-2 (PRIVATE)


LINE 3

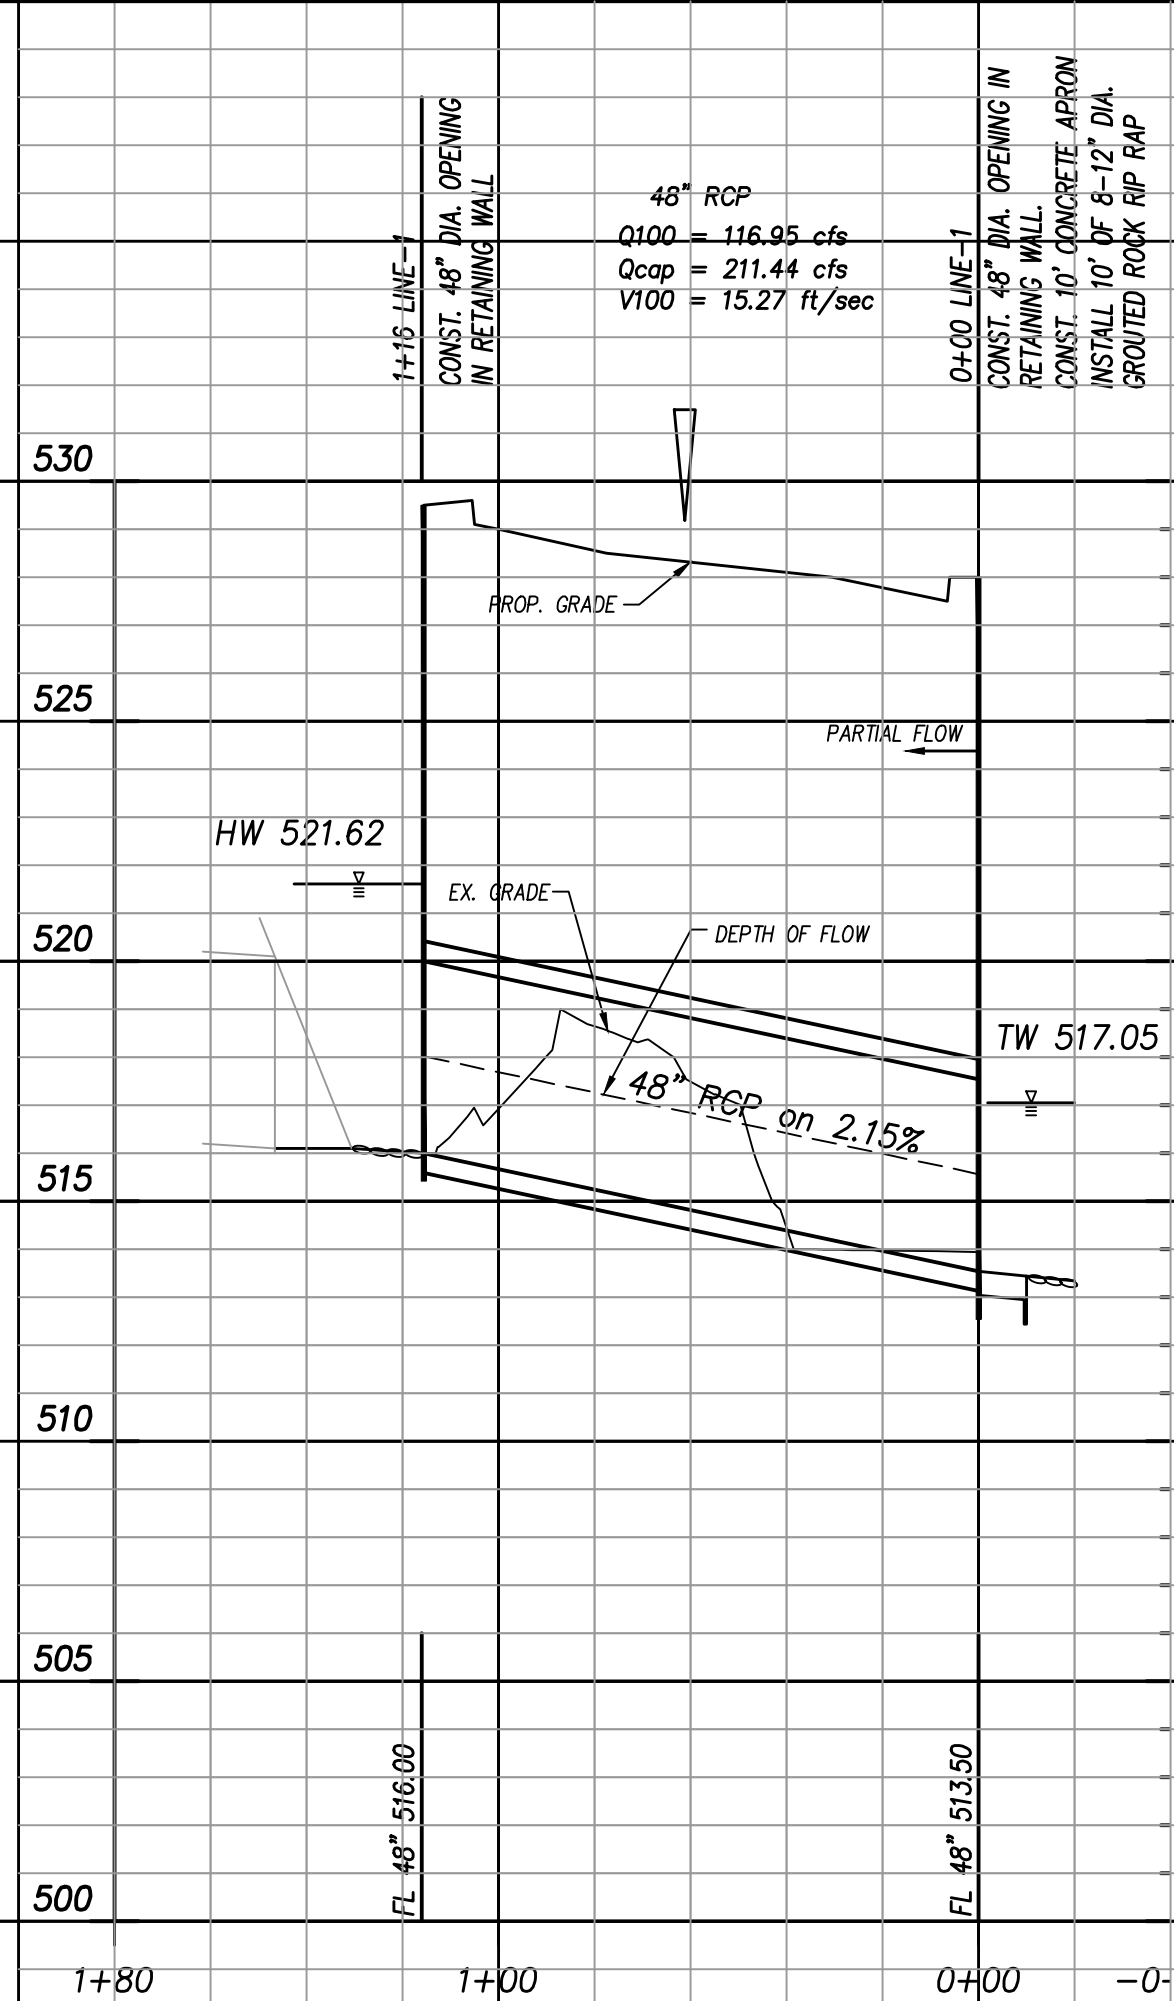



LAT 1 (PRIVATE)

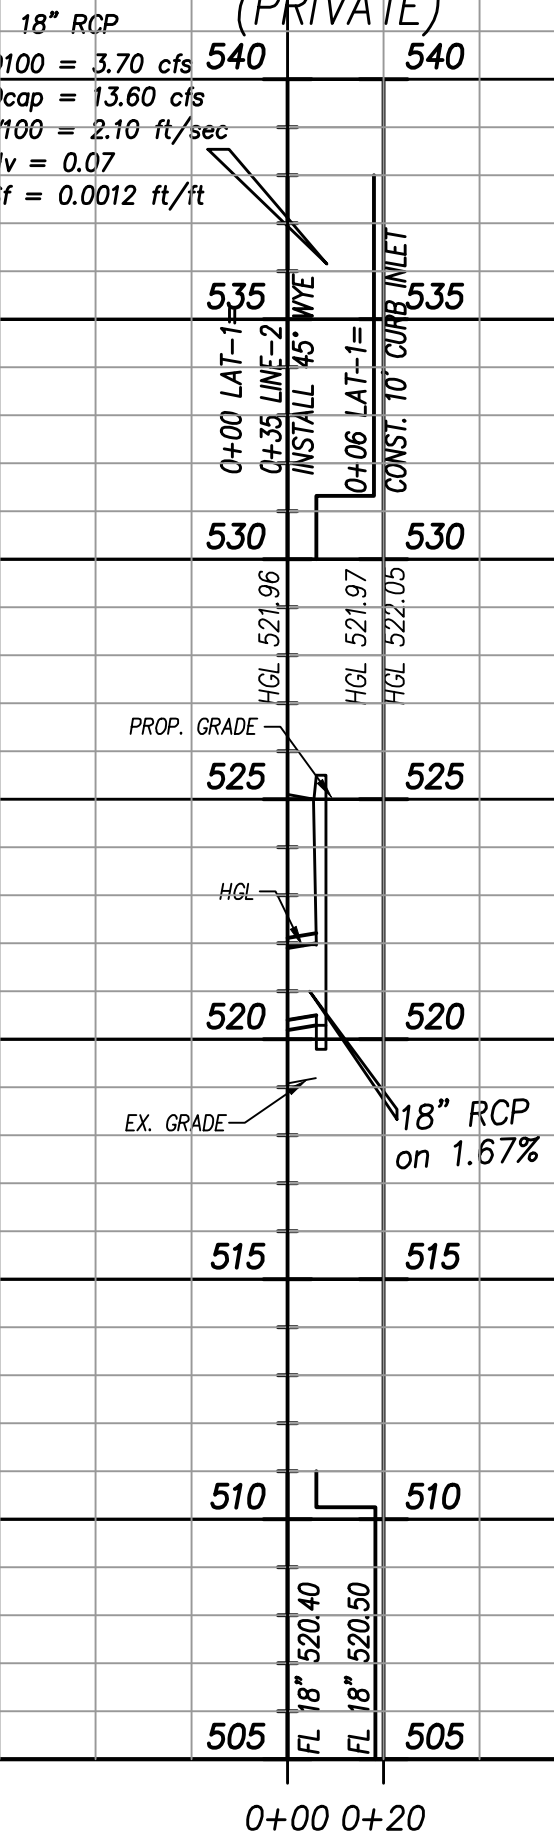

LAT 2 (PRIVATE)

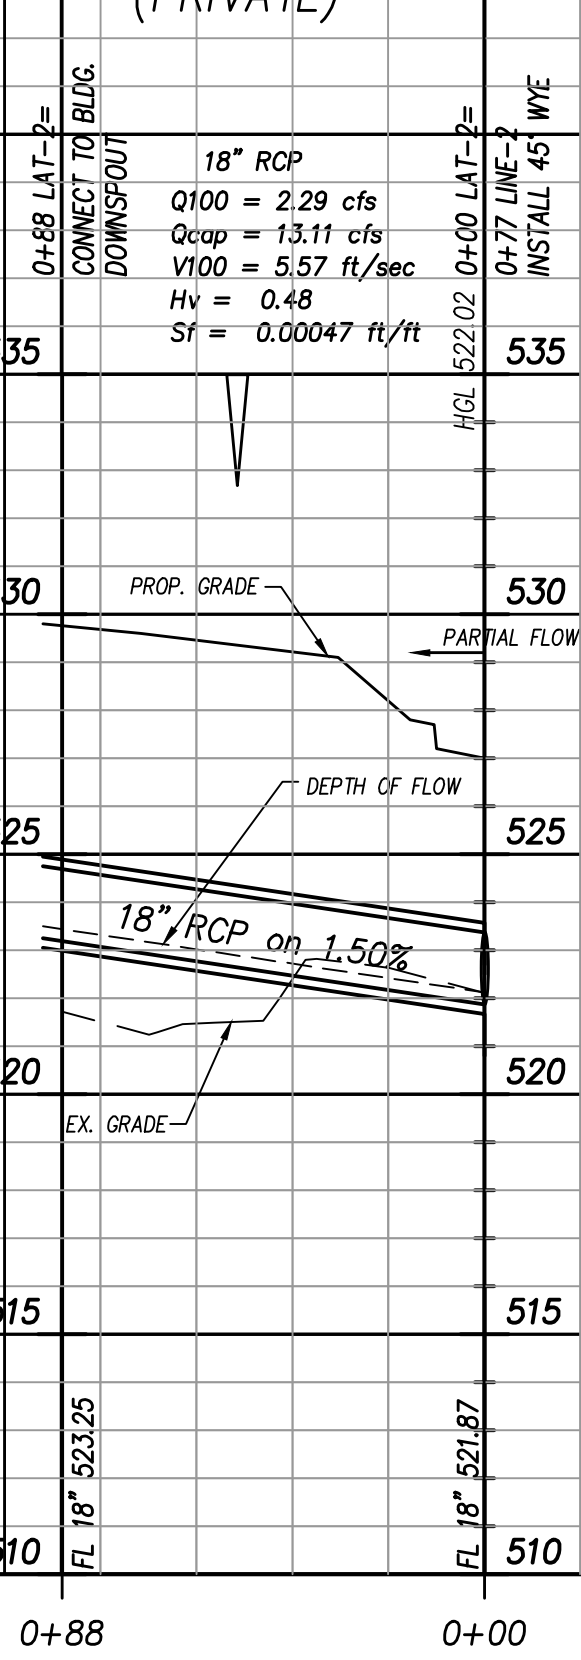


LAT 3 (PRIVATE)

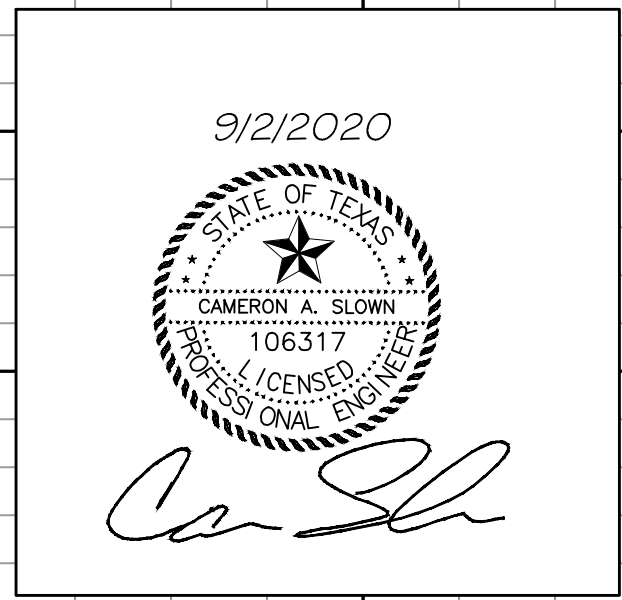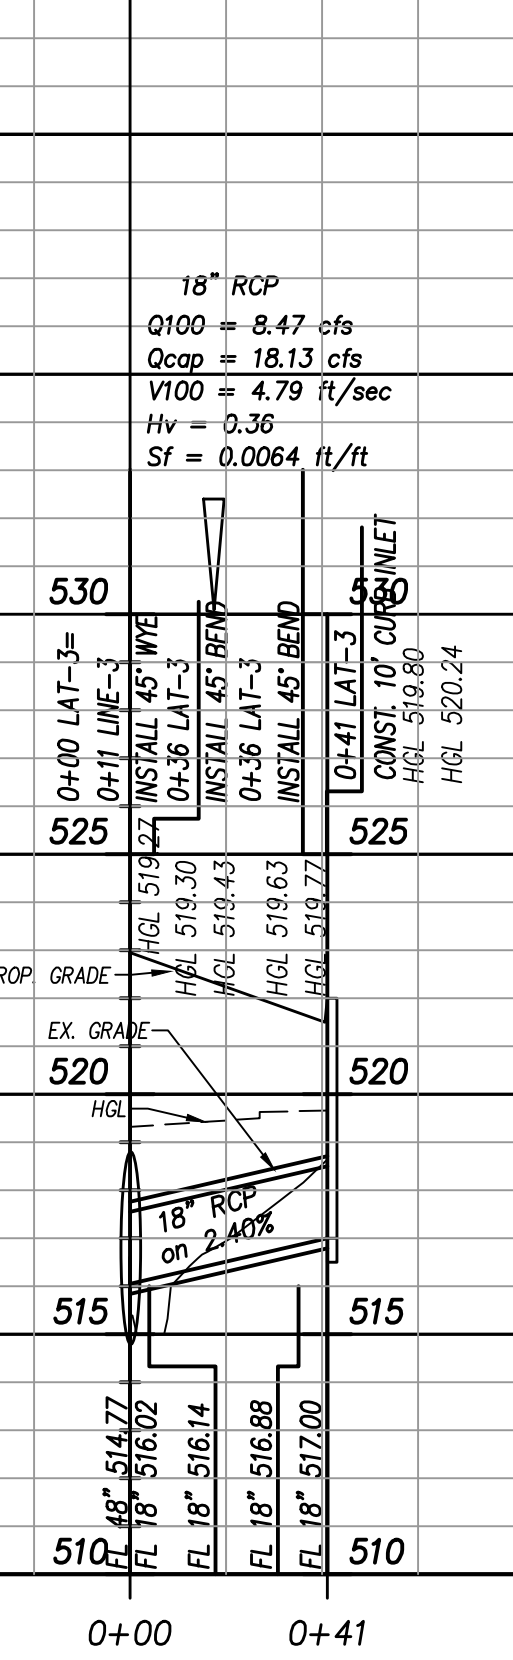

GBA architecture | design

7780 ELMWOOD AVE. STE. 204 MIDDLETON, WI 53562 608-829-1750 608-829-3056 (FAX)

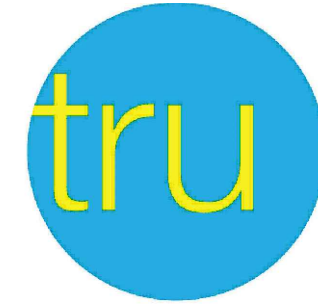

teague nall and perkins, inc
 825 Walters Creek Blvd., Suite M300
 Allen, Texas 75013
 214.461.9867 ph 214.461.9864 fx
 www.inpinco.com
 TBPE: F-230; TBPLS: 10011600, 10011601, 10194381



PROJECT: TRU by HILTON
 2600 SUMMERLEE DRIVE
 ROCKWALL, TEXAS 75087
 CLIENT: MHC Rockwall, LLC.
 1468 KIMBROUGH ROAD, SUITE 103
 GERMANTOWN, TENNESSEE 38138

©2018 GARY BRINK & ASSOC.
 Any duplication, reproduction, or use by any other party is prohibited unless prior written authorization is received from GARY BRINK & ASSOC.

PROJECT: 201709
 DRAWN BY: C.A.S.
 DATE: 9/2/2020
 SCALE: AS NOTED

CASE NO.

STORM SEWER PLAN

RECORD DRAWINGS

C9.1