


FRANCHISE UTILITY CONTACTS	
ELECTRIC CONTACT:	ONCOR ELECTRIC
PHONE:	MARK RUSSELL (469) 502-8663
GAS CONTACT:	ATMOS ENERGY
PHONE:	DINAH WOOD (972) 485-6277
TELEPHONE CONTACT:	AT&T
PHONE:	CHRIS HOLMES (903) 457-2303

NOTE: ALL FIRE HYDRANTS TO HAVE 5' CLEAR SEPARATION FROM ALL OBSTRUCTIONS INCLUDING PARKING SPACES.



RECORD DRAWINGS

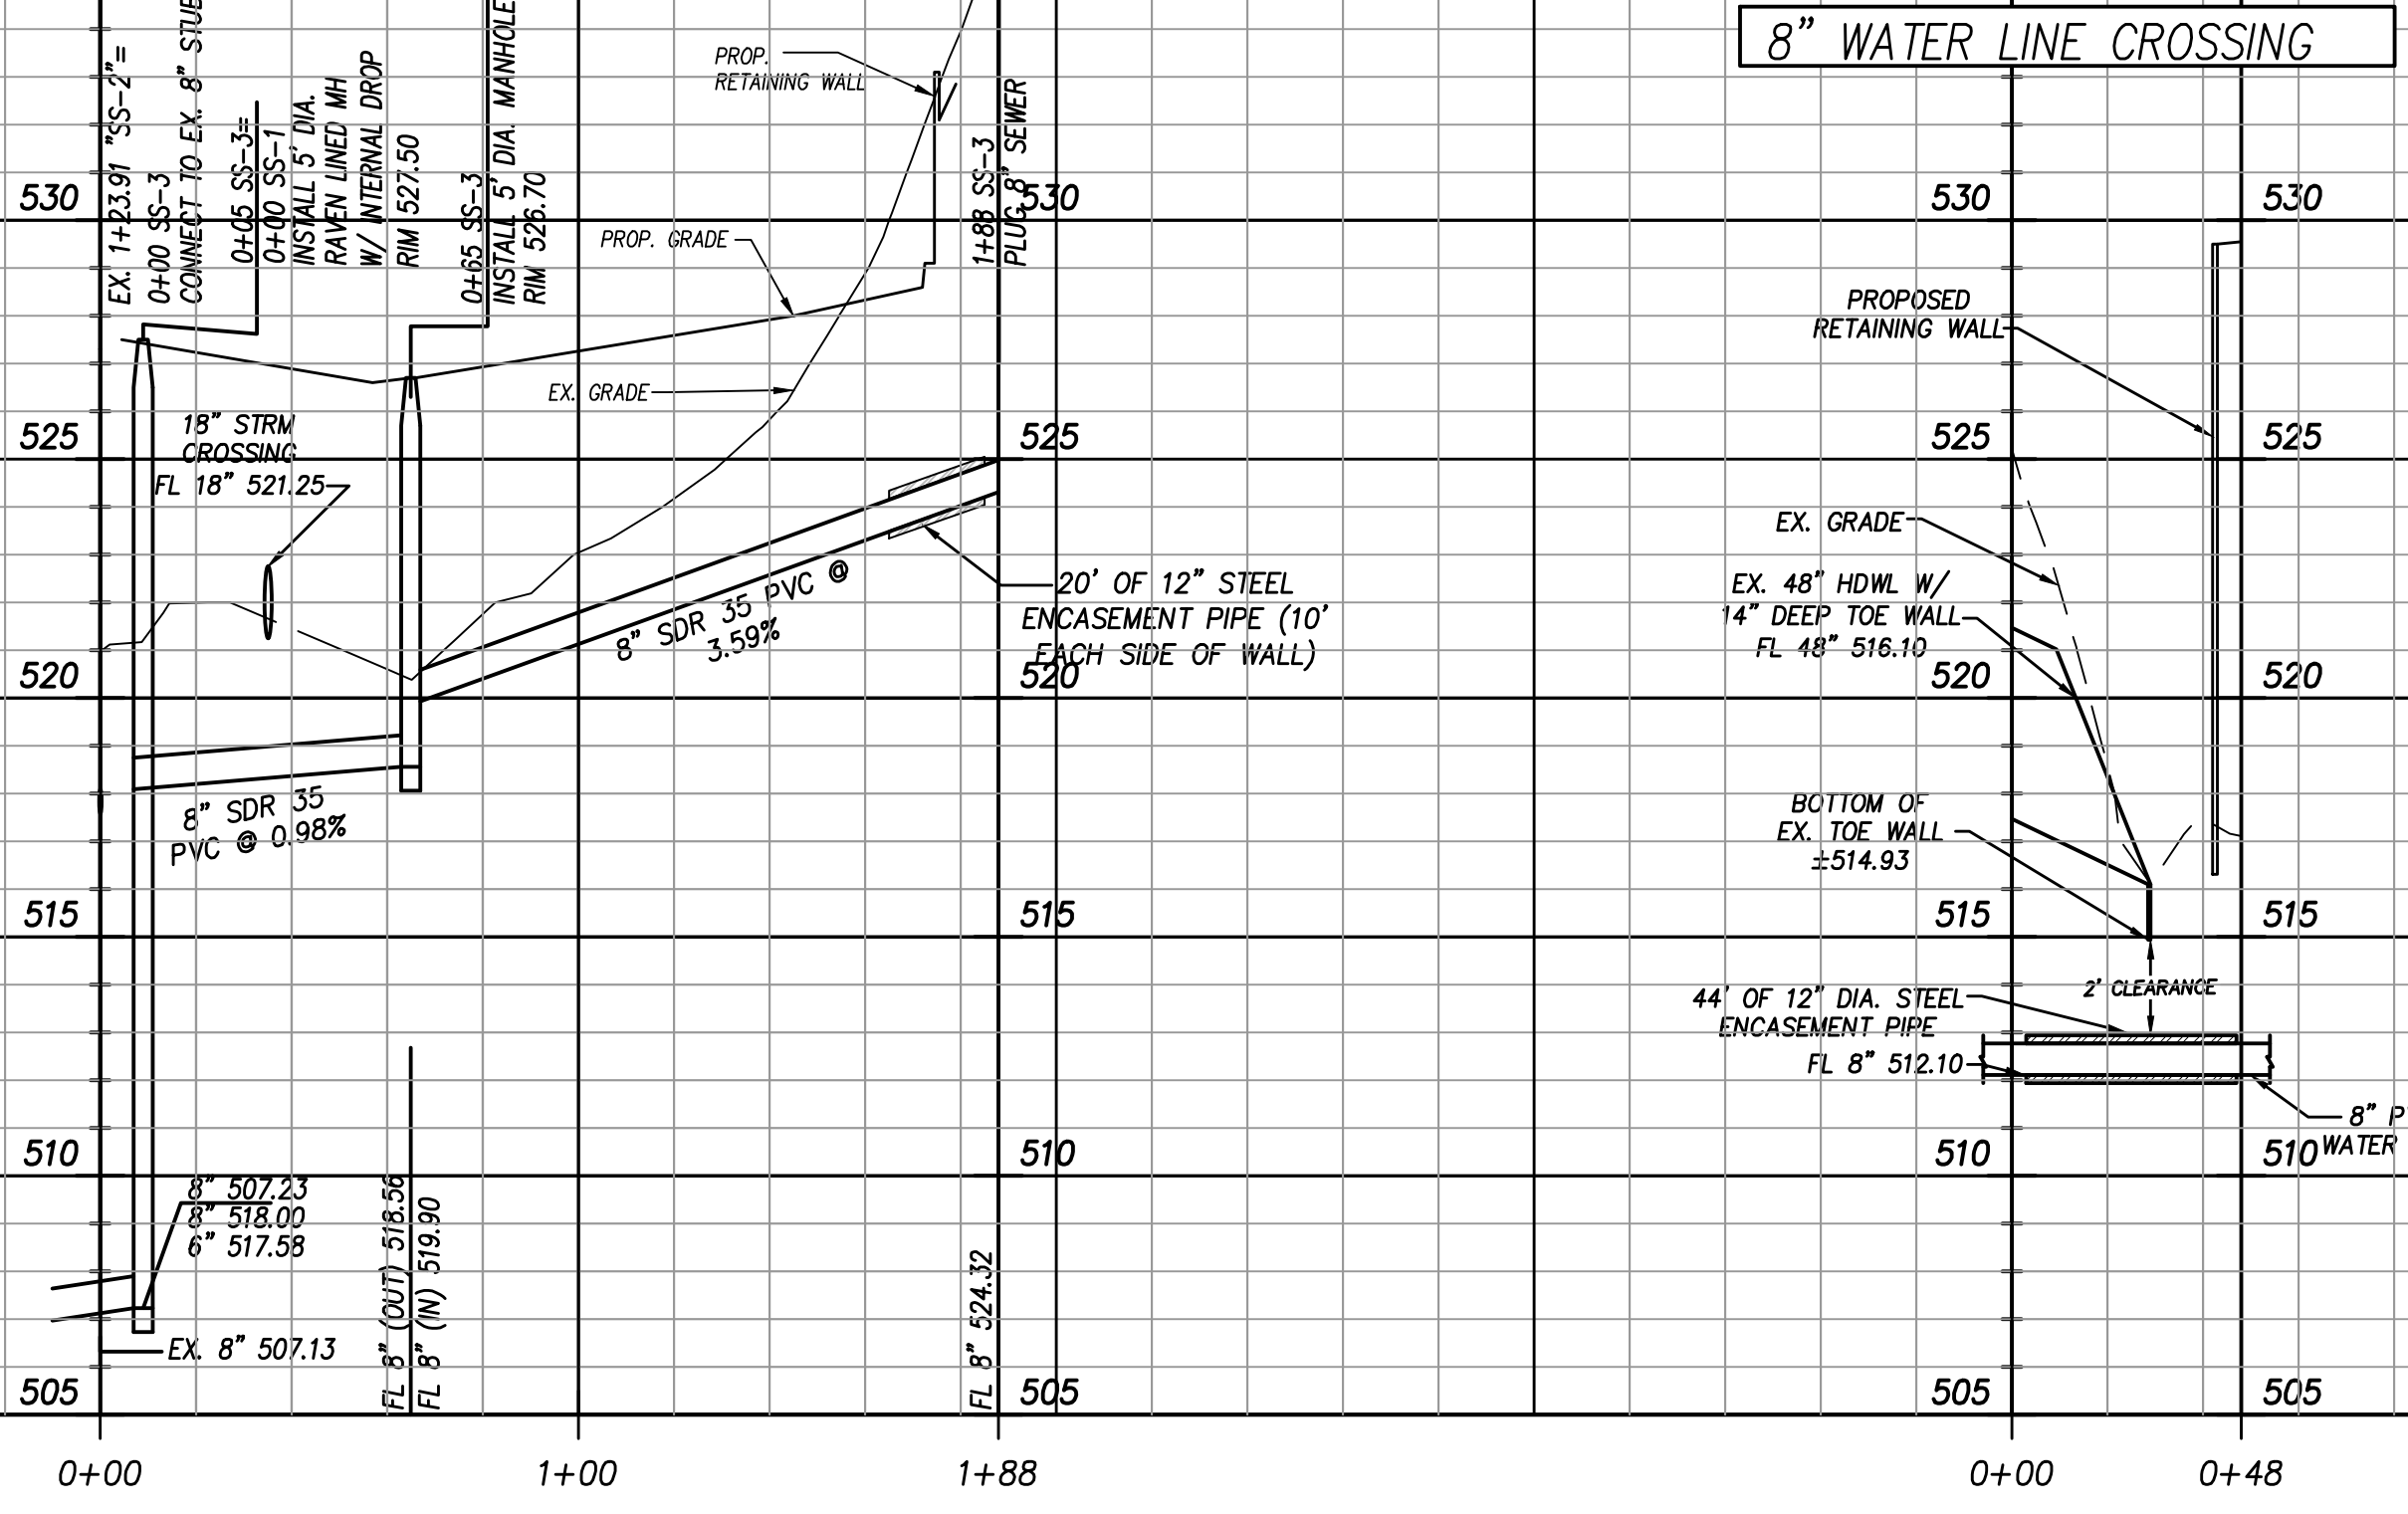

©2018 GARY BRINK & ASSOC.
Any duplication, reproduction, or use by any other party is prohibited unless prior written authorization is received from GARY BRINK & ASSOC.