


RECORD DRAWING  
 DATE: 7-28-00  
 THIS RECORD DRAWING HEREIN REFLECTS TO THE BEST OF THE DESIGN ENGINEER'S KNOWLEDGE THE APPROXIMATE LOCATION OF THE CONSTRUCTED WORK USING INFORMATION AS PROVIDED BY THE CONTRACTOR(S).

- BENCHMARKS:
- SQUARE CUT ON NORTHEAST CURB ± 150' NORTHWEST OF RAILROAD ON TURTLE COVE BOULEVARD ELEV. 469.36
  - SQUARE CUT ON CENTERLINE OF INLET WESTERLY FROM CLUBHOUSE ENTRANCE ELEV. 447.21

NO.	REVISION	BY	DATE

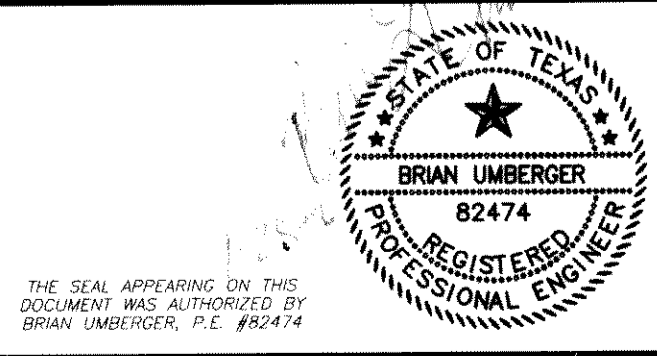

SCALE: AS SHOWN  
 DESIGNED: P.B.S. & J.  
 DRAWN: P.B.S. & J.  
 DATE: \_\_\_\_\_  
 DWG FILE: \_\_\_\_\_

**PBS&J**  
 5999 SUMMERSIDE DRIVE ~ SUITE 202  
 DALLAS, TEXAS 75252  
 PH. (972) 380-2605 FAX (972) 380-2609

**SANITARY SEWER PROFILES**  
 TURTLE COVE ADDITION, PHASE 3  
 CITY OF ROCKWALL  
 ROCKWALL COUNTY, TEXAS

JOB NO. 95115.02  
 SHEET 19 OF 28

TURTLE COVE ADDITION, PHASE 3, SANITARY SEWER PROFILES