

**PAVING LEGEND**

PAVING  
 6" DEPTH 3600 PSI CONCRETE PAVEMENT ON  
 6" SCARIFIED AND COMPACTED SUBGRADE OR  
 PER GEOTECHNICAL REPORT IF THE REPORT  
 REQUIRES MORE. NO SAND UNDER PAVEMENT.  
 6 SACK MIN. FOR MACHINE PLACE  
 8 1/2 SACK MIN. FOR HAND PLACE.

**LEGEND**

— PROPOSED CONTOURS  
 - - - EXISTING CONTOURS


**NOTE:**  
 RETAINING WALL TO BE DESIGNED  
 BY A STRUCTURAL ENGINEER AND  
 INSPECTED BY A DESIGN ENGINEER.  
 THIS DESIGN TO BE BY OTHERS

NO PART OF RETAINING WALL  
 INCLUDING FOOTING, WALL OR  
 TIEBACKS SHALL BE IN AN  
 EASEMENT OR RIGHT-OF-WAY.

**RECORD DRAWING**  
 Mike Allen P. E.  
 DATE: 04-08-08  
*Michael A.*

CONTRACTOR TO ADJUST  
 RIM ELEV. ON EX. SAN.  
 SEWER MANHOLE.

No.	Date	Revisions	App.
1	2-22-07	MOVED ISLAND 1 SPACE NORTH	MSA

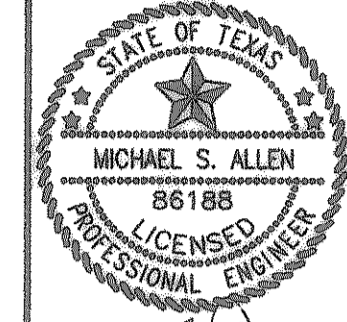

*Michael A.*  
 4/3/08

VISTA LAGO  
 ROCKWALL, TEXAS

GRADING PLAN

Scale: 1"=20'  
 Designed by: MSA  
 Drawn by: MSA  
 Checked by: MSA  
 Date: SEPTEMBER 13, 2006  
 Project No. 069-001

SHEET  
 C-3  
 OF 10

**Allen & Ridinger Consulting, Inc.**  
 Tel. No. (972) 363-8000  
 Fax No. (972) 363-8011  
 285 W. Southeast Pkwy  
 Lewisville, Texas 75067