

MELVIN HURDLE
VOL. 725, PG. 262, D.R.R.C.T.

APPROX. 115 L.F. METAL BEAM
GUARD FENCE, TxDOT STD.
DETAIL GF (TD) - 87
W/ STEEL LINE POST
CONNECTION TO TOP OF
RETAINING WALL.

EXTENDED DEPTH CURB

10' STORM INLET
T/W 39.48
B/W 34.48
FL 534.48

5" CONC. P.V.M.T. W/
FIBER MESH REINF.
LINE STABILIZED
SUBGRADE

ROBERT THOMAS
VOL. 175, PG. 863, D.R.R.C.T.

14' X 20' DUMPSTER PAD
5" 3000 PSI CONC. W/
#4 @ 24" O.C.

14' X 20' DUMPSTER PAD
5" 3000 PSI CONC. W/
#4 @ 24" O.C.


INTERSTATE HIGHWAY 30
(VARIABLE WIDTH R.O.W.)

--- DRAINAGE AREA DIVIDE
A AREA NUMBER
0.31 ACREAGE


AREA	ACRES	C	i ₂₅	Q ₂₅	i ₁₀₀	Q ₁₀₀
A	0.31	0.9	9.2	2.57	11.5	3.21
B	0.48	0.9	9.2	3.97	11.5	4.97

NO.	DATE	REVISIONS

DATE	WAFFLE HOUSE APPROVALS	SIGNATURE

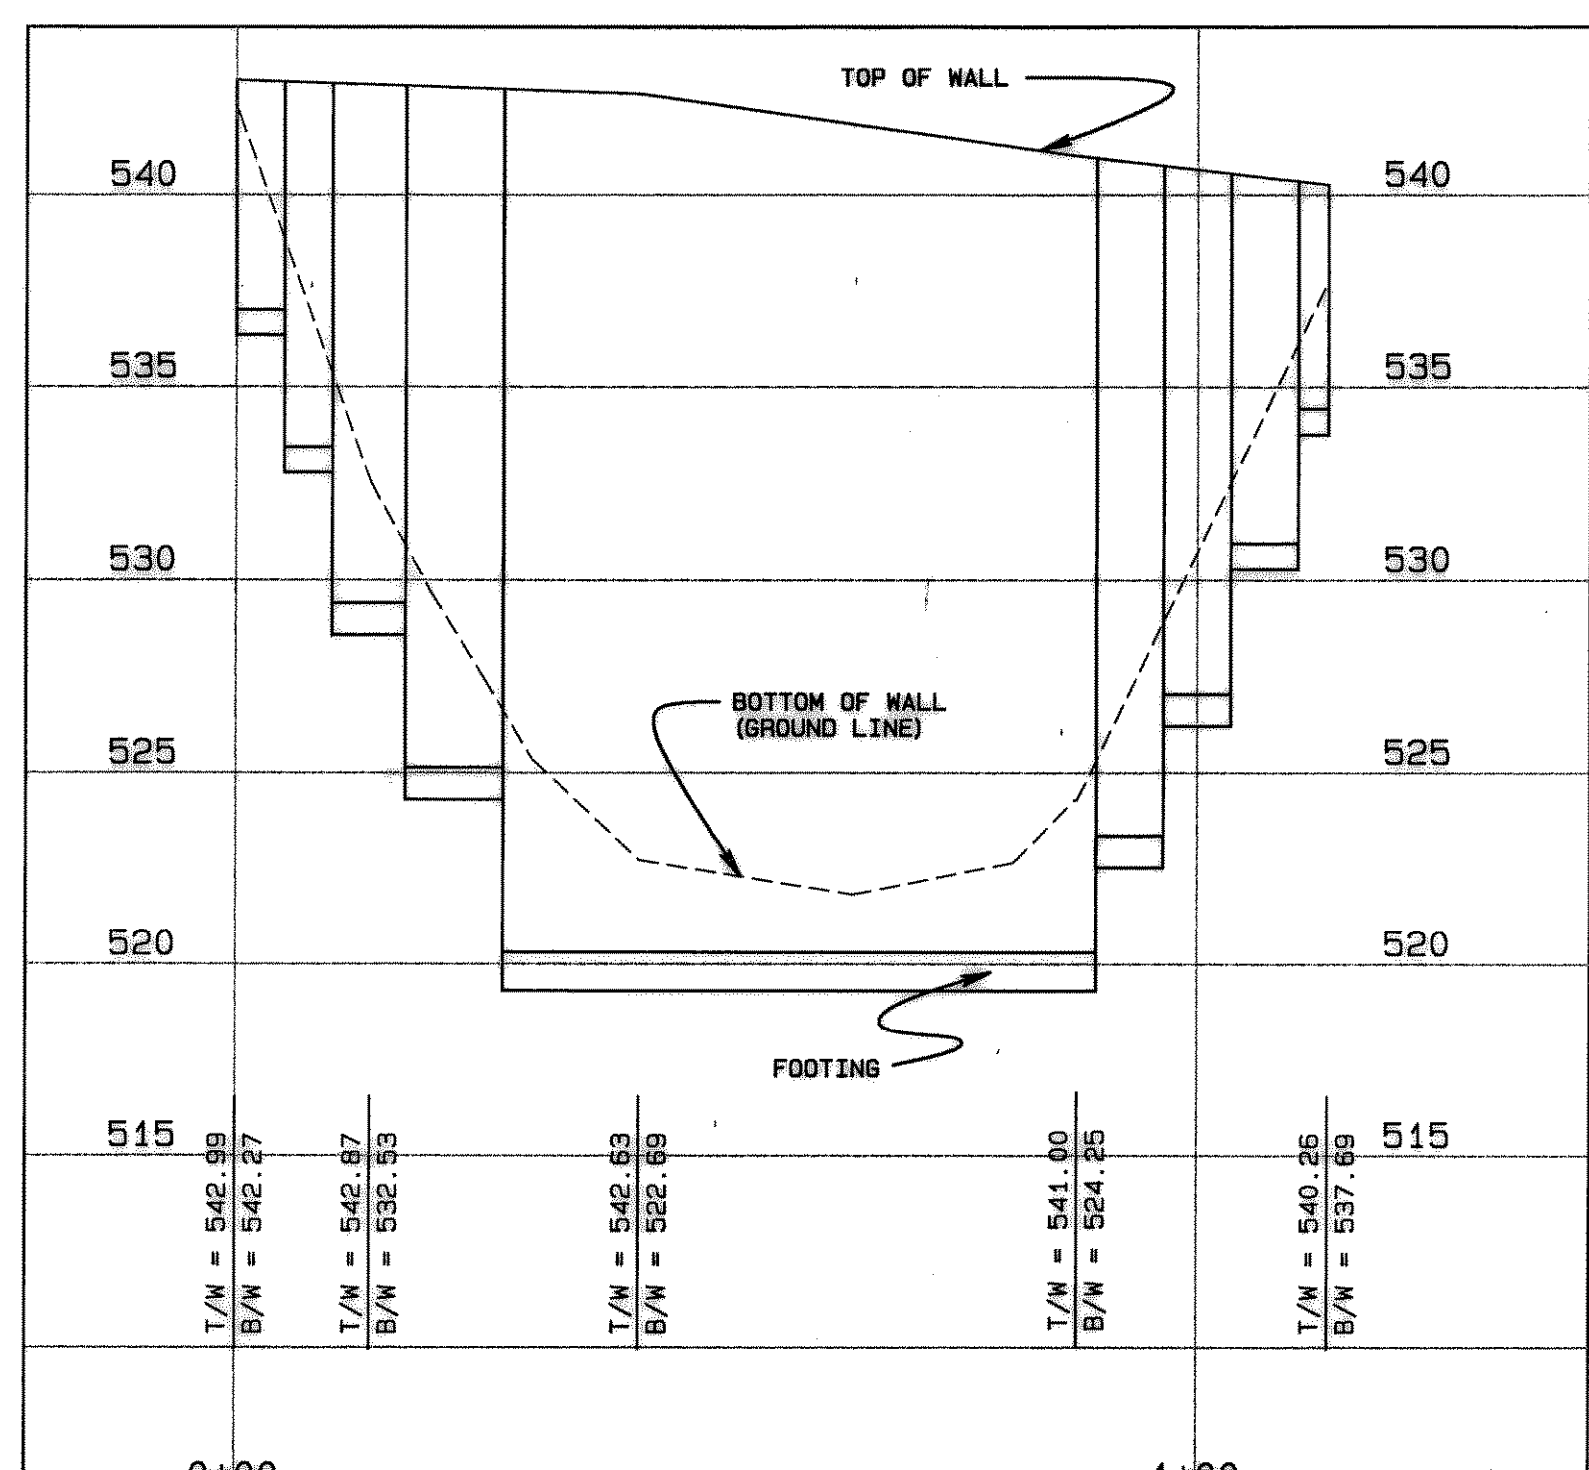


RETAINING WALL ELEVATION
1" = 20' H.
1" = 5' V.


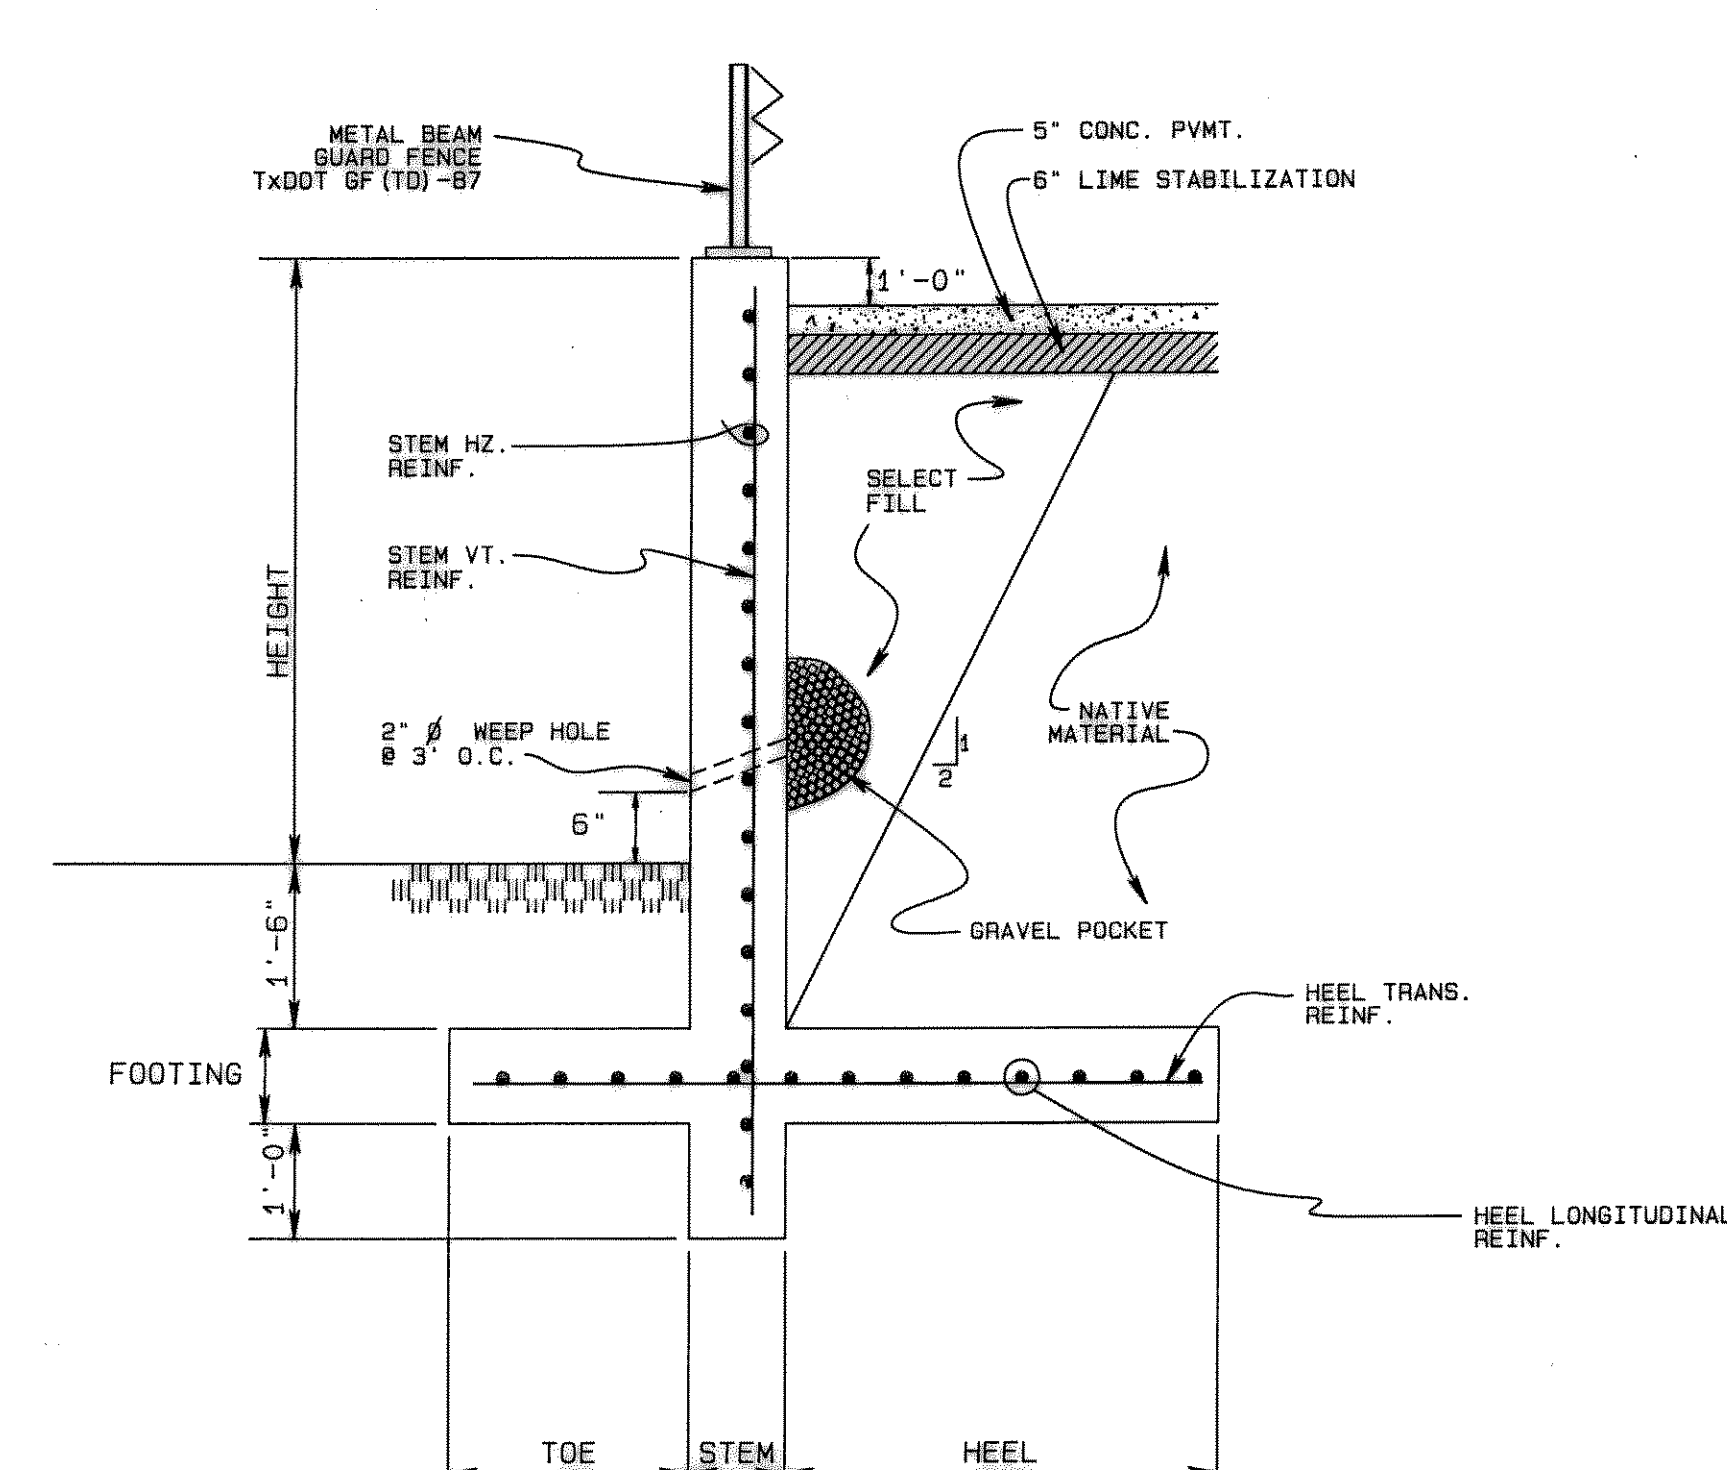


TYPICAL WALL SECTION

MAX. WALL HEIGHT (FT)	4	8	12	16	20
STEM THICKNESS (IN)	10	10	12	12	12
FOOTING THICKNESS (IN)	8	8	10	10	12
TOE (IN)	1.5	2.5	3	3.5	4
HEEL (IN)	1.5	2.5	3.5	5.5	8
HEEL, TRANS. REINF.	#4@12"	#5@9"	#5@6"	#6@9"	#6@6"
HEEL, LONG. REINF.	4-#4	4-#5	5-#5	5-#5	6-#5
STEM, VERT. REINF.	#4@12"	#5@9"	#5@6"	#6@6"	#7@6"
STEM, HZ. REINF.	#4@12"	#5@15"	#5@12"	#5@10"	#5@8"

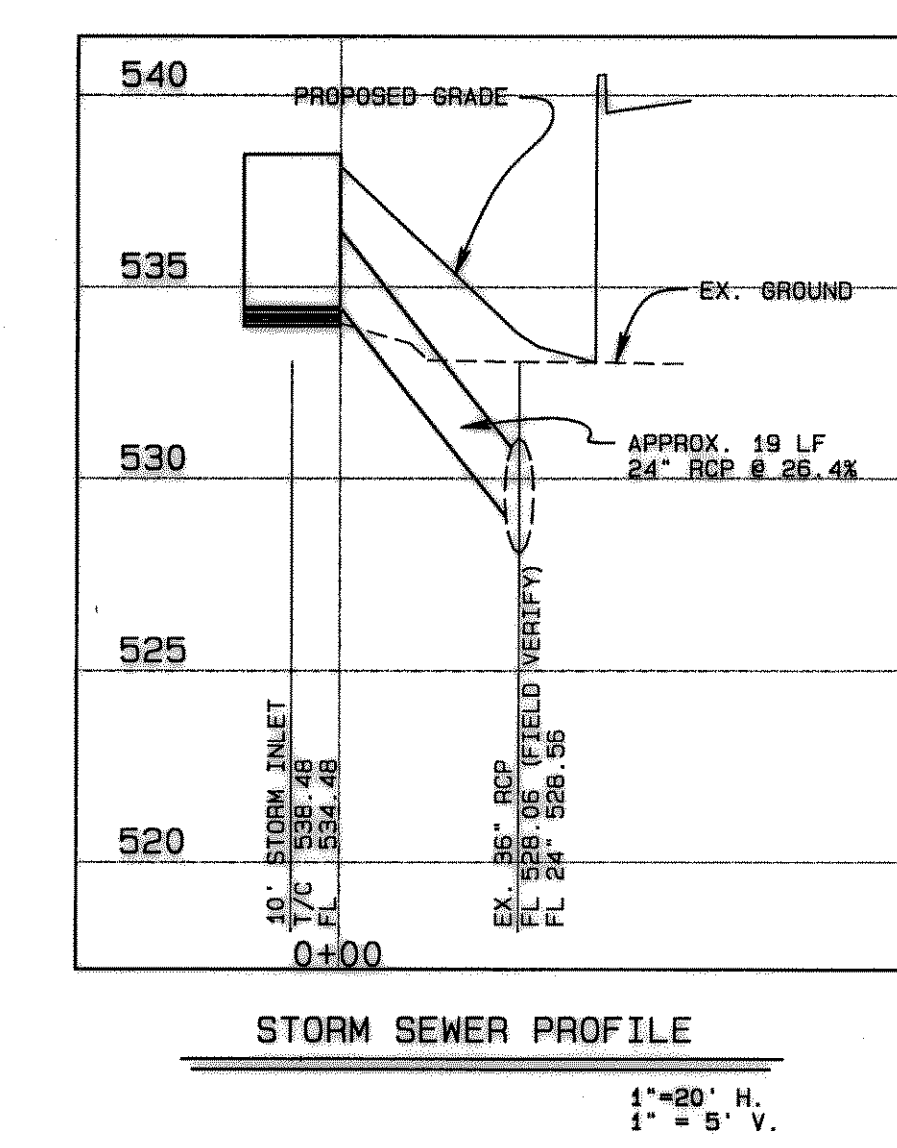

STORM SEWER PROFILE
1" = 20' H.
1" = 5' V.

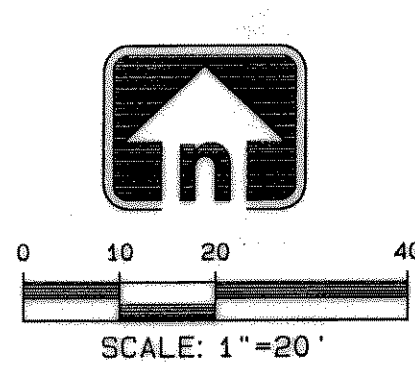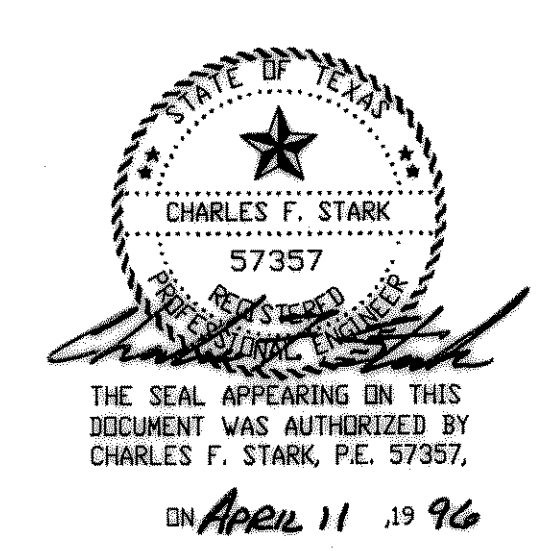

GRADING PLAN

WAFFLE HOUSE ADDITION
PART OF I-30/740
ADDITION

CITY OF ROCKWALL
ROCKWALL COUNTY, TEXAS

WAFFLE HOUSE
GOOD FOOD FAST
P.O. BOX 6450, NORCROSS, GA. 30091
EXECUTIVE OFFICES:
5986 FINANCIAL DRIVE
NORCROSS, GA. 30071
(770) 729-5700

G Graham Associates, Inc.
CONSULTING ENGINEERS & PLANNERS
616 SIX FLAGS DRIVE, SUITE 400
ARLINGTON, TEXAS 76011 (817) 640-8535
Drawn By: JPK Sheet: 2 OF 2

Date: JAN., 1996
File: 9806-1007