


Science & Technology Inc.

Waggoner Gardens Inc.

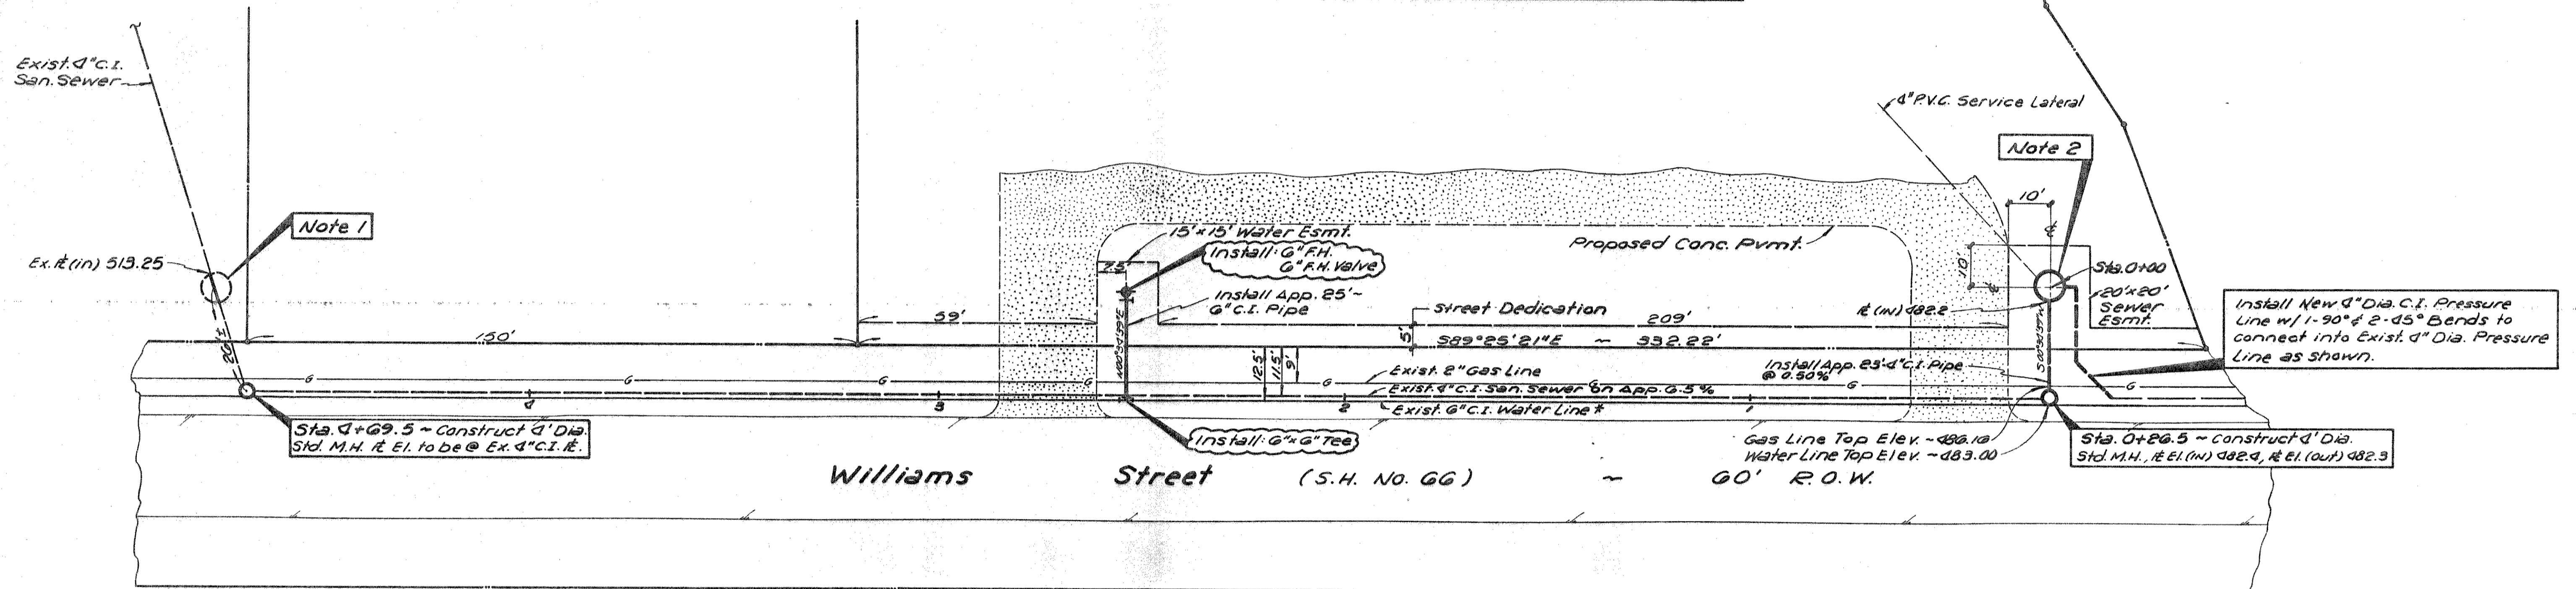


# Plan

Scale: 1" = 20'

\*Note: 6" Dia. C.I. Water to be Relocated as necessary @ New Manhole Locations.

### Notes:

- 1) Remove Present Conc. Pipe Well. Discard Exist. Siphon. Connect Exist. 4" C.I. to Exist. 4" inlet w/ New 4" C.I. Pipe, including Joints.
- 2) Relocate Exist. Conc. Well to this location. Install One Pump Furnished by City of Rockwall. Install One Pump Furnished by the Developer. Install Limit Switches & Control Panel Furnished by the City of Rockwall.
- 3) Pumps are HYDR-O-Matic Simplex Model SDN300M2-D-3HP. Limit Switches, Gate Valves and All other Lift Station Components Hydr-O-Matic or Equal.
- 4) Such Components as available from City of Rockwall shall be used.
- 5) All City of Rockwall Standards shall Apply.

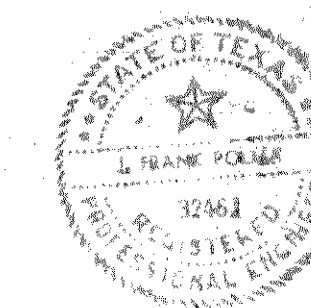

Waggoner Gardens Add'n.

Sanitary Sewer & Water Plan

Rockwall, Texas

R-Delta Engineers Inc. - Garland, TX

Des: JFP RDE Job: 40985

DR: FAP Scale: AS NOTED Sht. 1 of 1

ch: JFP Date: 02/09/95