



SANITARY SEWER PROFILE "A"

SCALE: 1" = 50' (H)  
1" = 5' (V)

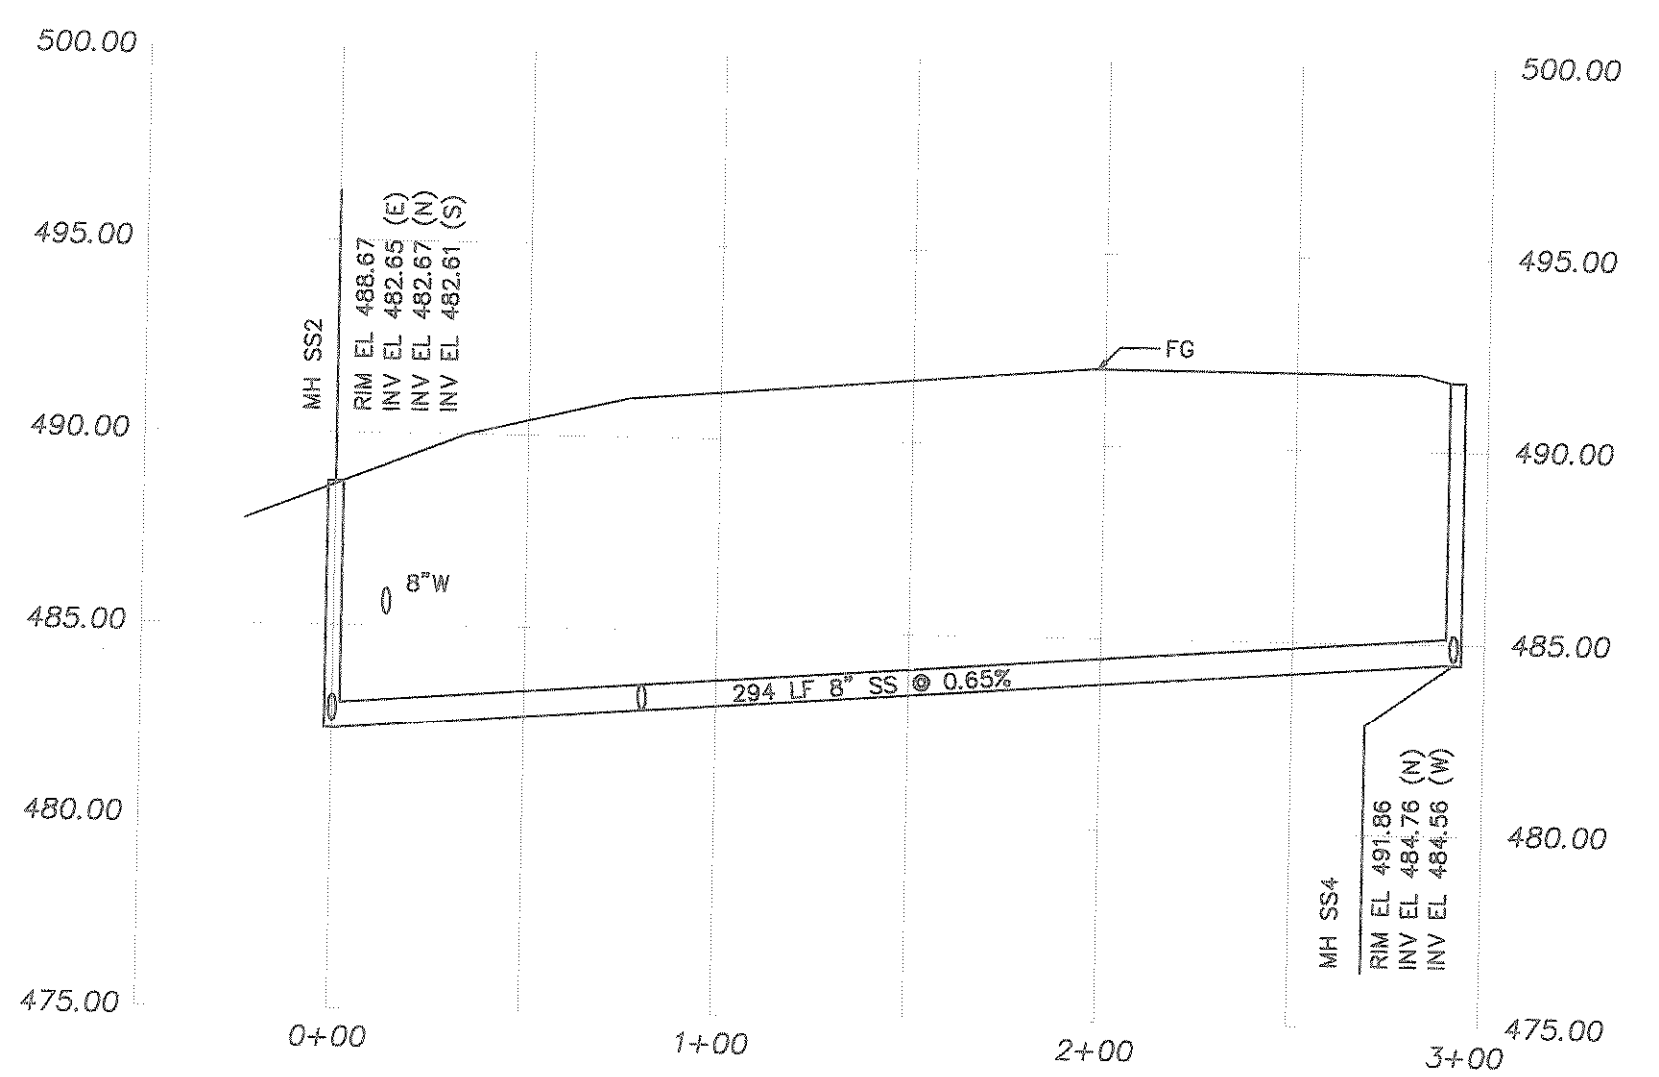

SANITARY SEWER PROFILE "B"

SCALE: 1" = 50' (H)  
1" = 5' (V)

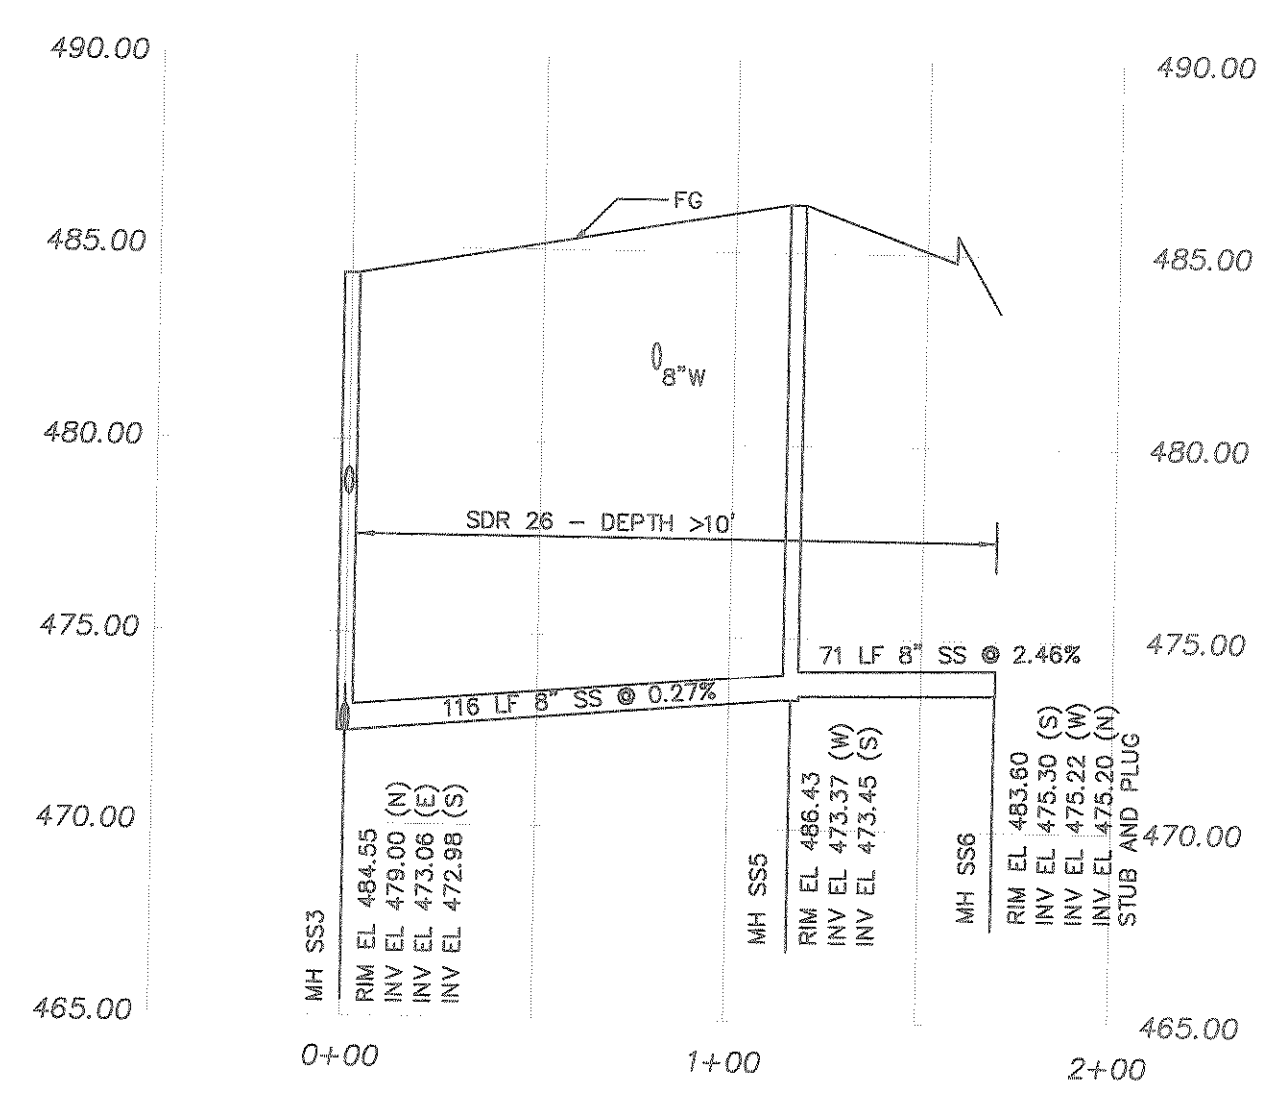

SANITARY SEWER PROFILE "C"

SCALE: 1" = 50' (H)  
1" = 5' (V)

RECORD DRAWING BASED ON SURVEY INFORMATION PROVIDED BY JOHN VICAIN, P.L.S. #4097, AND DRAWINGS PROVIDED BY THE CONTRACTOR.

- BENCHMARKS:
- 1.) CITY OF ROCKWALL CONTROL MONUMENTATION MONUMENT #R012 - ELEV. 593.85.
  - 2.) SQUARE CUT ON MEDIAN NOSE OF NORTH LAKESHORE DRIVE APPROXIMATELY 500' NORTH OF STATE HIGHWAY 66 - ELEV. 474.35.
  - 3.) SQUARE CUT ON MEDIAN NOSE OF NORTH LAKESHORE DRIVE APPROXIMATELY 900' NORTH OF STATE HIGHWAY 66 - ELEV. 487.99

No.	Date	Revisions	App.

Kimley-Horn and Associates, Inc.  
12700 Park Central Drive, Suite 1800  
Dallas, Texas 75251  
Tel. No. (972) 770-1300  
Fax No. (972) 239-3820

WAL-MART ROCKWALL, TX  
STORE #3530-00, NewNM  
S.H. 66 & N. LAKE SHORE DR. SITE

SANITARY SEWER PROFILES  
(RECORD DRAWING)

Scale:	AS SHOWN
Designed by:	FRB
Drawn by:	TDK
Checked by:	JRH
Date:	FEBRUARY 13, 2002
Project No.:	067811010