



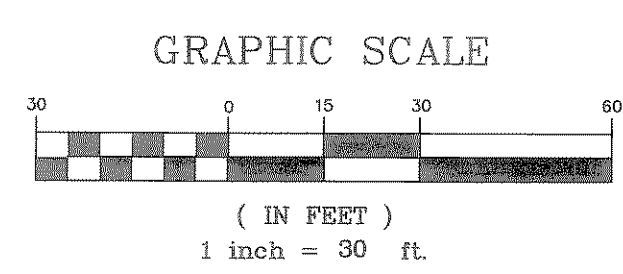

No.	Date	Revisions	App.

**Kimley-Horn
and Associates, Inc.**
12700 Park Central Drive, Suite 1800
Dallas, Texas 75251
Tel. No. (972) 770-1300
Fax No. (972) 239-3920

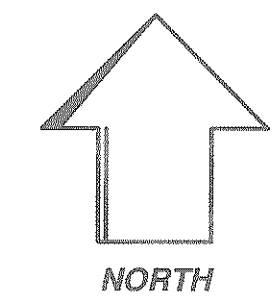

**WAL-MART ROCKWALL, TX
STORE #3530-00, NewNM
S.H. 66 & N. LAKE SHORE DR. SITE**

**GRADING PLAN
(RECORD DRAWING)**

RECORD DRAWING BASED ON SURVEY INFORMATION PROVIDED BY JOHN VICAIN, P.L.S. #4097, AND DRAWINGS PROVIDED BY THE CONTRACTOR.

SEE SHEET 4B

- LEGEND:**
- IRF = IRON ROD FOUND
 - IRS = IRON ROD SET
 - TP = TOP OF PAVEMENT
 - NG = NATURAL GROUND
 - GB = GRADE BREAK
 - TOP = TOP OF SLOPE
 - TOE = TOE OF SLOPE
 - HW = HEAD WALL
 - IN = INLET
 - FL = FLOW LINE
 - STMH = STORM SEWER MANHOLE
 - BC = BACK OF CURB
 - BC PC = BACK OF CURB POINT OF CURVE
 - BCPI = BACK OF CURB POINT OF INTERSECTION
 - BC POC = BACK OF CURB POINT ON CURVE
 - BCPT = BACK OF CURB POINT OF TANGENCY
 - SW EOC = SIDEWALK EDGE OF CONCRETE

- BENCHMARKS:**
- 1.) CITY OF ROCKWALL CONTROL MONUMENTATION MONUMENT #R012 - ELEV. 593.85.
 - 2.) SQUARE CUT ON MEDIAN NOSE OF NORTH LAKESHORE DRIVE APPROXIMATELY 500' NORTH OF STATE HIGHWAY 66 - ELEV. 474.35.
 - 3.) SQUARE CUT ON MEDIAN NOSE OF NORTH LAKESHORE DRIVE APPROXIMATELY 900' NORTH OF STATE HIGHWAY 66 - ELEV. 487.99

Scale: 1" = 30'
Designed by: FRB
Drawn by: TDK
Checked by: JRH
Date: FEBRUARY 13, 2002
Project No. 067811010

C-4A