


LINE "C" - STORM PROFILE  
 1"=50' (H)  
 1"=5' (V)

0+05.22 LAT "D14"  
 CONST. 10" C.I.  
 RIM EL = 484.40  
 FL = 479.10

RECORD DRAWING  
 INFORMATION CLOUED

RECORD DRAWING BASED ON SURVEY INFORMATION  
 PROVIDED BY JOHN VICAIN, P.L.S. #4097, AND DRAWINGS  
 PROVIDED BY THE CONTRACTOR.

- BENCHMARKS:
- CITY OF ROCKWALL CONTROL MONUMENTATION MONUMENT #R012 - ELEV. 593.85.
  - SQUARE CUT ON MEDIAN NOSE OF NORTH LAKESHORE DRIVE APPROXIMATELY 500' NORTH OF STATE HIGHWAY 66 - ELEV. 474.35.
  - SQUARE CUT ON MEDIAN NOSE OF NORTH LAKESHORE DRIVE APPROXIMATELY 900' NORTH OF STATE HIGHWAY 66 - ELEV. 487.99

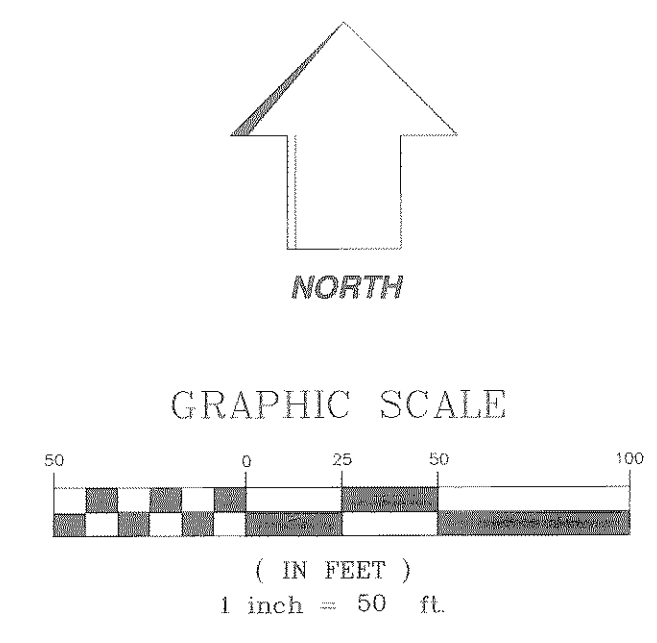

No.	Date	Revisions	App.

**Kimley-Horn and Associates, Inc.**  
 12700 Park Central Drive, Suite 1800  
 Dallas, Texas 75251  
 Tel. No. (972) 770-1300  
 Fax No. (972) 259-3520

**WAL-MART ROCKWALL, TX**  
**STORE #3530-00, NewNM**  
**S.H. 66 & N. LAKE SHORE DR. SITE**

**STORM DRAINAGE PLAN**  
**STORM DRAINAGE PROFILES**  
**(RECORD DRAWING)**

Scale: 1" = 50'

Designed by:	FRB
Drawn by:	TBK
Checked by:	JRH
Date:	FEBRUARY 13, 2002

Project No. 06781010