




ACCESSION # 4 REVISED PIPE DIAMETER AND/OR SLOPES
 07/12/95 P.A. CITY ENGINEER

REVISIONS	BY	REVISIONS	BY
NOV 16, 1995 (OTB)	R.D.M.		
DEC 1, 1995 (OTB)	D.J.C.		
DEC 21, 1995	D.J.C.		

DESIGNED	R.D.M.
DRAWN	R.D.M.
CHECKED	D.J.A.

WALMART SUPERCENTER
C-188-SGL-OL A


STORE NO. 259
 APPROX. 202,588 S.F.
 F.F. ELEV. 544.00

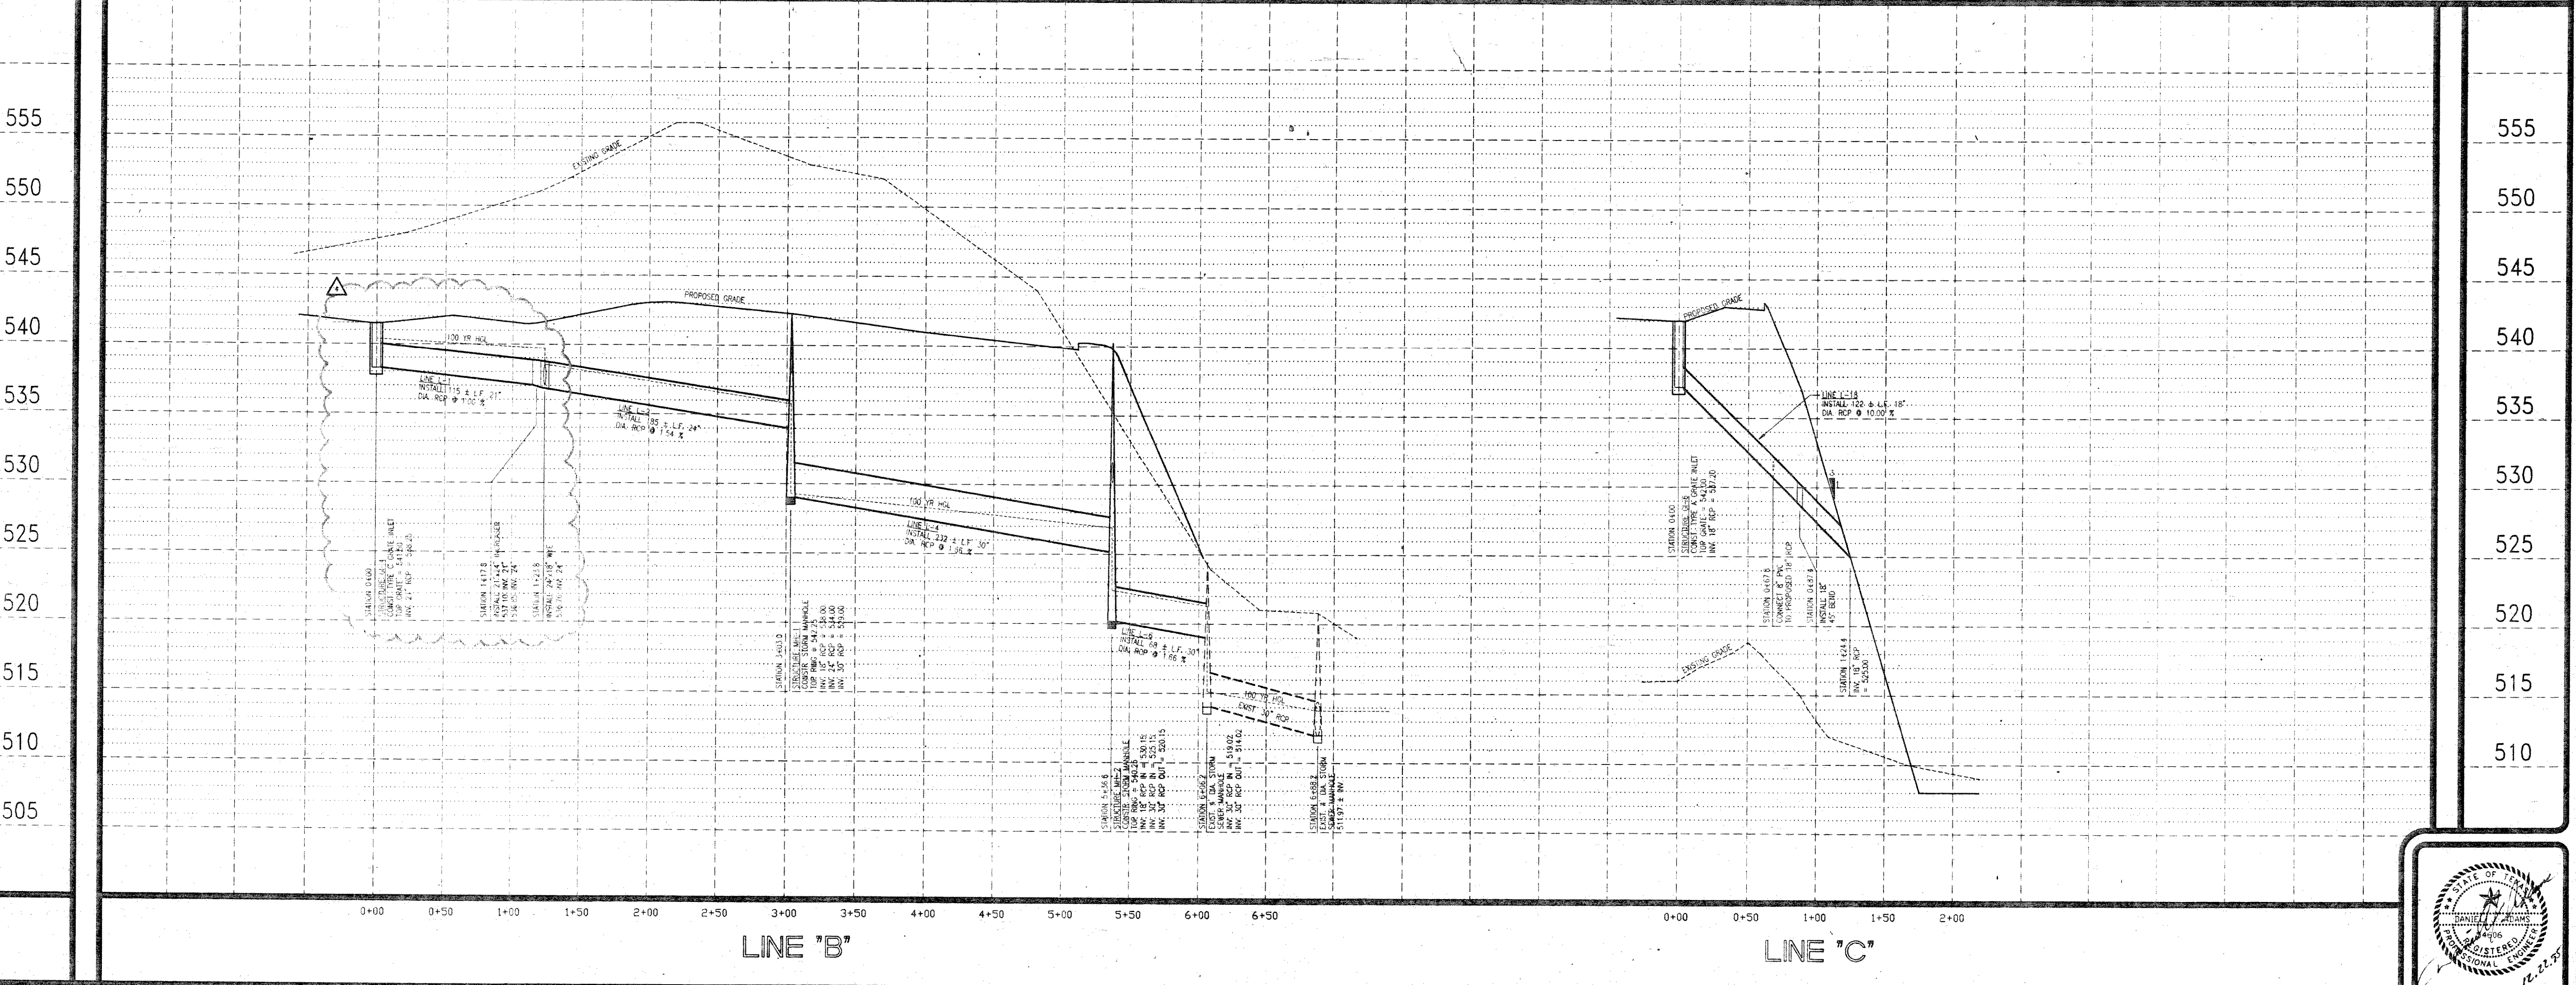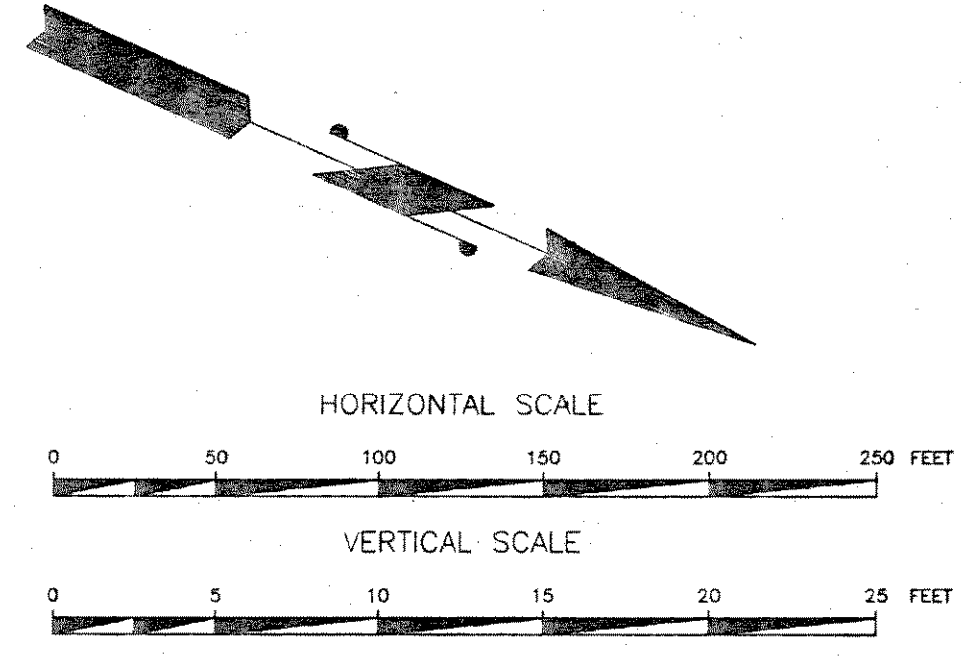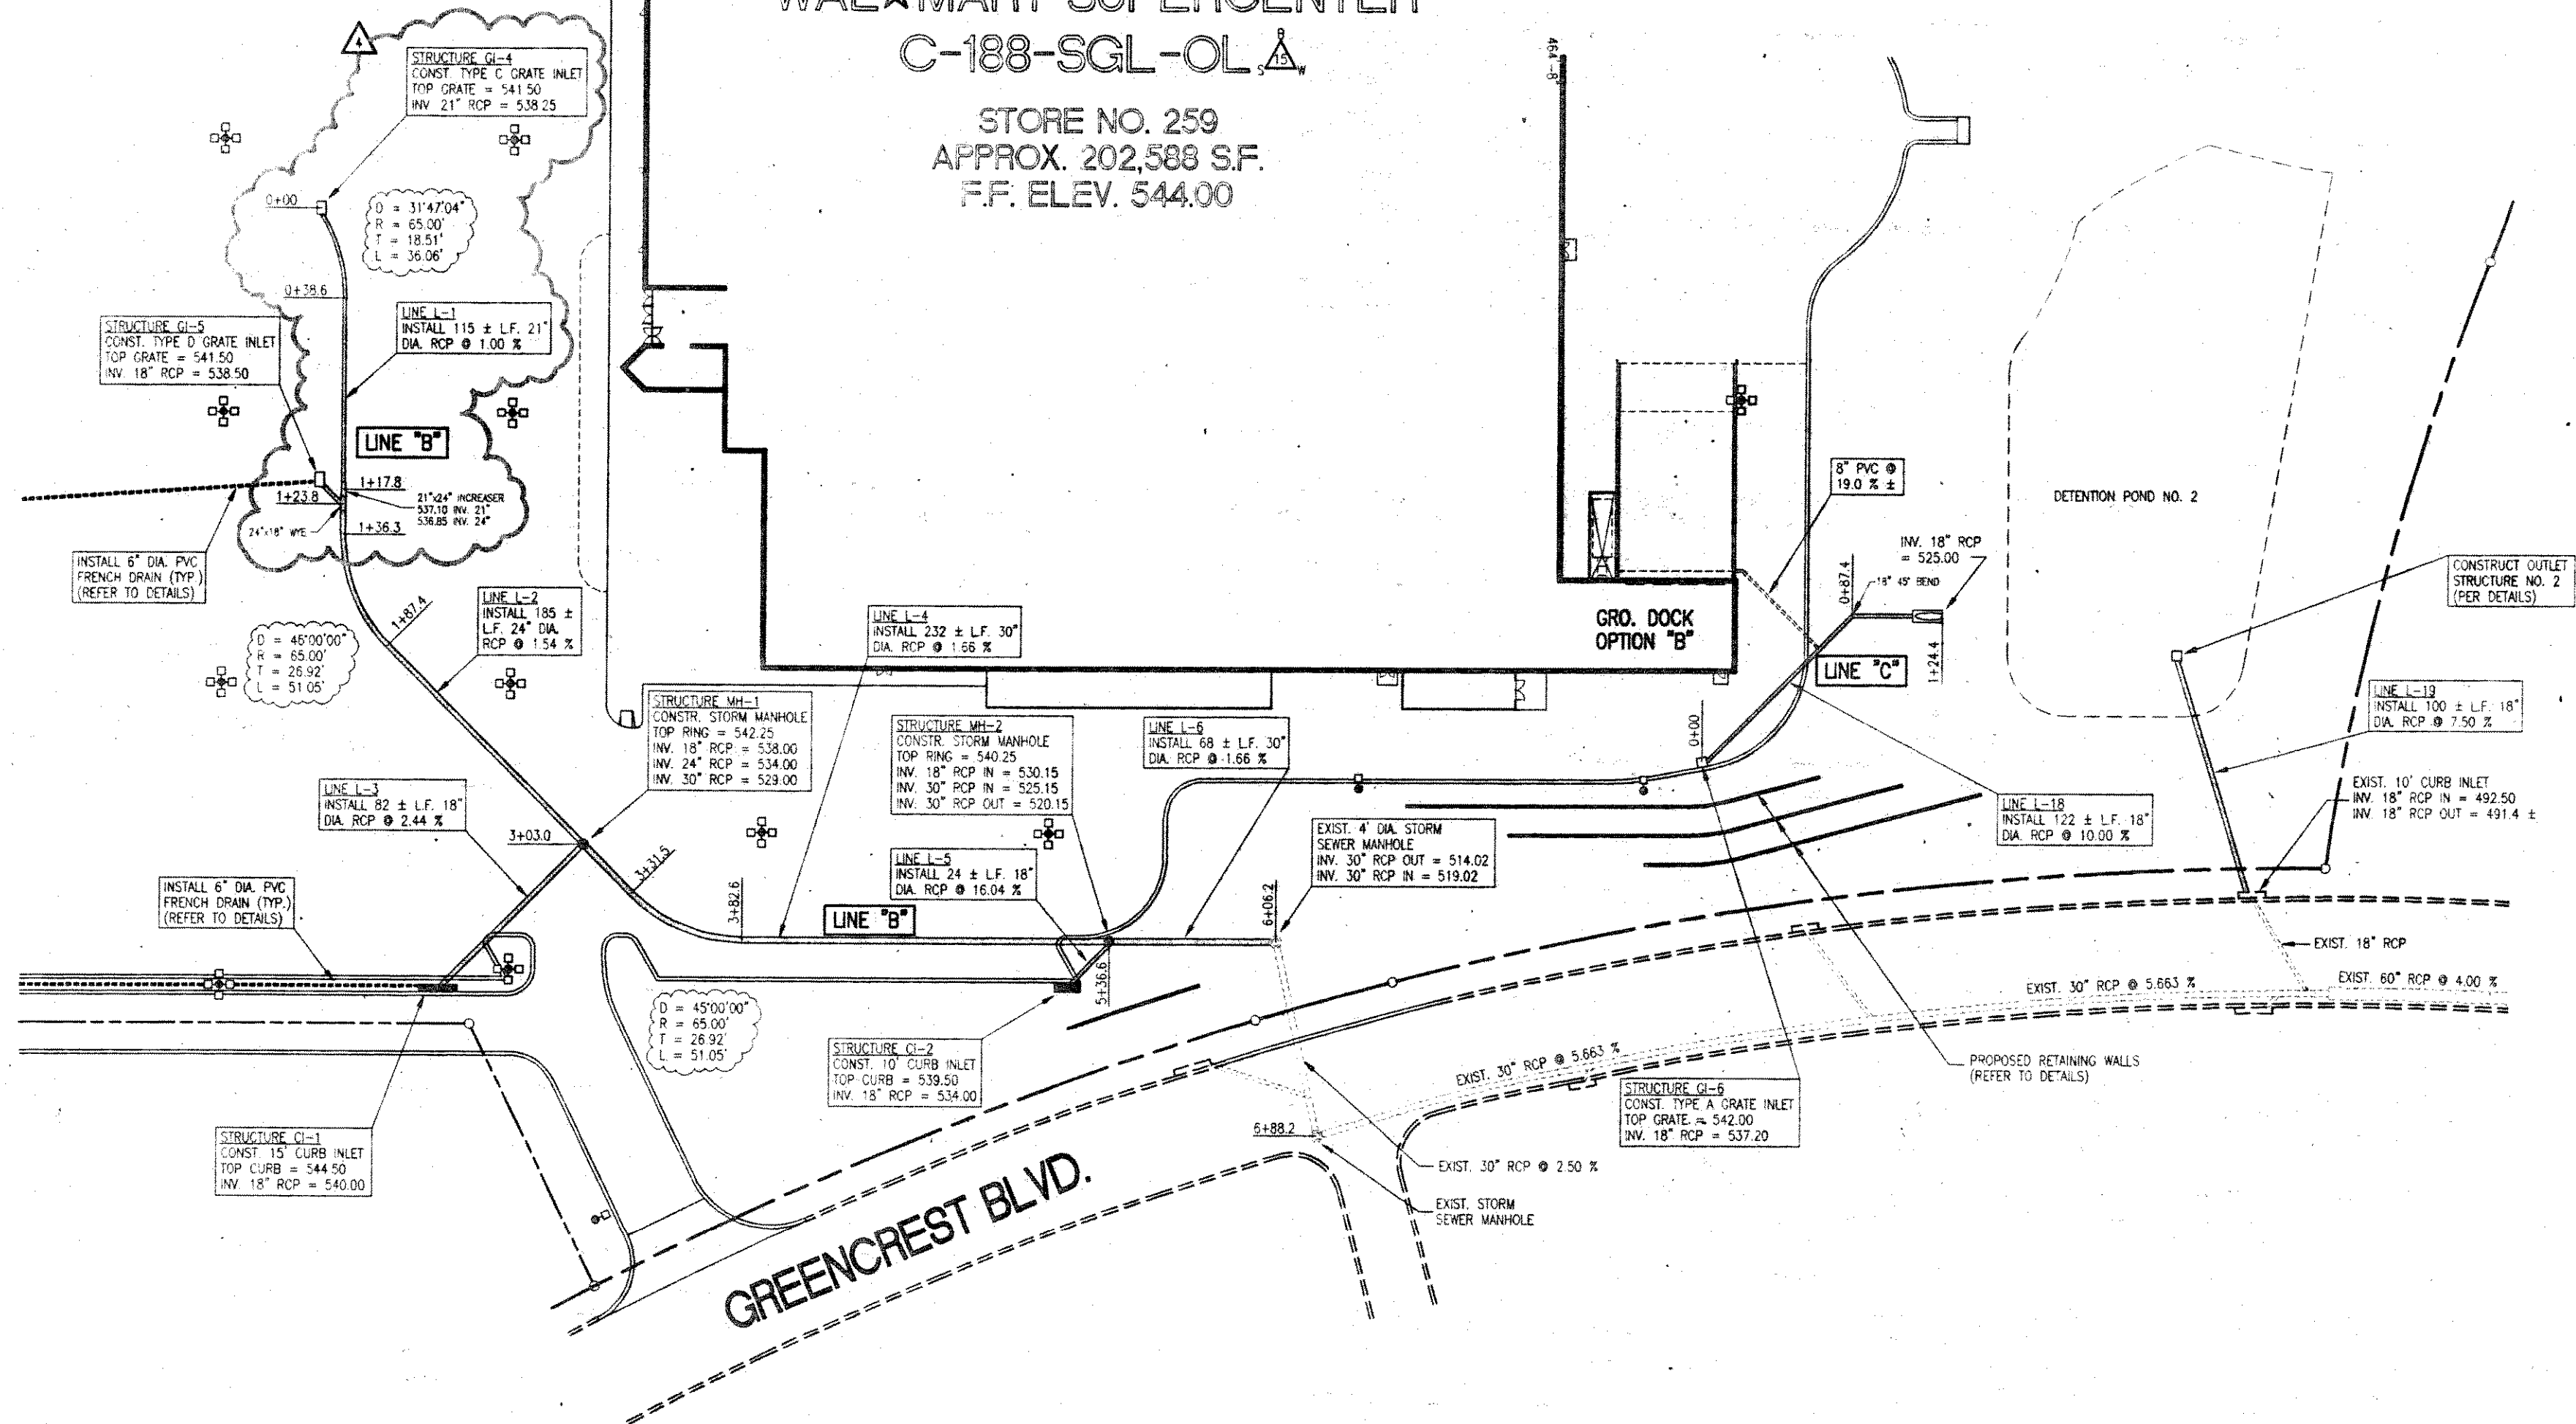

ADAMS CONSULTING ENGINEERS, INC.
 CIVIL/ENVIRONMENTAL ENGINEERS • SURVEYORS
 6520 Coppeland Road • Tyler, Texas 75703 • (936) 561-8819

STORM SEWER PLAN / PROFILE

WAL-MART SUPERCENTER #259
 INTERSTATE 30
 ROCKWALL, TEXAS

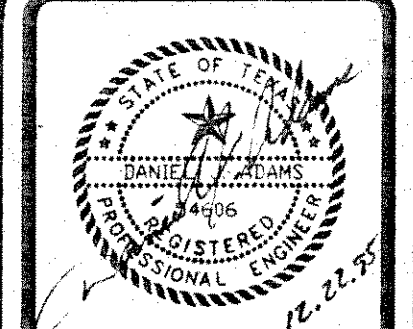

DATE	8/25/95
JOB NO.	93-11W
SHEET NO.	