
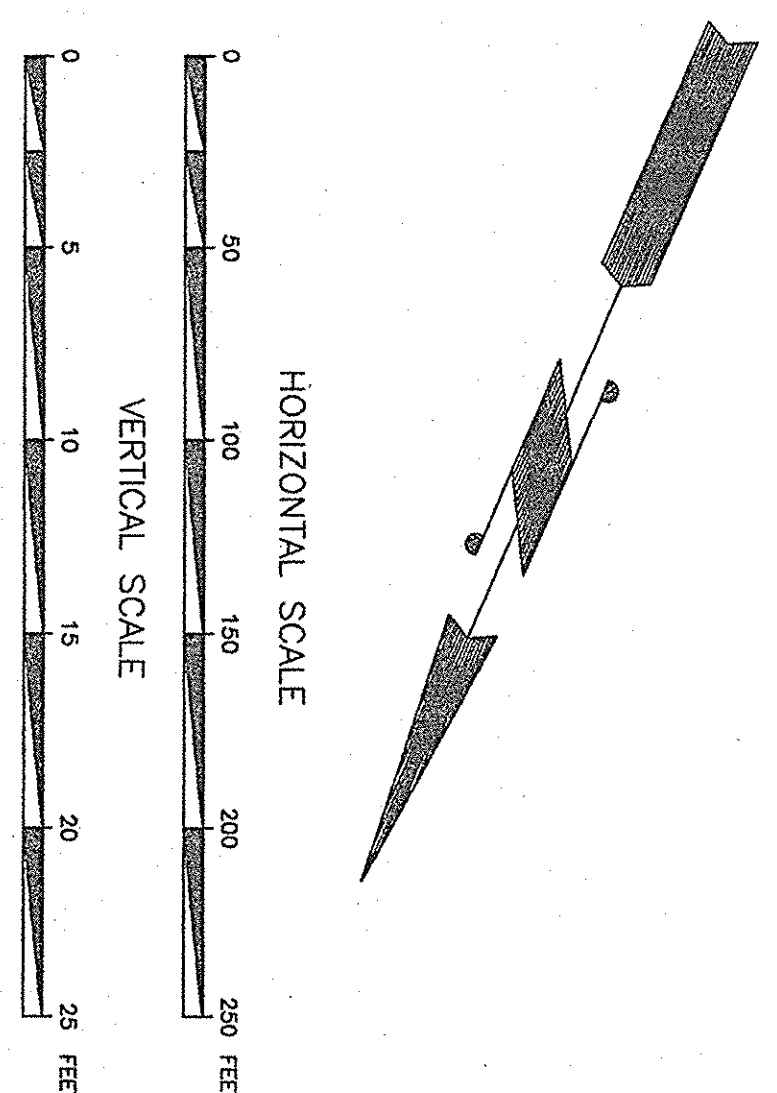


APPROXIMATE LOCATIONS OF EXISTING AND PROPOSED STORM SEWER LINES

WALMART SUPERCENTER
C-188-SQL-OL-A
STORE NO. 259
APPROX. 202,598 S.F.
F.F. ELEV. 544.00

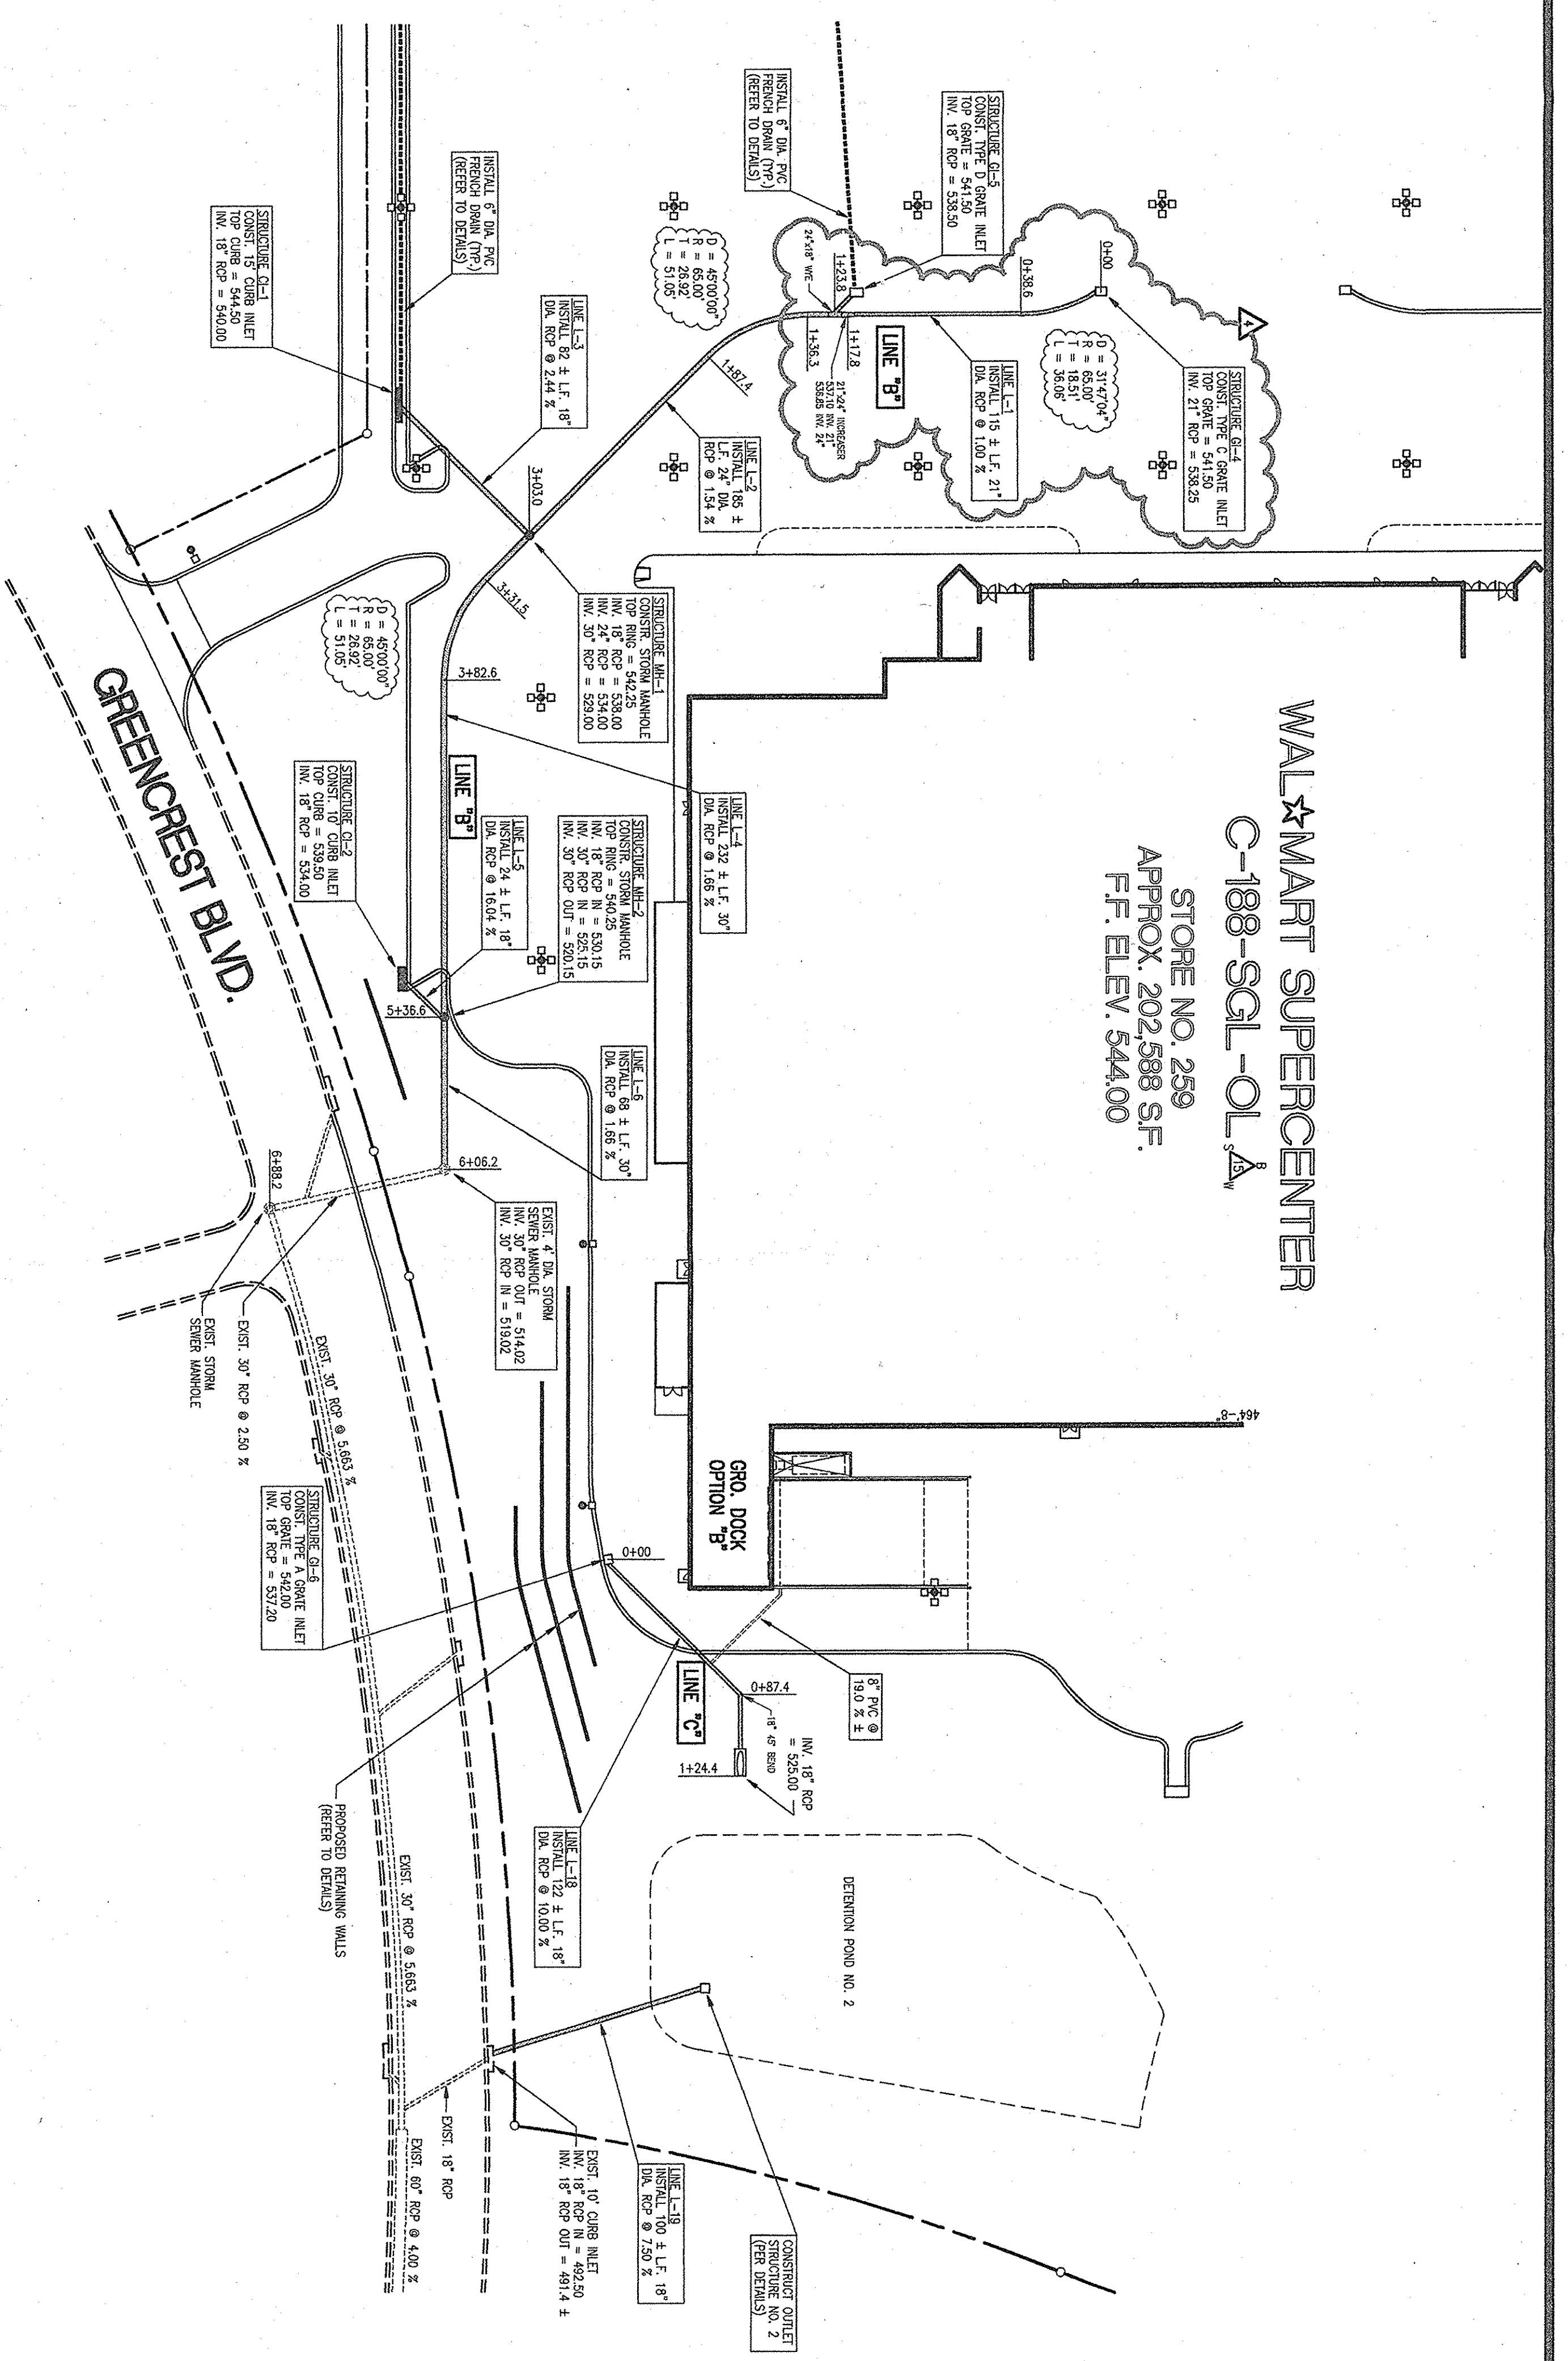

REVISIONS	BY	REVISIONS	BY
NOV. 16, 1995 (00)	SDM		
DEC. 1, 1995 (00)	JAC		
DEC. 21, 1995	JAC		

DESIGNED BY R.D.M.
 DRAWN BY R.D.M.
 CHECKED BY D.J.A.


ADAMS CONSULTING ENGINEERS, INC.
 CIVIL / ENVIRONMENTAL ENGINEERS • SURVEYORS
 6320 Copeland Road • Tyler, Texas 75703 • (936) 561-8919

STORM SEWER PLAN / PROFILE

WAL-MART SUPERCENTER #259
INTERSTATE 30
ROCKWALL, TEXAS



DATE: 8/25/95
 JOB NO.: 93-11W
 SHEET NO.: 8

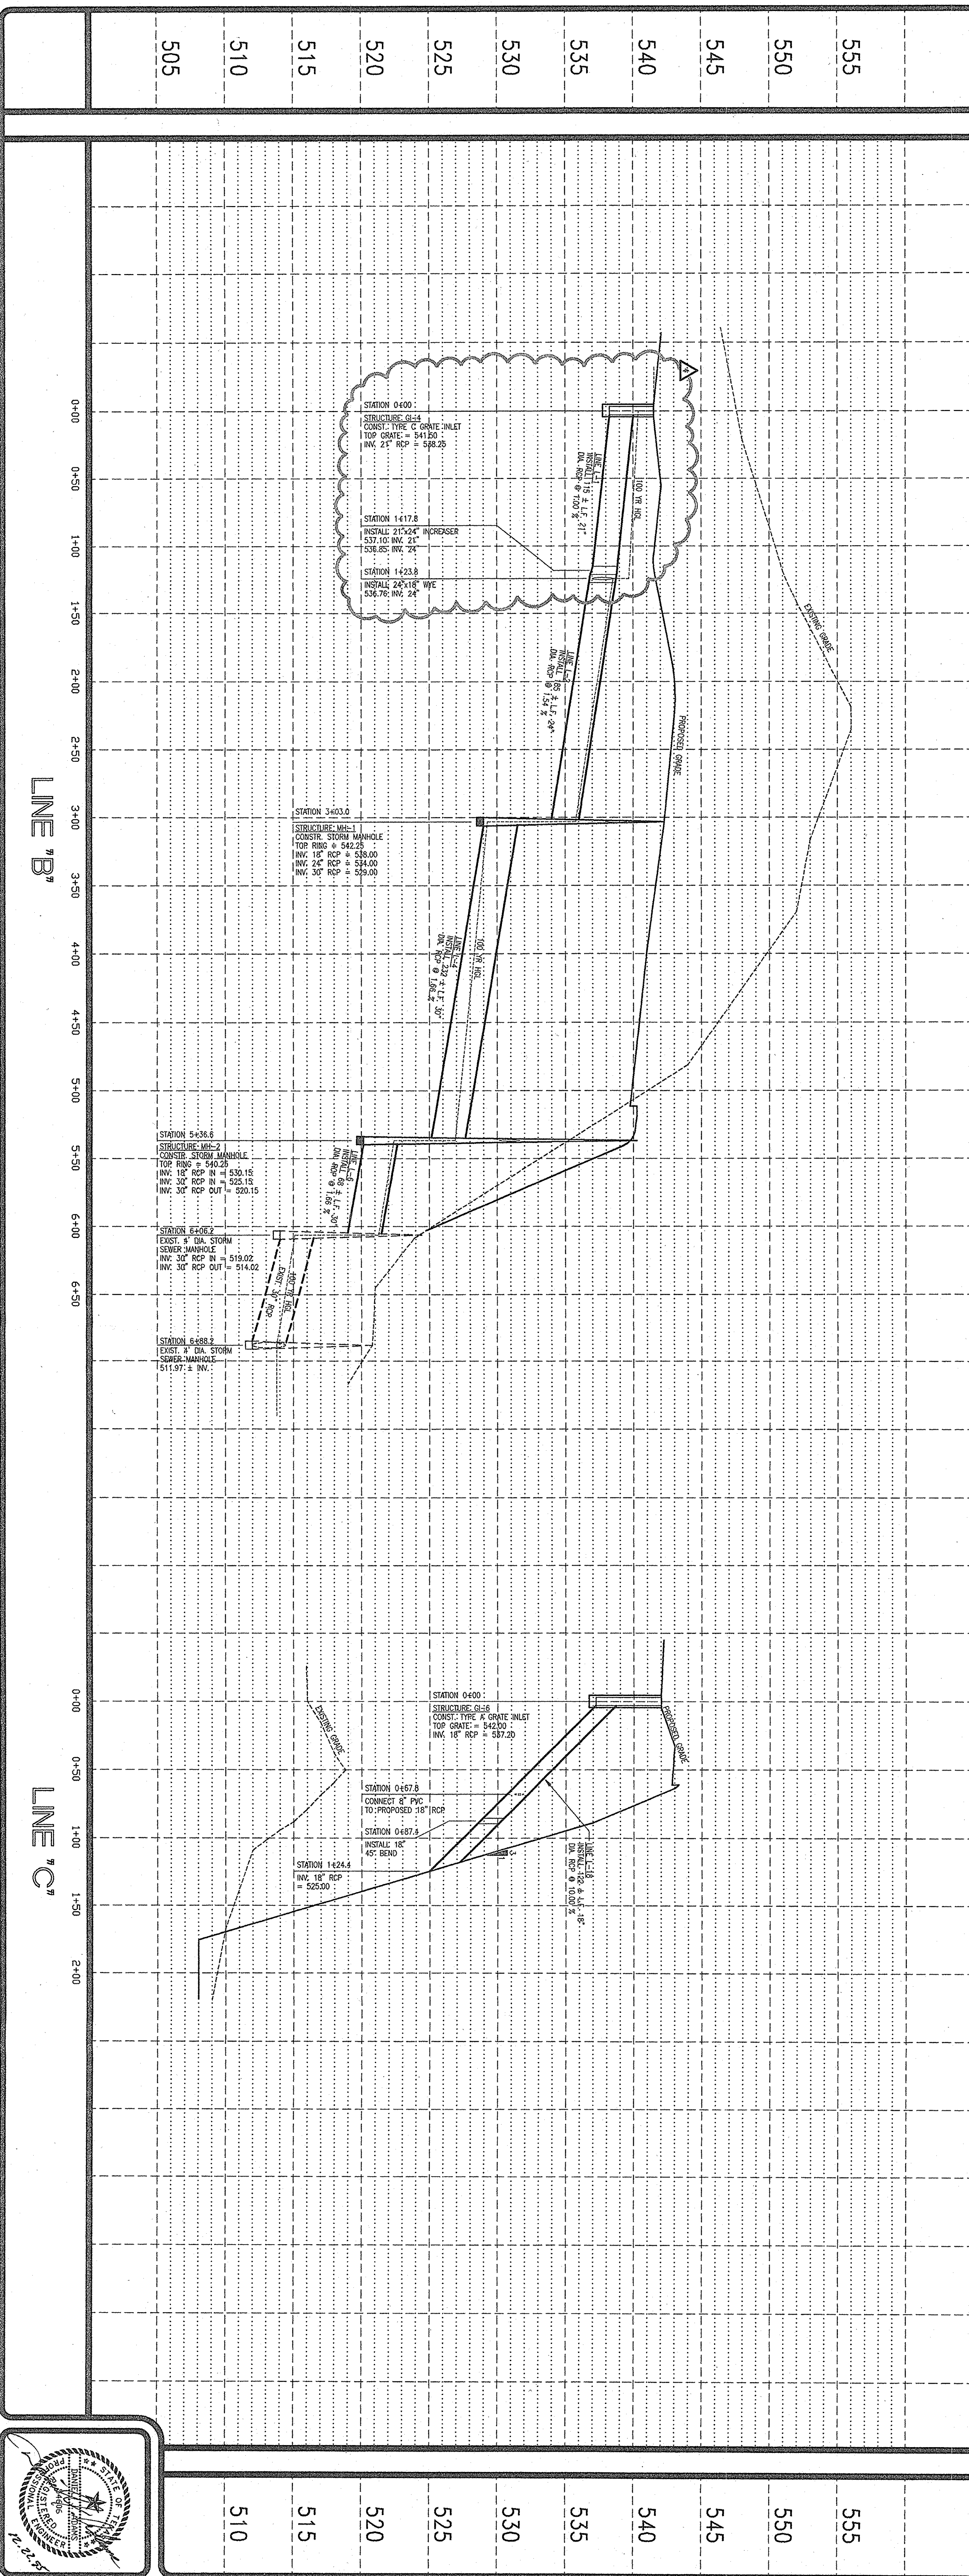

505
510
515
520
525
530
535
540
545
550
555

LINE "B"

LINE "C"