

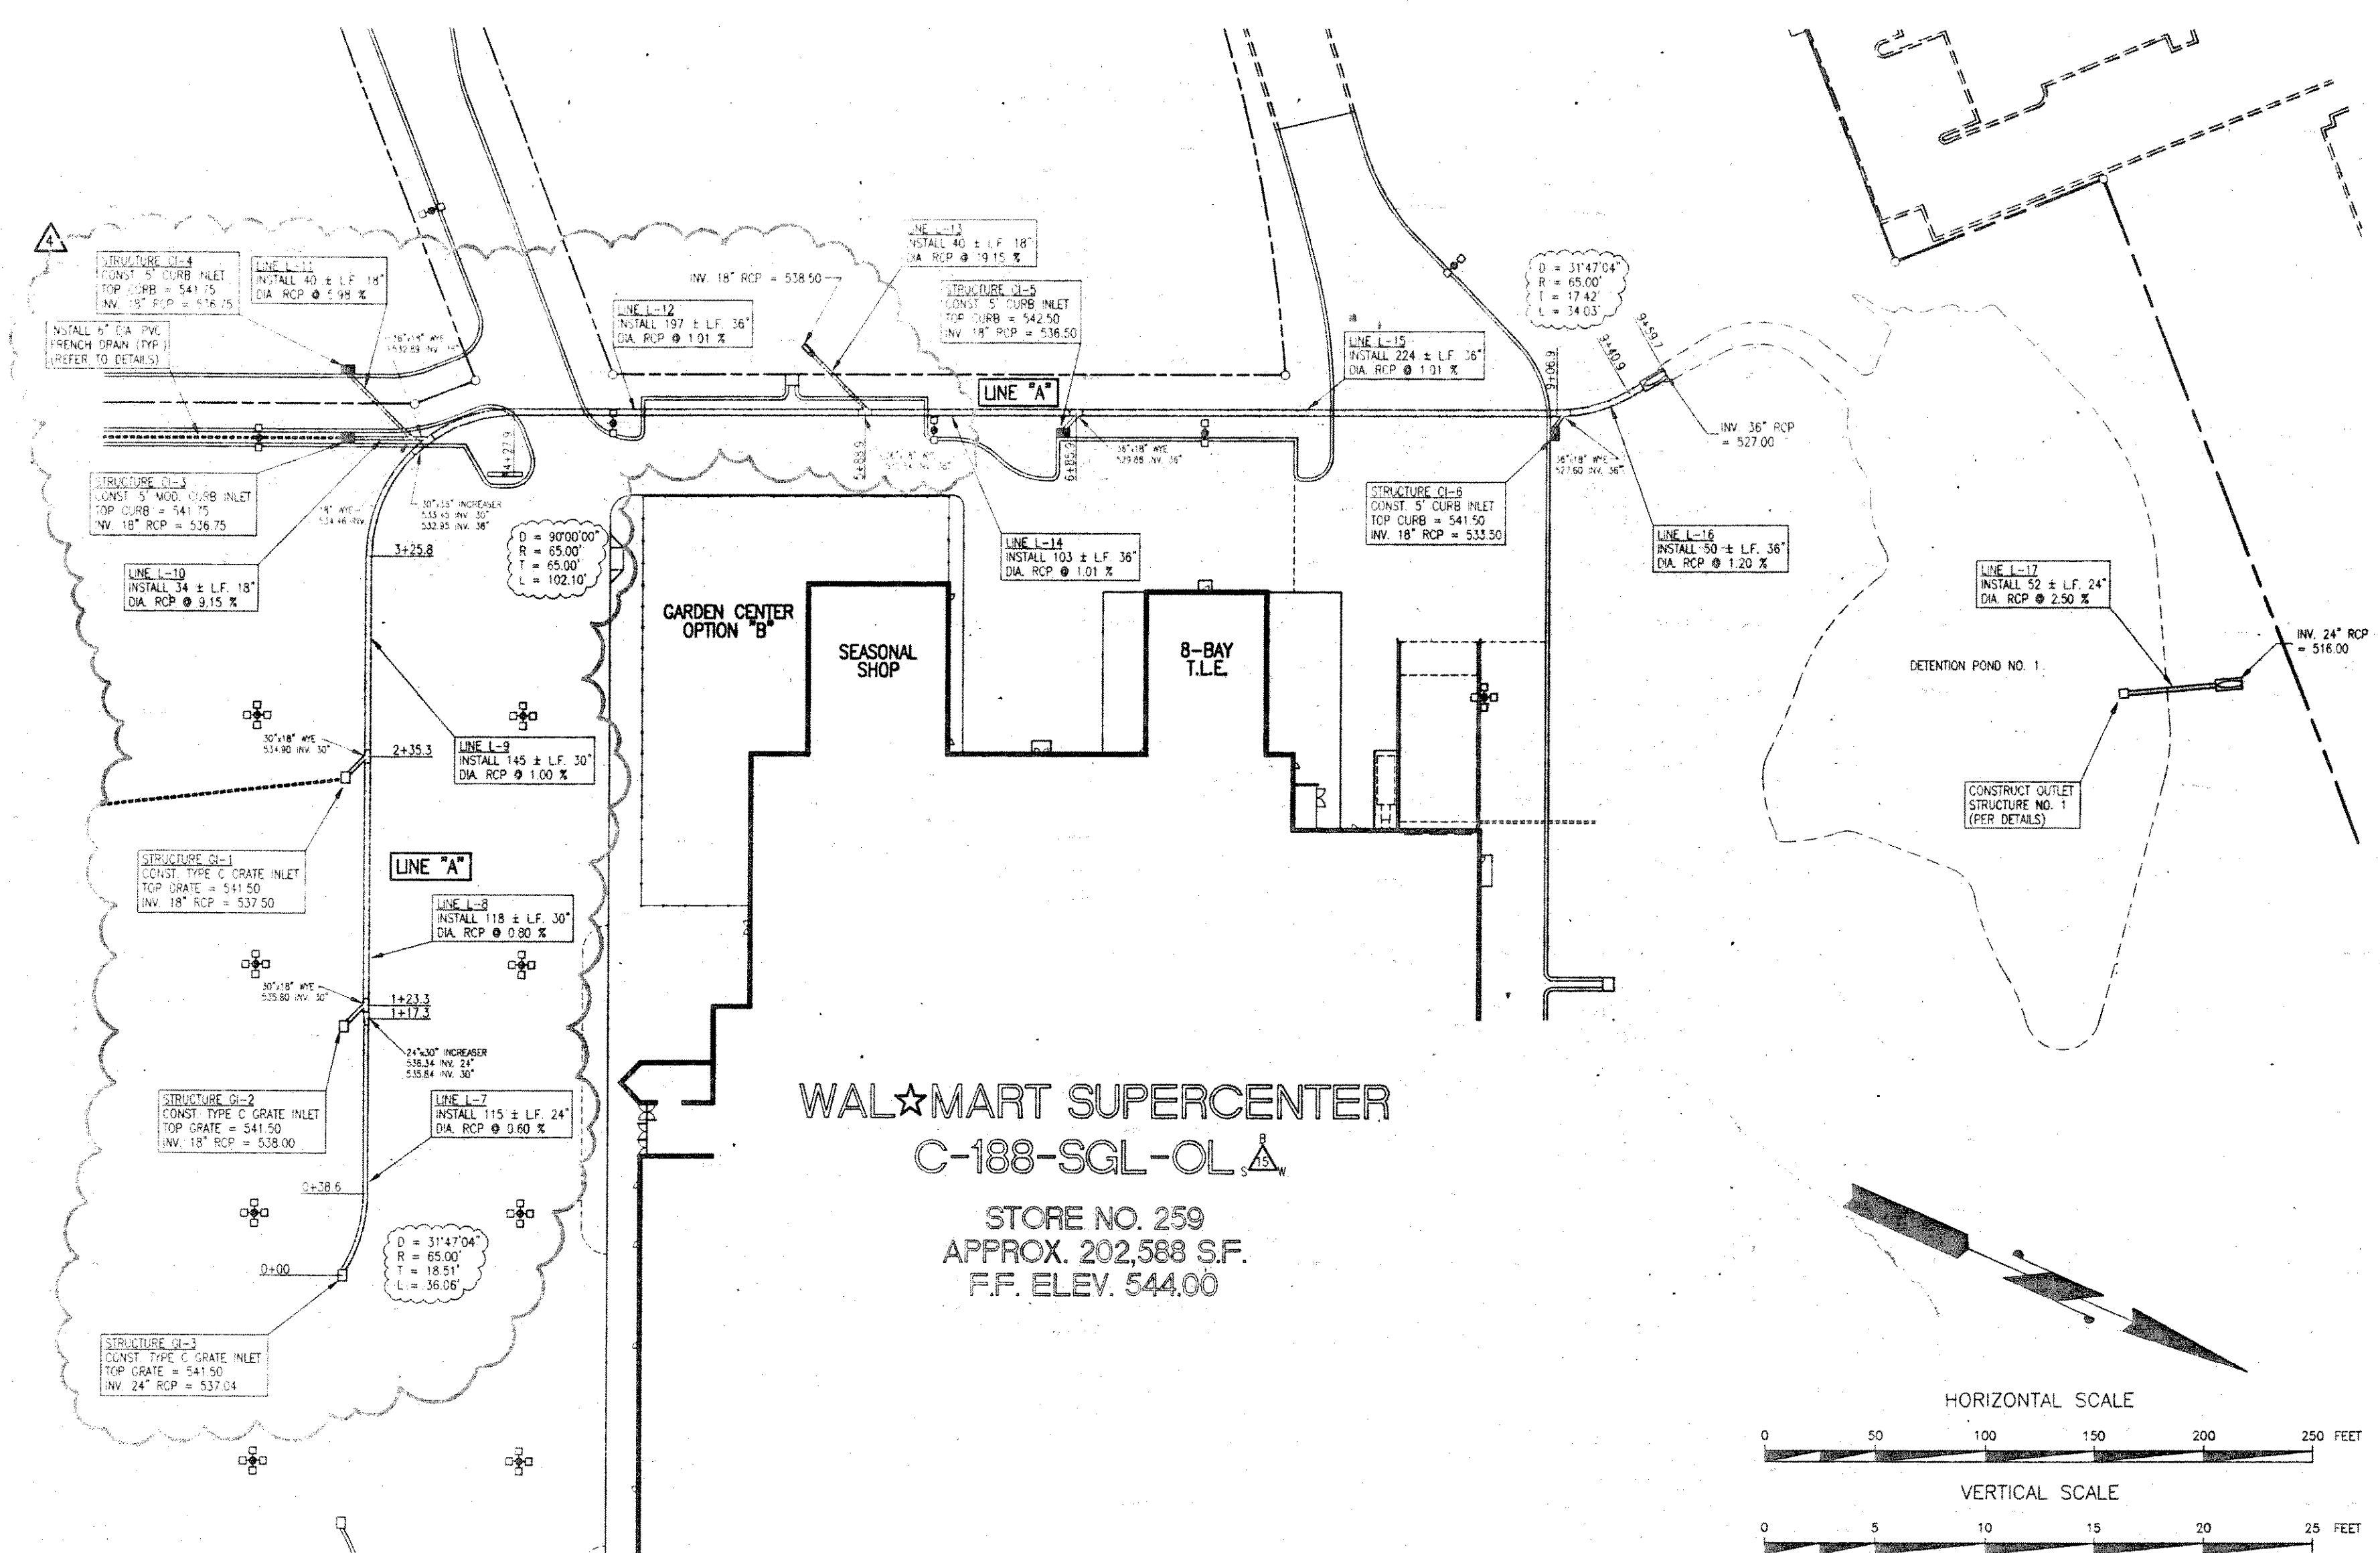


REVISIONS	BY	REVISIONS	BY
NOV. 16, 1995 (OTB)	R.D.M.		
DEC. 1, 1995 (OTB)	D.J.C.		
DEC. 21, 1995	D.J.C.		

DESIGNED  
R.D.M.  
DRAWN  
R.D.M.  
CHECKED  
D.J.A.

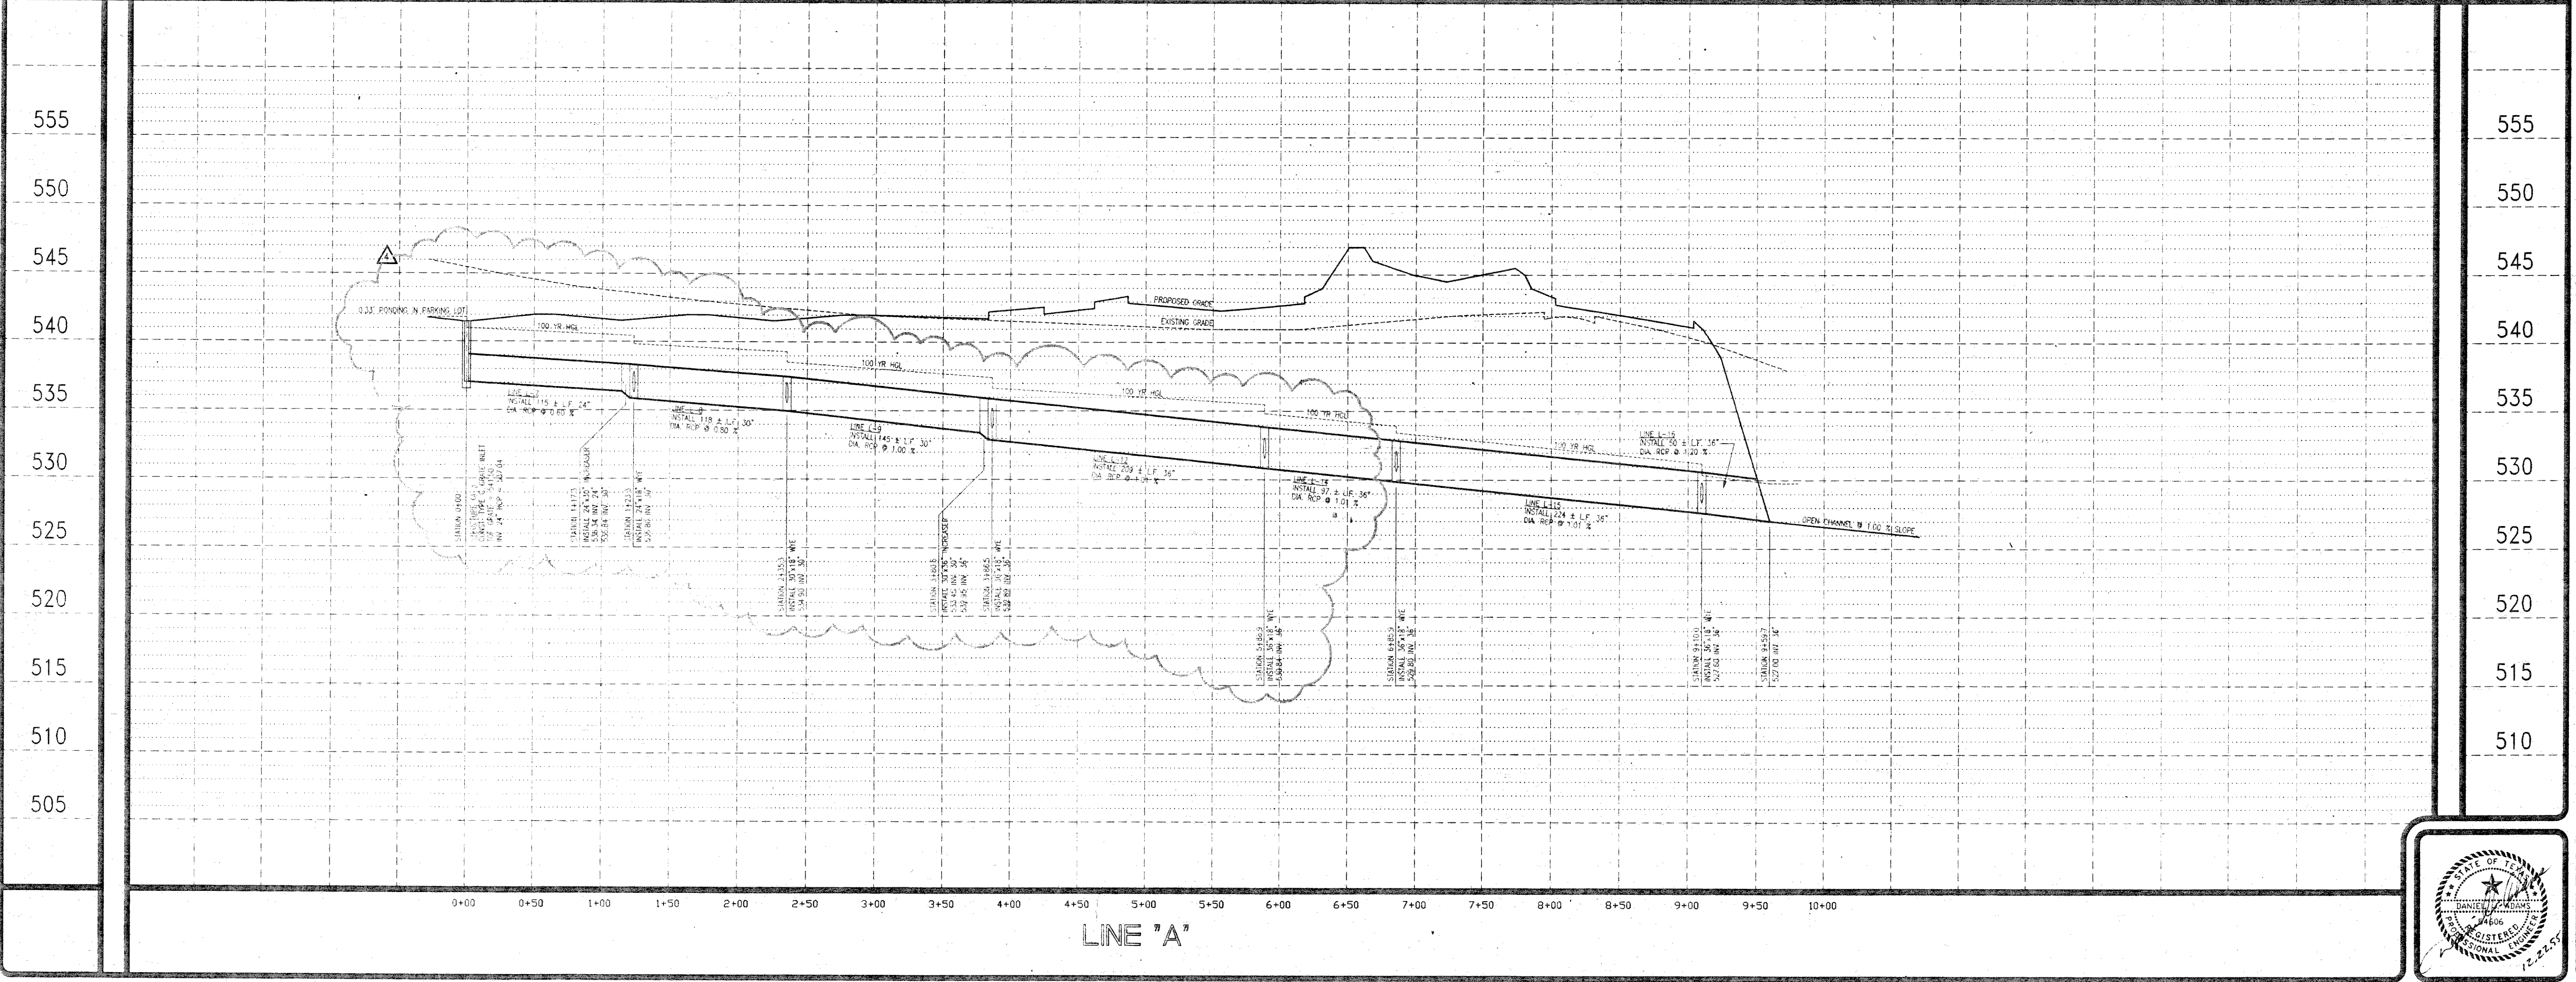

**WALMART SUPERCENTER**  
**C-188-SGL-OL**  
STORE NO. 259  
APPROX. 202,588 S.F.  
F.F. ELEV. 544.00

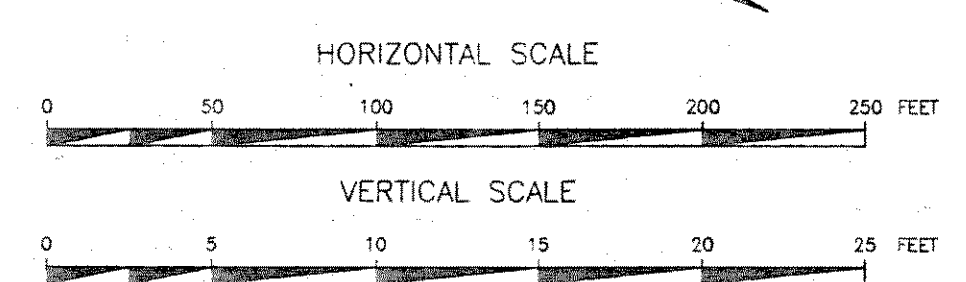

**ADAMS CONSULTING ENGINEERS, INC.**  
CIVIL / ENVIRONMENTAL ENGINEERS • SURVEYORS  
6820 Coppeland Road • Tyler, Texas 75703 • (903) 561-9819

STORM SEWER PLAN / PROFILE

WAL-MART SUPERCENTER #259  
INTERSTATE 30  
ROCKWALL, TEXAS



DATE  
8/25/95  
JOB NO.  
93-11W  
SHEET NO.