
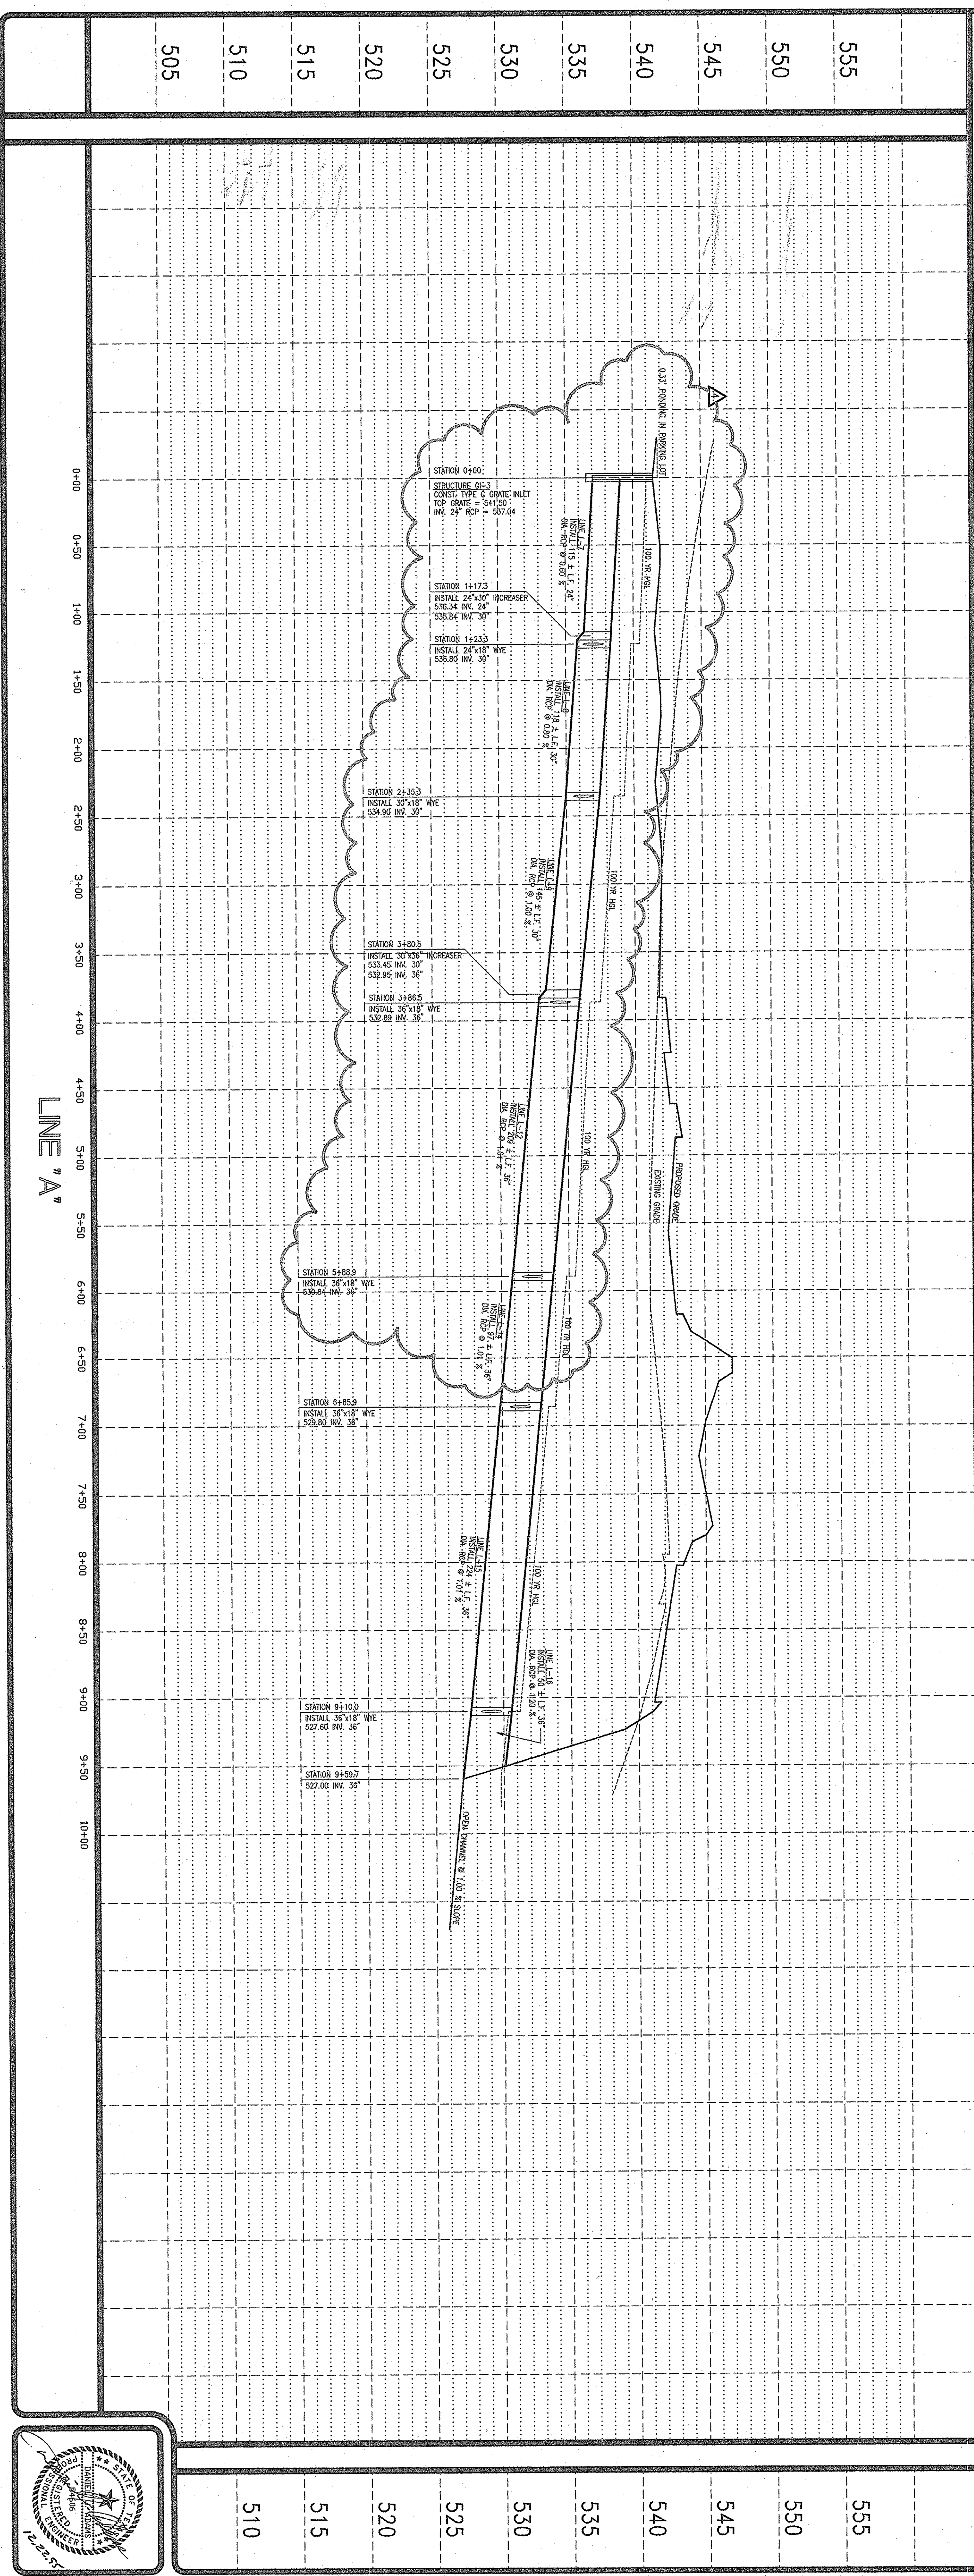


WAL-MART SUPERCENTER  
 C-188-SCL-OL-A  
 STORE NO. 259  
 APPROX. 202,588 S.F.  
 F.F. ELEV. 544.00

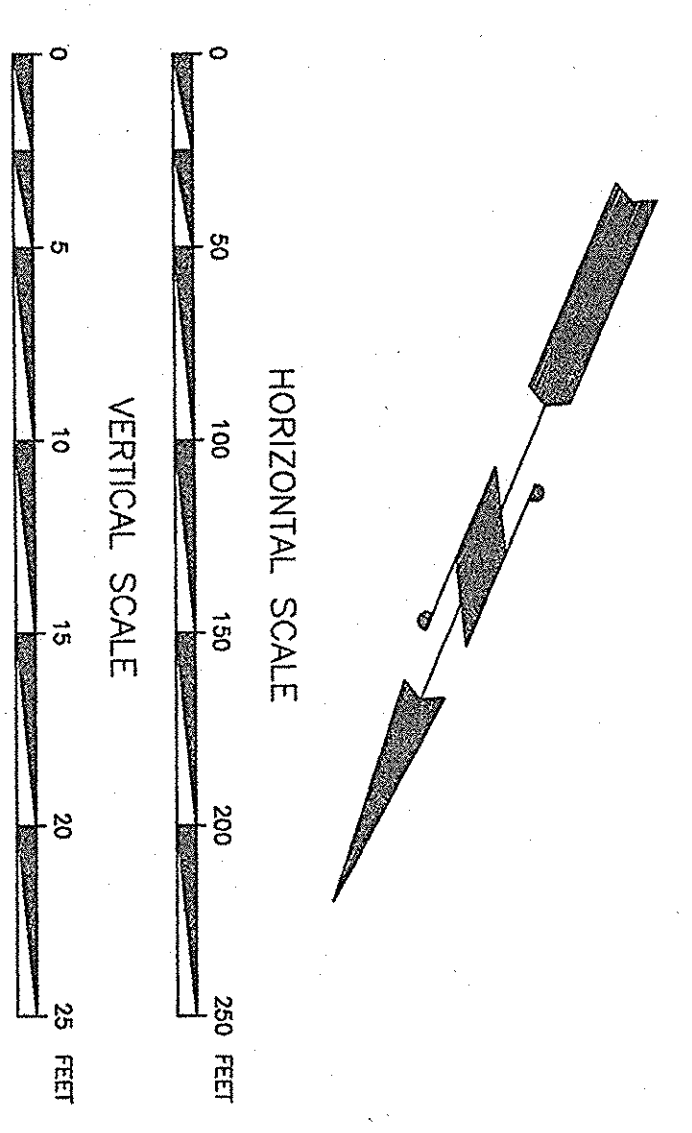


REVISIONS	BY	REVISIONS	BY
NOV. 16, 1995 (09)	R.O.M.		
DEC. 1, 1995 (09)	D.L.C.		
DEC. 21, 1995	D.L.C.		

DESIGNED	R.O.M.
DRAWN	R.O.M.
CHECKED	D.J.A.

WAL-MART SUPERCENTER #259  
 INTERSTATE 30  
 ROCKWALL, TEXAS

STORM SEWER PLAN / PROFILE

**Adams Consulting Engineers, Inc.**  
 CIVIL / ENVIRONMENTAL ENGINEERS - SURVEYORS  
 6320 Copeland Road • Tyler, Texas 75703 • (903) 561-8919

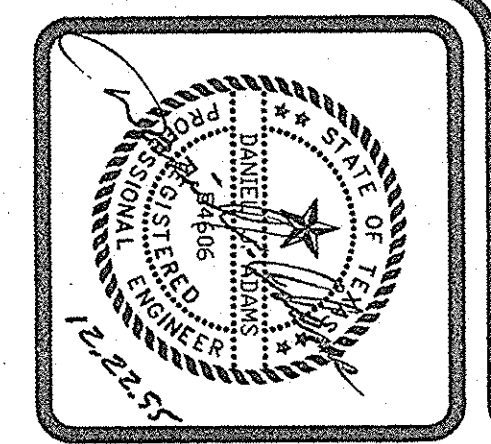

DATE: 8/25/95  
 JOB NO.: 93-11W  
 SHEET NO.: 9