
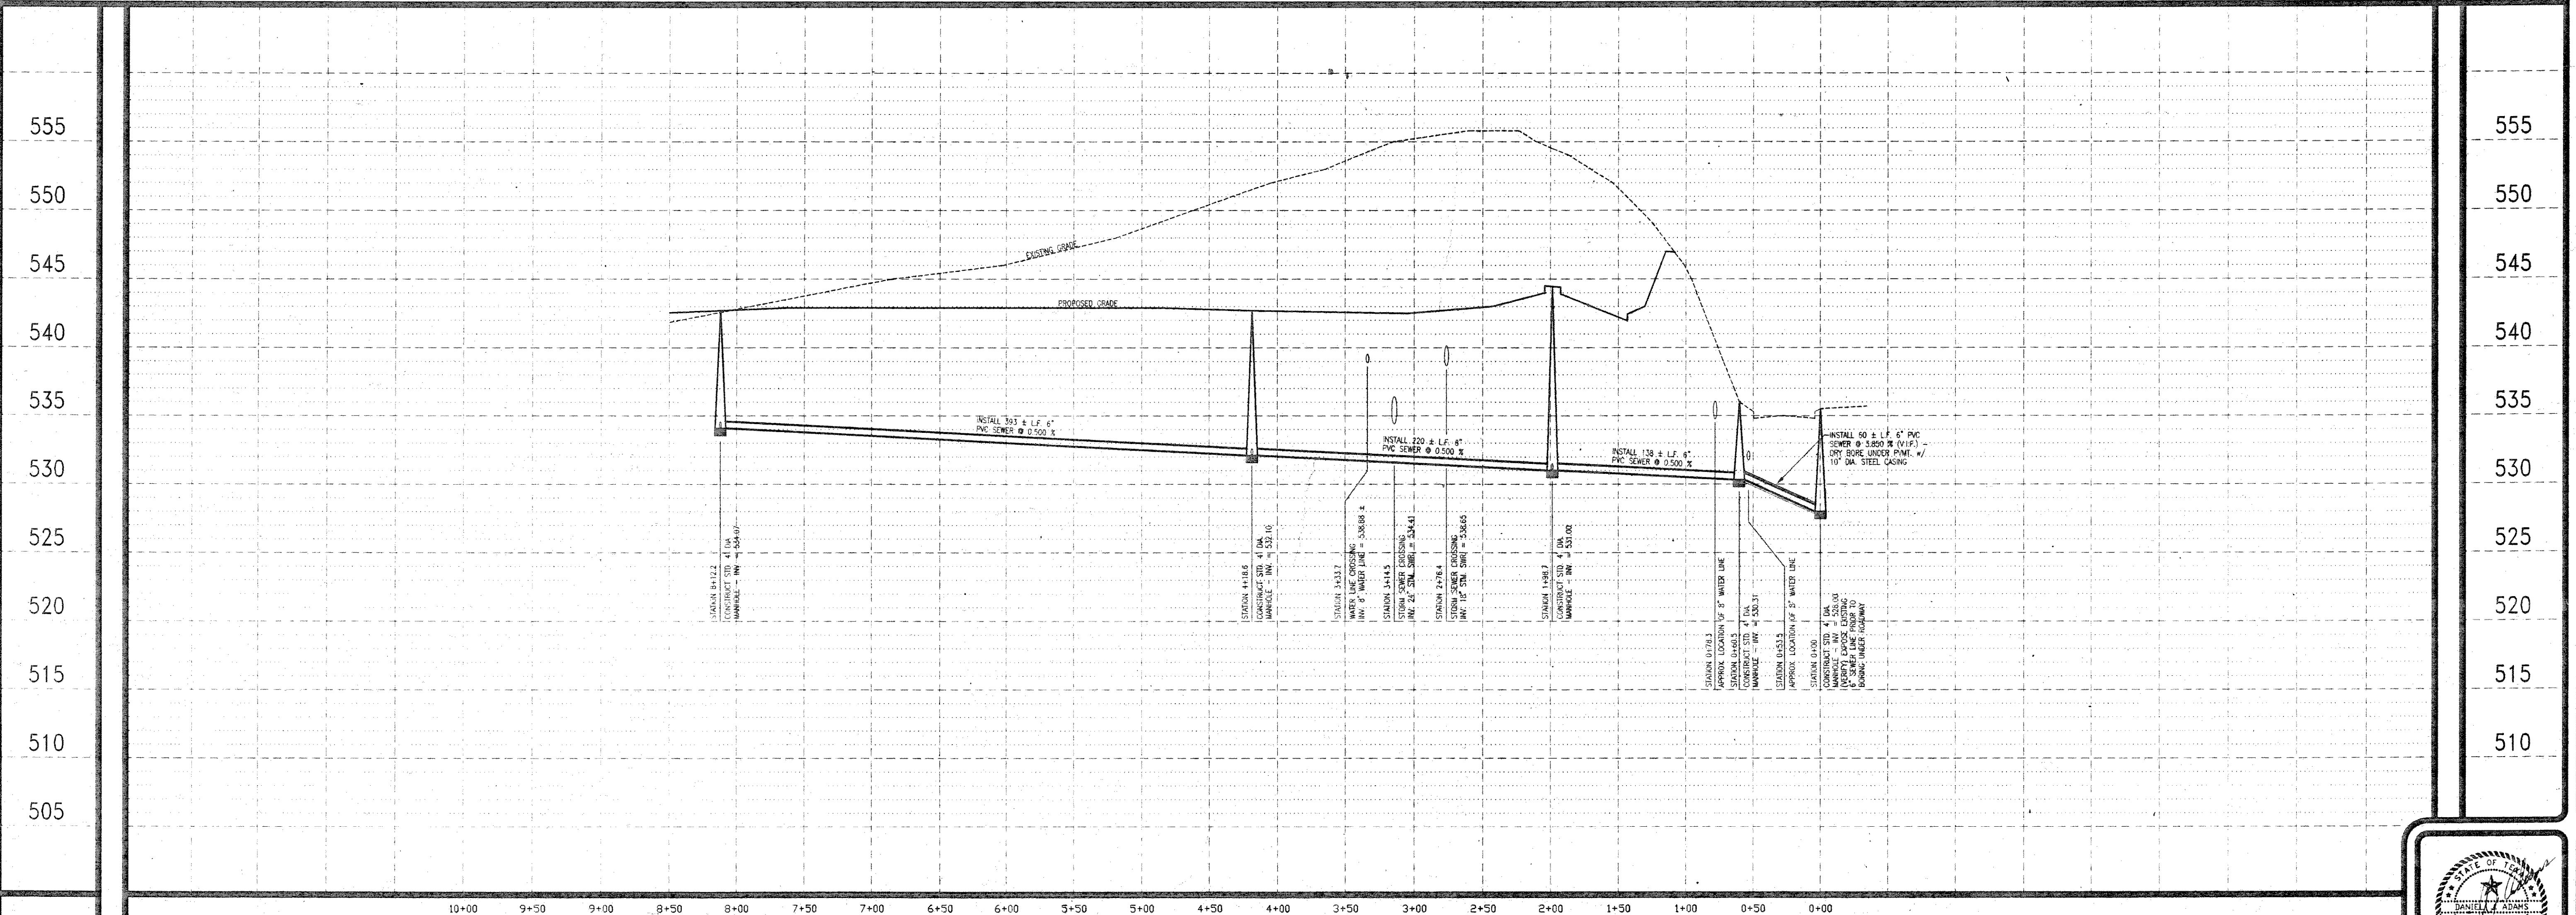
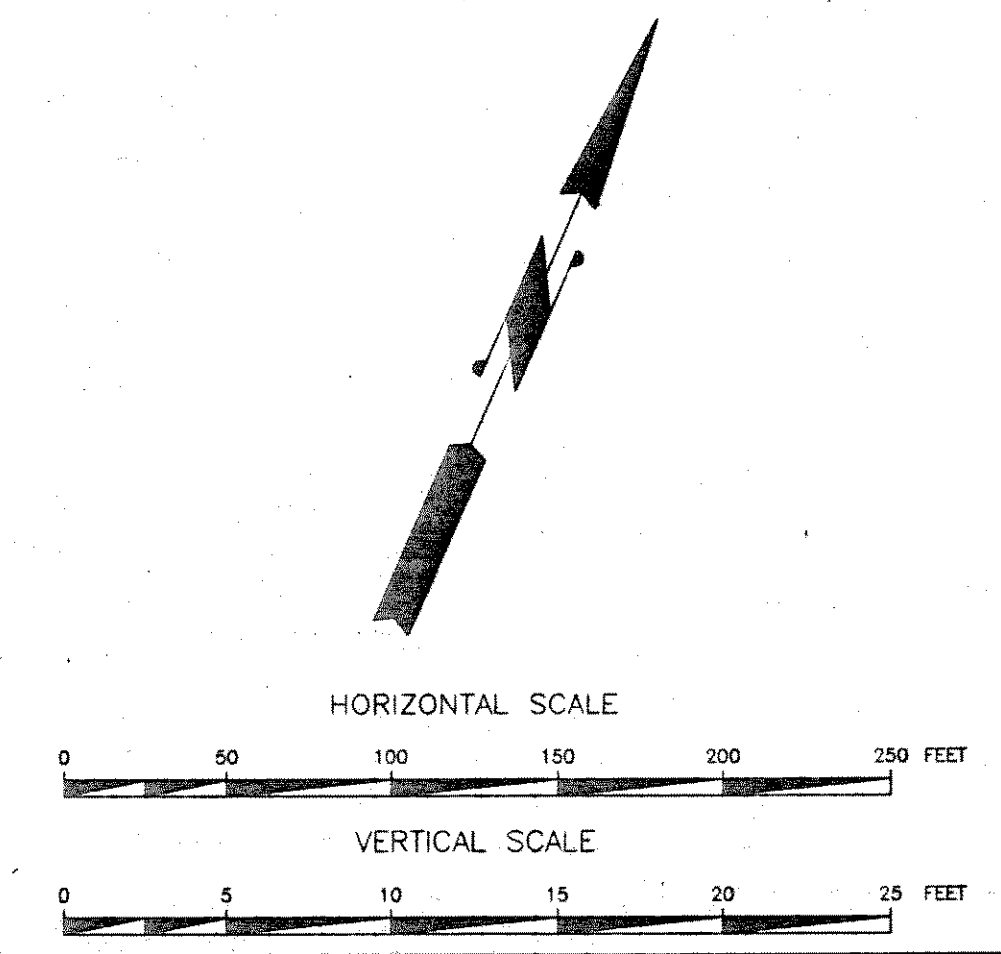


REVISIONS	BY	REVISIONS	BY
(M.C. 1, 1995 (918))	D.L.C.		


DESIGNED	R.D.M.
DRAWN	R.D.M.
CHECKED	D.J.A.

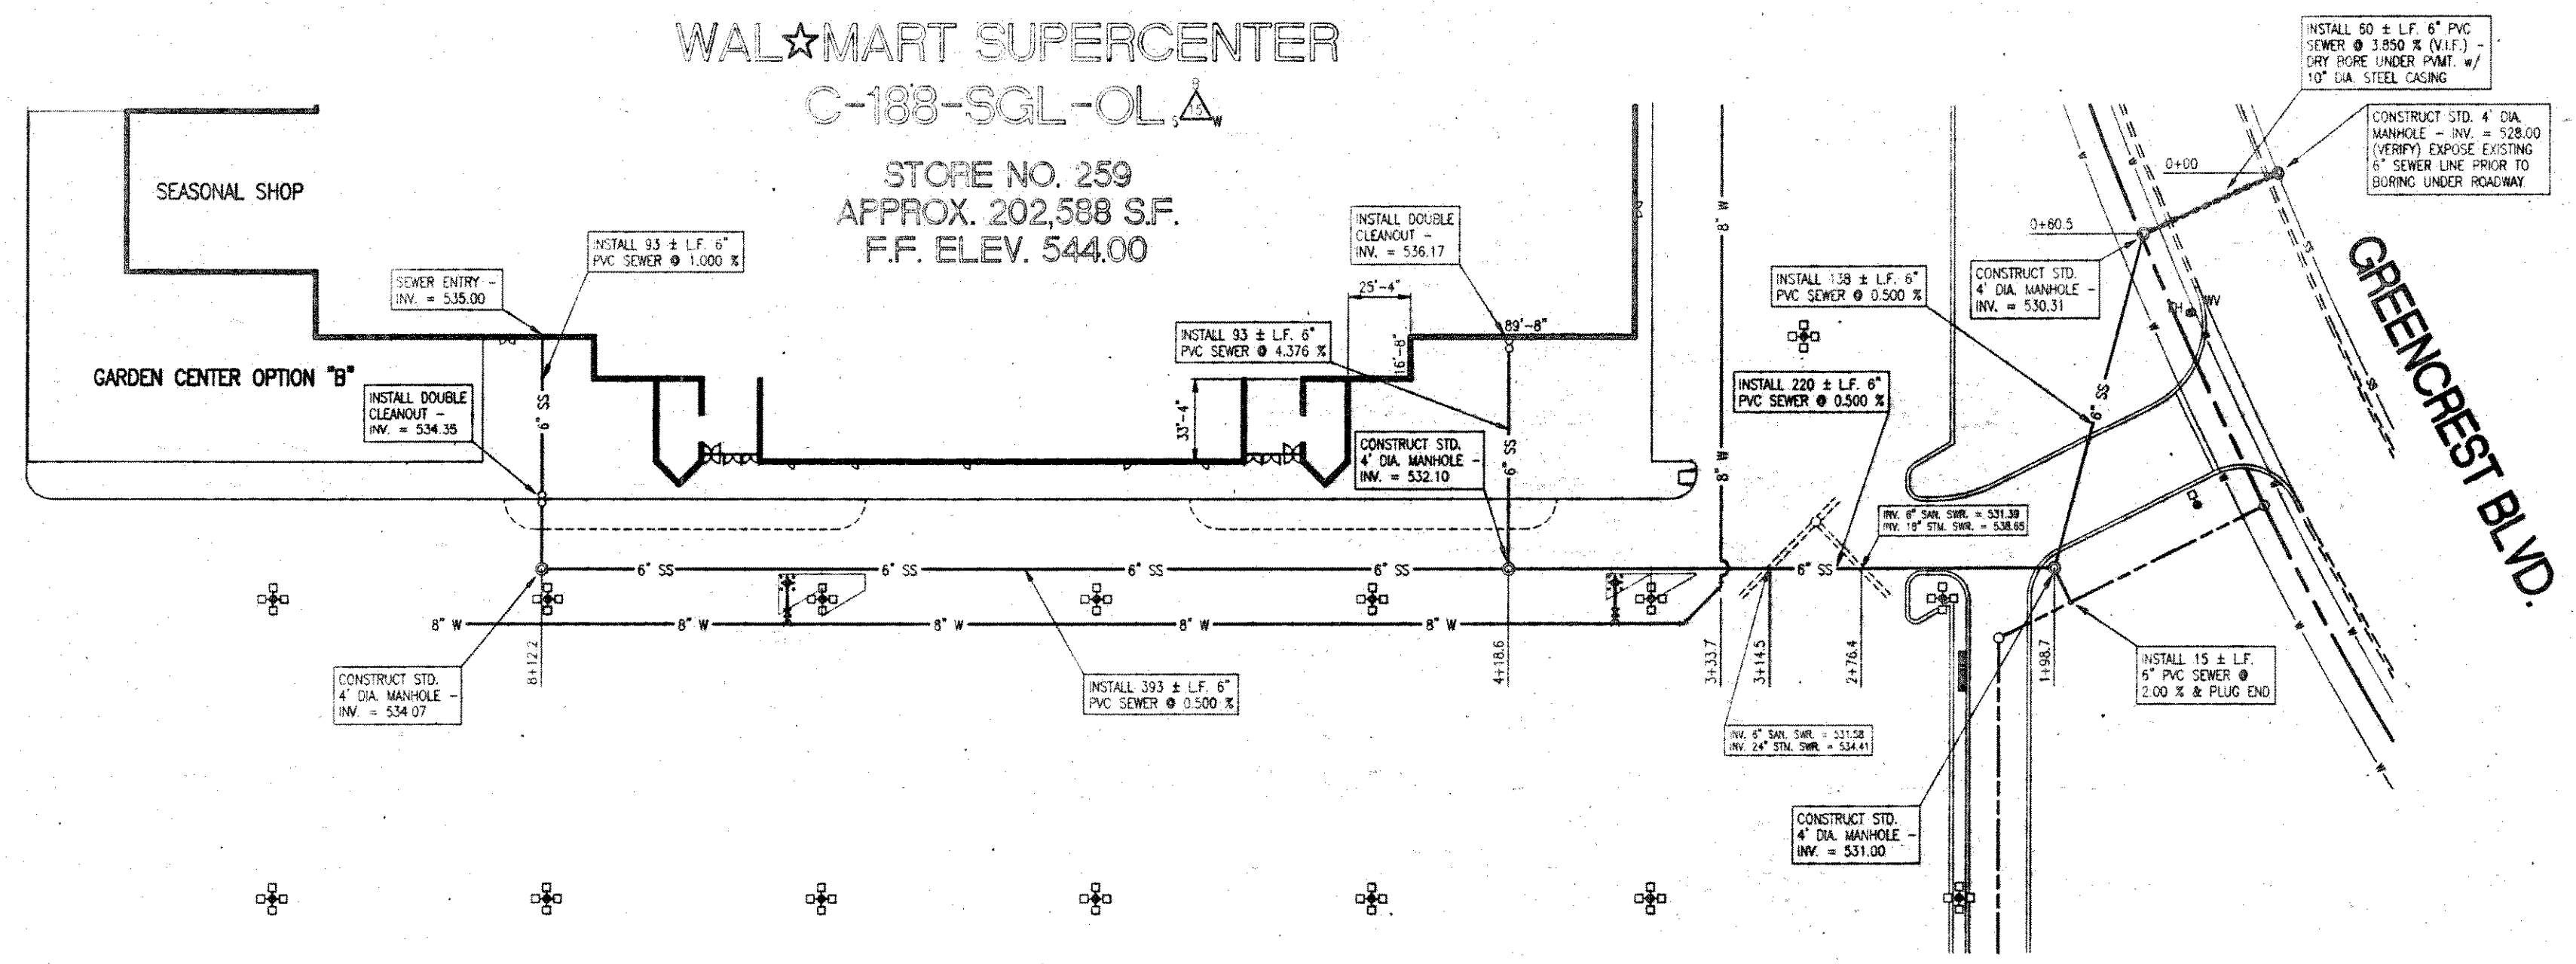

ADAMS CONSULTING ENGINEERS, INC.
CIVIL / ENVIRONMENTAL ENGINEERS - SURVEYORS
6820 Copeland Road • Tyler, Texas 75703 • (800) 561-8819

SANITARY SEWER PLAN / PROFILE

WAL-MART SUPERCENTER #259
INTERSTATE 30
ROCKWALL, TEXAS

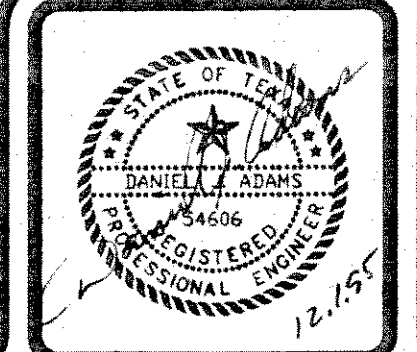

DATE	8/25/95
JOB NO.	93-11W
SHEET NO.	11