



2 - GRATE INLET CAPACITIES	
DEPTH (FT.)	INLET CAPACITY (CFS)
0.2	2.38
0.3	3.25
0.4	3.80
0.5	4.22
0.6	4.63

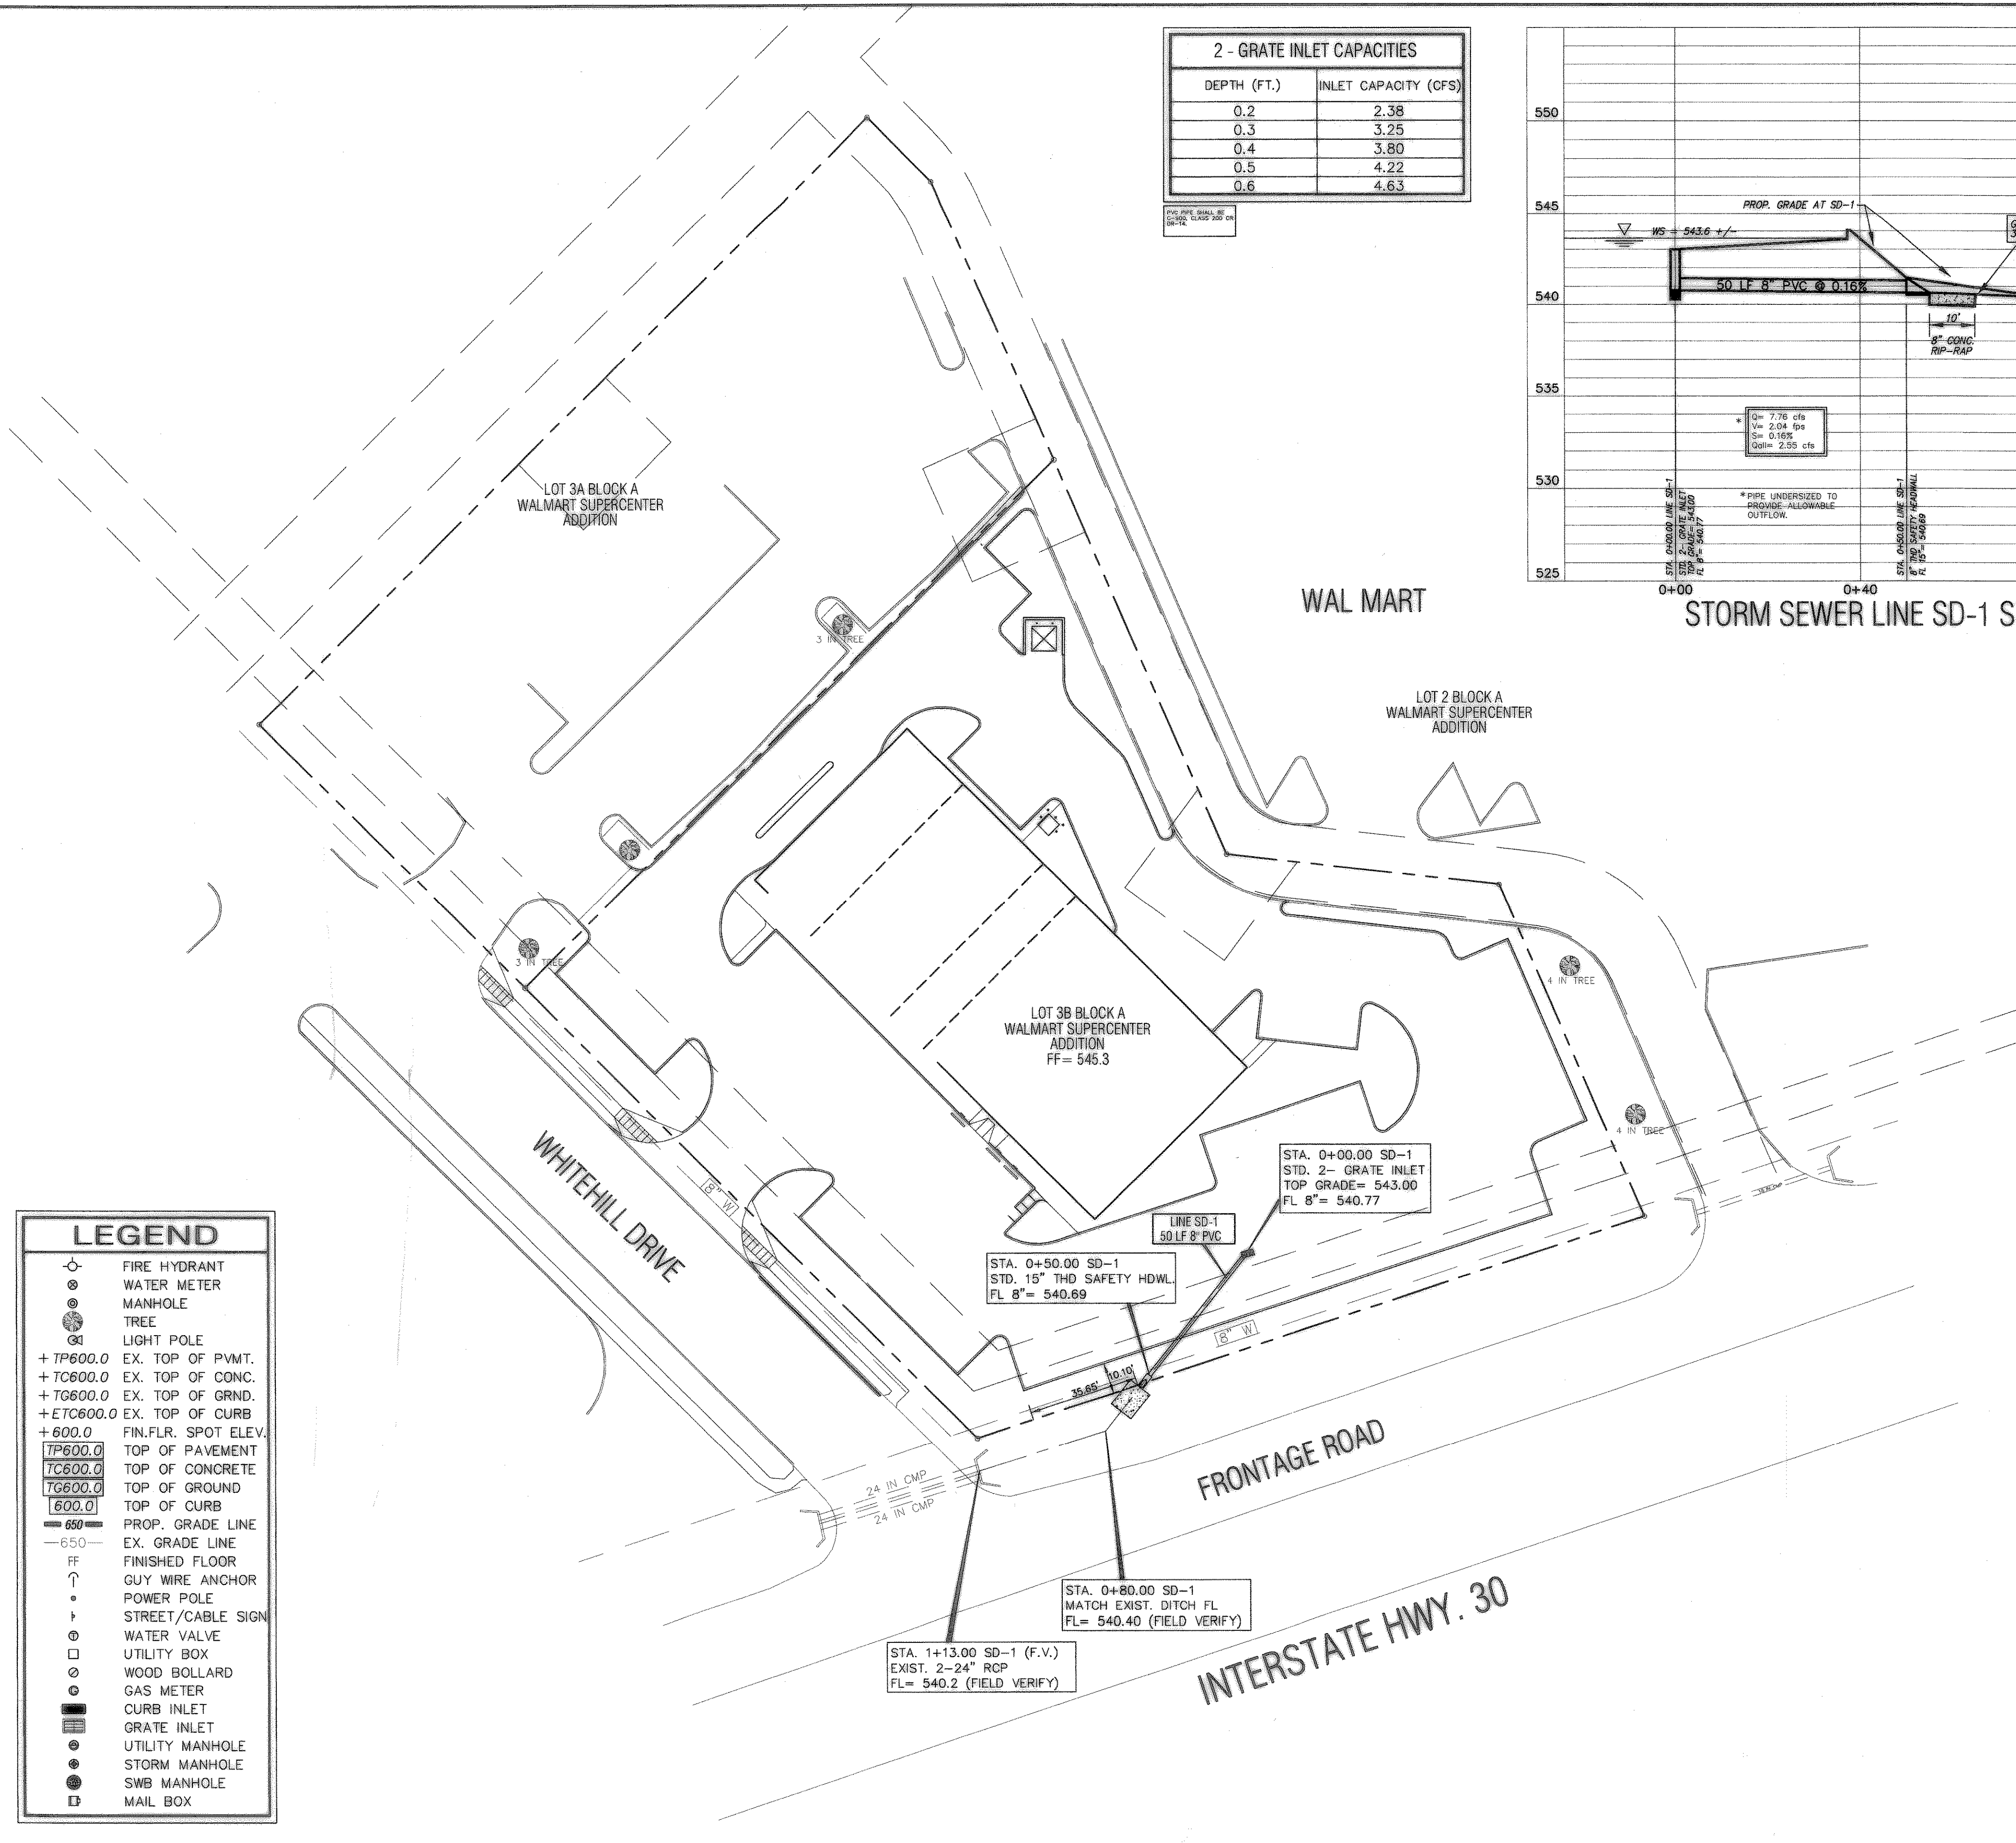

LEGEND	
	FIRE HYDRANT
	WATER METER
	MANHOLE
	TREE
	LIGHT POLE
+TP600.0	EX. TOP OF PVMT.
+TC600.0	EX. TOP OF CONC.
+TG600.0	EX. TOP OF GRND.
+ETC600.0	EX. TOP OF CURB
+600.0	FIN.FLR. SPOT ELEV.
TP600.0	TOP OF PAVEMENT
TC600.0	TOP OF CONCRETE
TG600.0	TOP OF GROUND
600.0	TOP OF CURB
— 650 —	PROP. GRADE LINE
- 650 -	EX. GRADE LINE
FF	FINISHED FLOOR
↑	GUY WIRE ANCHOR
•	POWER POLE
+	STREET/CABLE SIGN
⊙	WATER VALVE
□	UTILITY BOX
⊙	WOOD BOLLARD
⊙	GAS METER
⊙	CURB INLET
⊙	GRATE INLET
⊙	UTILITY MANHOLE
⊙	STORM MANHOLE
⊙	SWB MANHOLE
⊙	MAIL BOX

dietz engineering

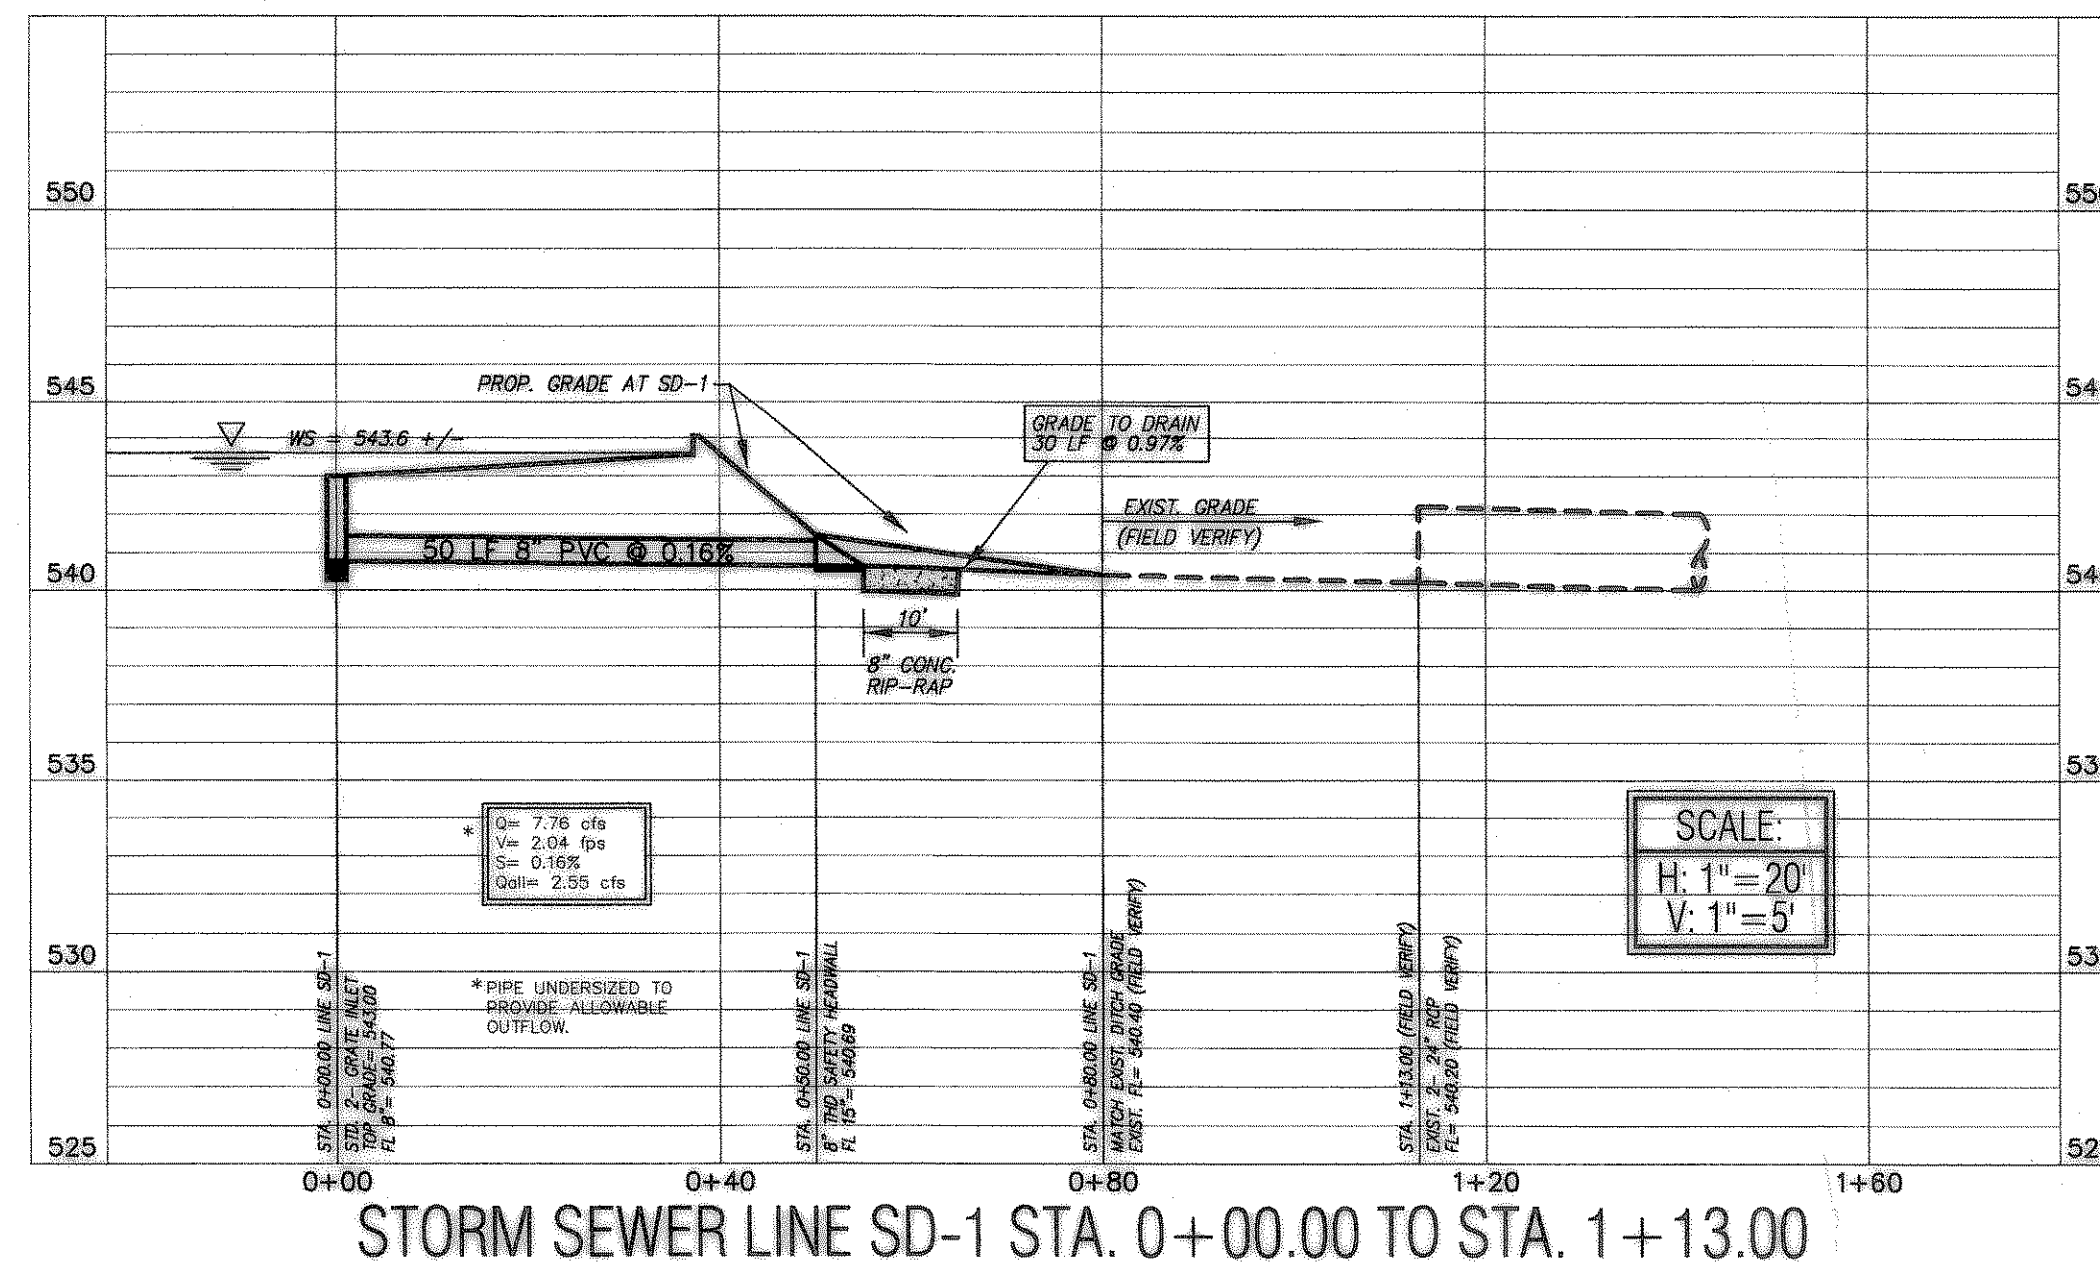


Signing Date: 5/24/2011

dietz engineering
 811 e. plano parkway
 suite 109
 plano, texas 75074
 voice: 972 633-8867
 fax: 972 633-1327

Drawn By: LL
 Checked By: JMC
 Revisions:

SITE RETAIL
 STORM SEWER PLAN
 PLAN VIEW
 for the
 City of Rockwall, Texas

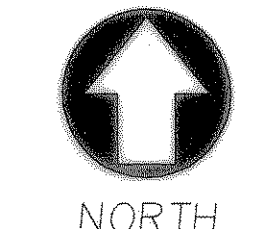

24"x36" Scale: 1" = 30'
 11"x17" Scale: 1" = 60'
 Vertical Scale: NA
 Project Num: E-SPC-001
 Issue Date: 24 MAY 2011
 Sheet Title:
STORM SEWER
 Sheet No.:

AS-BUILT

BENCHMARK:
 SQUARE CUT ON NORTH CORNER OF INLET ON EAST SIDE OF TACO BUENO.
 ELEVATION = 541.75

C1.07