

# CONSTRUCTION PLANS

## FOR

# WATER'S EDGE RESIDENCES AT LAKE RAY HUBBARD


AN ADDITION TO  
THE CITY OF ROCKWALL, TEXAS

### Index Of Drawings

C1	Cover Sheet
C2, C3, C3a	Final Plat
C4	Existing Conditions/Demolition Plan
C5-C7	Grading Plan
C8	Drainage Area Map
C9	Storm Sewer Plan
C10	Storm Sewer Profiles
C11	Erosion Control Plan
C12	Water Plan
C13	Sanitary Sewer Plan
C14	Paving Plan
C15	SWPPP Details
C16	Storm Sewer Details
C17	Paving Details
<del>LS1</del>	<del>Landscape Plan</del>

Prepared For:  
JTL Capital, L.L.C.  
Colonial Bank Plaza  
8214 Westchester Drive, Suite 635  
Dallas, Texas 75225  
Contact: Jim Pabich  
Tel: (214) 692-5085  
Fax: (214) 692-0274

Engineer:  
Brockette · Davis · Drake  
4144 North Central Expressway, Suite 1100  
Dallas, Texas 75204  
Contact: Robert R. Jebavy  
Tel: (214) 824-3647  
Fax: (214) 824-7064

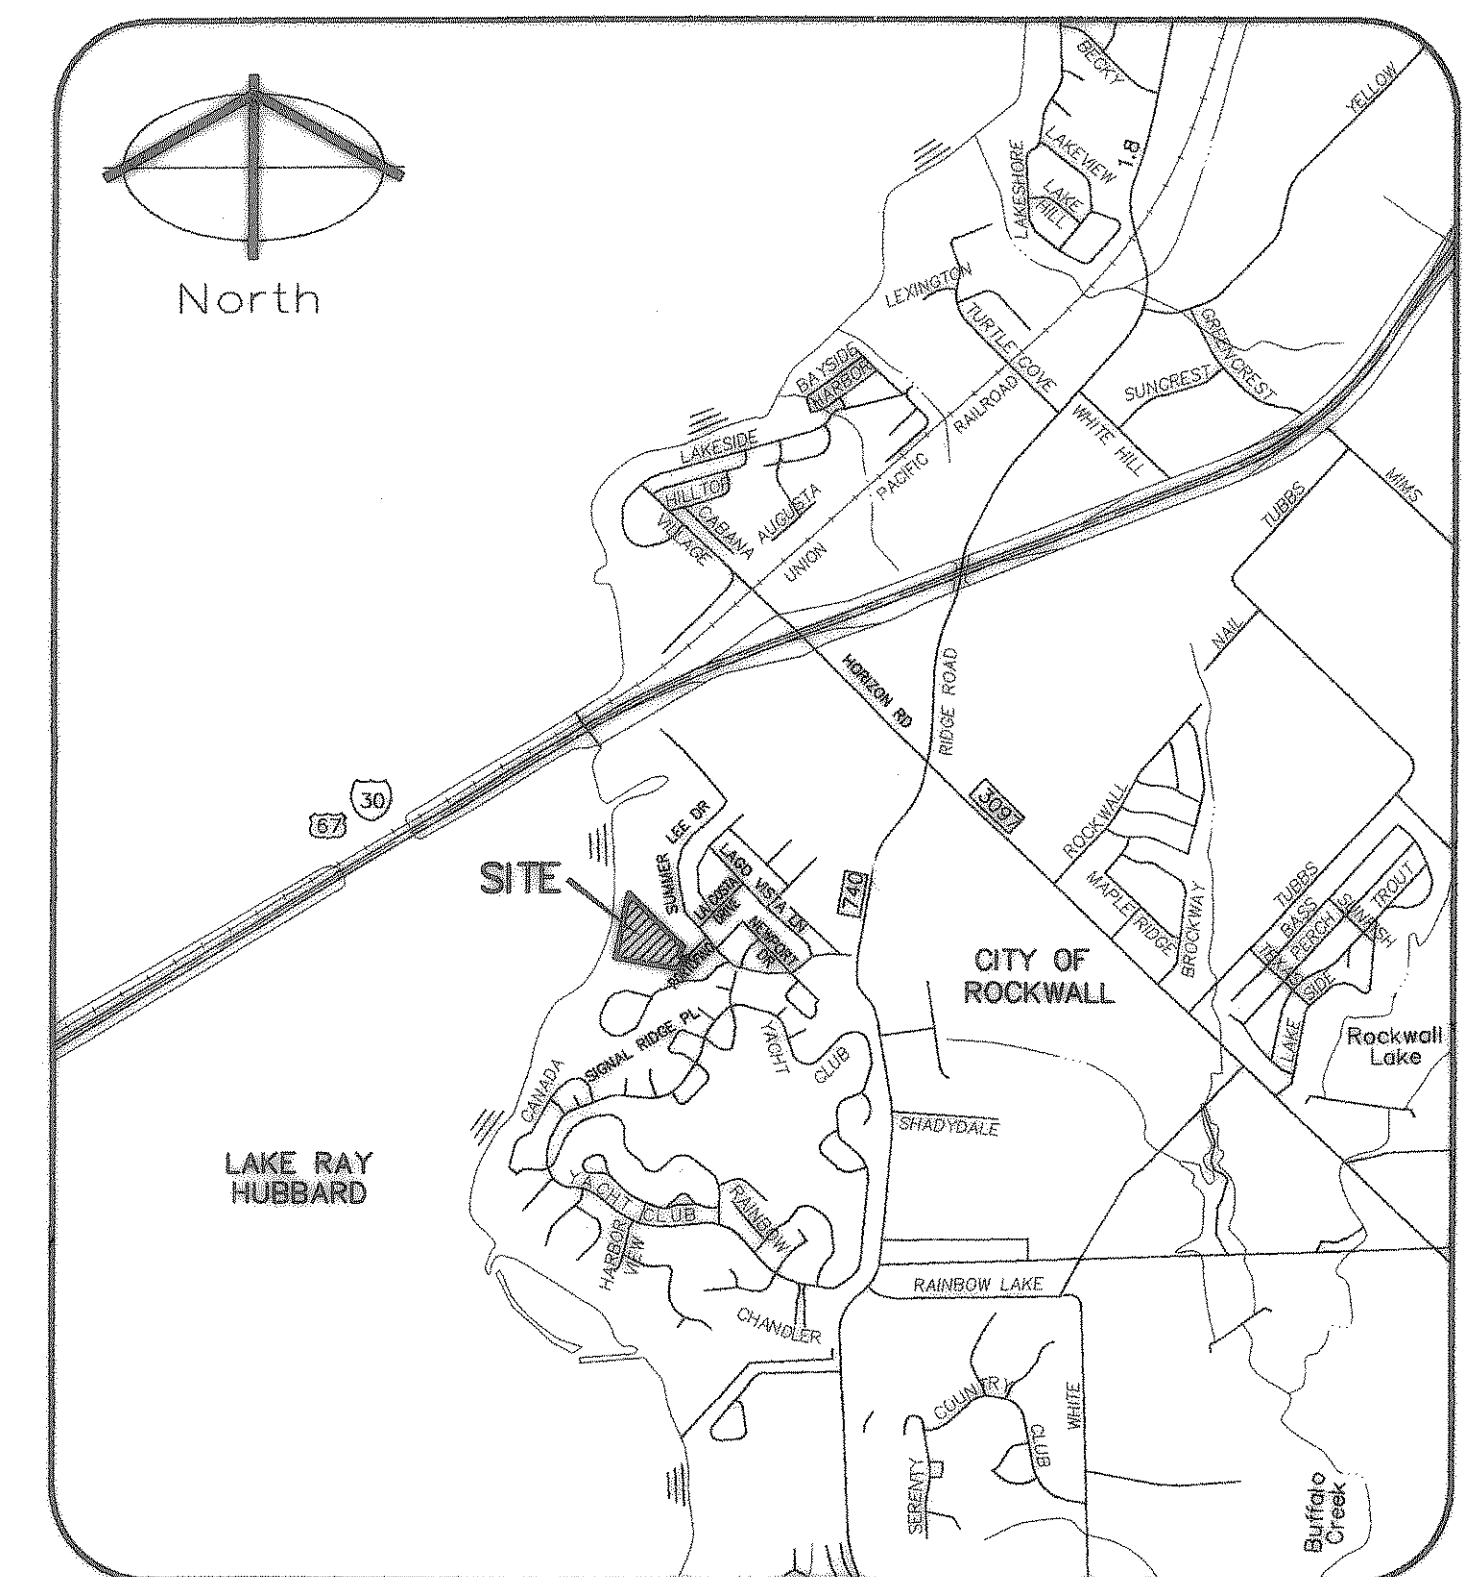

Location Map  
NTS

RECORD DRAWING

02/09/07

NOTE:  
THESE PLANS HAVE BEEN REVISED TO CONFORM  
WITH CONSTRUCTION RECORDS PROVIDED BY THE  
CONTRACTOR.