

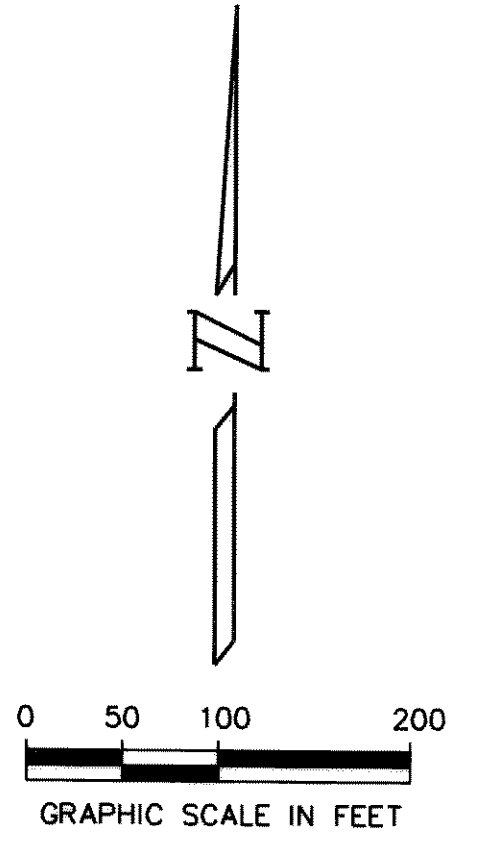


TECH: P:\8770MA\277UT001.PRF
 F:\1 Oct 7 09:04:46 1994 PEN TABLE: GARY1
 D:\JOHN SLD\93327701\GRA\277UT001
 PRF SCALE: 10000.000000

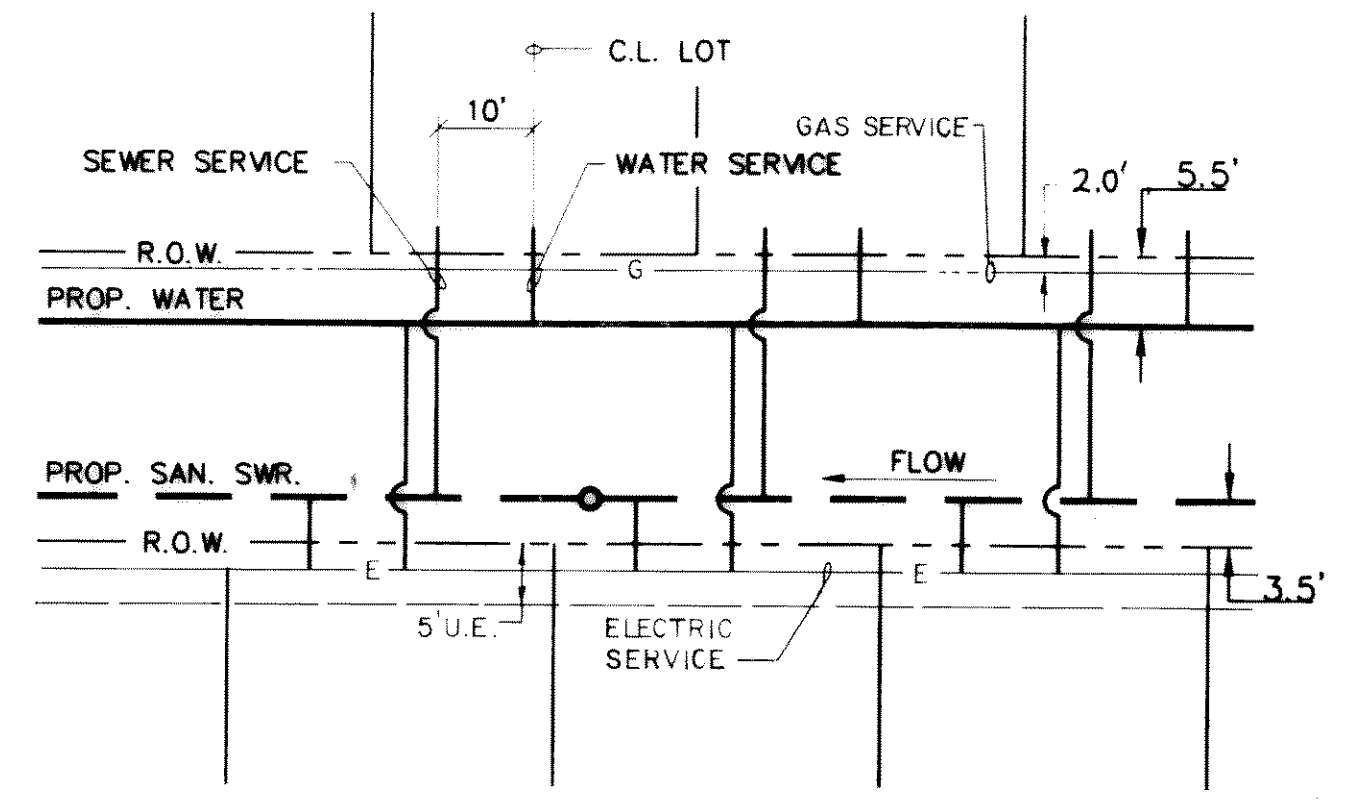

LEGEND

- PROPOSED SANITARY SEWER
- PROPOSED WATER LINE
- PROPOSED FIRE HYDRANT
- PROPOSED MANHOLE
- PROPOSED CLEANOUT
- EXIST. SANITARY SEWER
- EXIST. WATER LINE
- EXIST. MANHOLE
- EXIST. FIRE HYDRANT
- PROPOSED GAS
- PROPOSED ELECTRIC SERVICE
- ELECTRIC TRANSFORMER
- ELECTRIC HANDHOLD
- STREET LIGHT

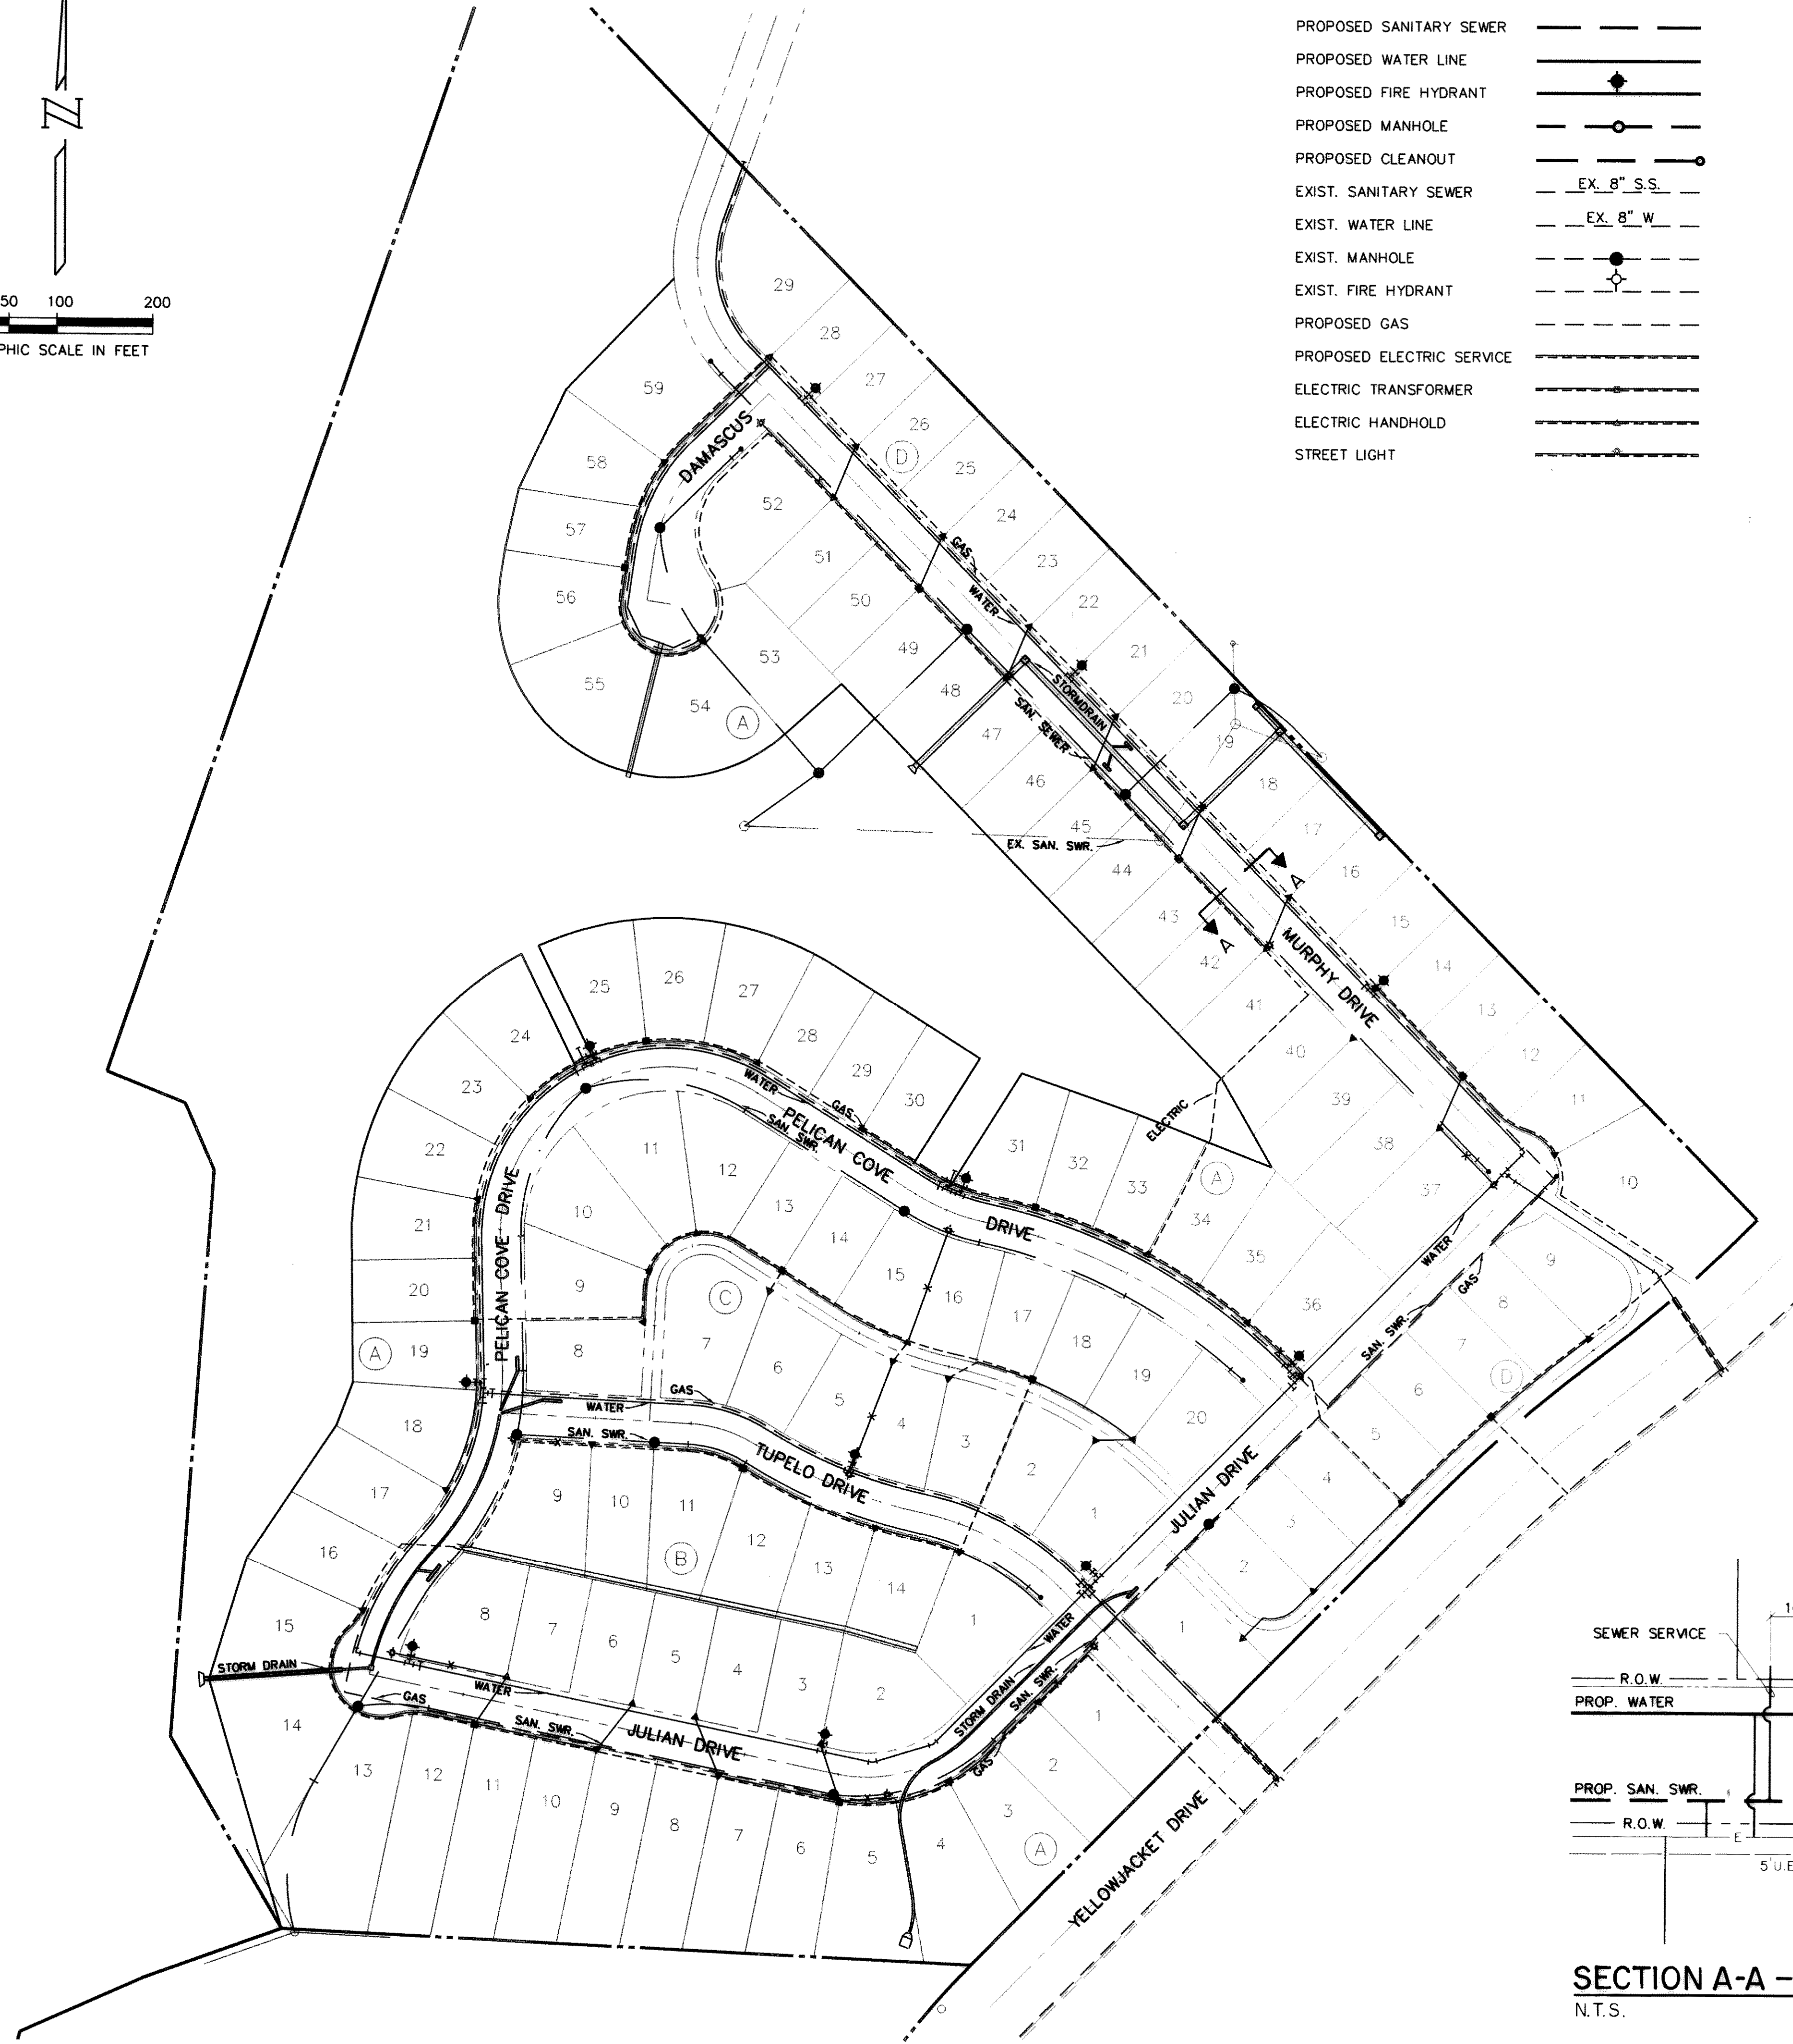

SECTION A-A - UTILITY DETAIL
N.T.S.

RECORD DRAWING'S

These drawings have been modified to reflect construction records provided to the Engineer.

DATE	REVISION	MADE	CKD.	APPD.
 Carter & Burgess Carter & Burgess, Inc. 7950 Elmbrook Drive Dallas, Texas 75247-4961 (214) 638-0145 METRO (214) 263-2019 Fax (214) 638-0447				
UTILITY LAYOUT PLAN WATERSTONE ESTATES				
CITY OF ROCKWALL, ROCKWALL COUNTY, TEXAS				
DESIGN	DRAWN	CKD	SCALE	DATE
JONES	JONES	PAYNE	1"=100'	SEPT., 94
FILE	NO.			
01-2024	14 OF 21			

