



- BENCHMARKS:**
- CARTER & BURGESS CAP ON NORTH SIDE OF YELLOW JACKET LANE 75' WEST OF FAR WEST ENTRANCE TO CANYON RIDGE APARTMENTS. ELEV. = 574.71
  - CUT IN NOSE OF MEDIAN ON YELLOW JACKET LANE 25' EAST OF SOUTHEAST PROPERTY CORNER OF PROJECT. ELEV. = 573.48
  - TOP OF CONCRETE R.O.W. MARKER AT FENCE CORNER IN THE SOUTHEAST QUADRANT AT THE INTERSECTION OF FM 276 AND HIGH SCHOOL DRIVE. ELEV. = 542.98

**PHASE I (EXISTING)**  
**NOT IN THIS CONTRACT**

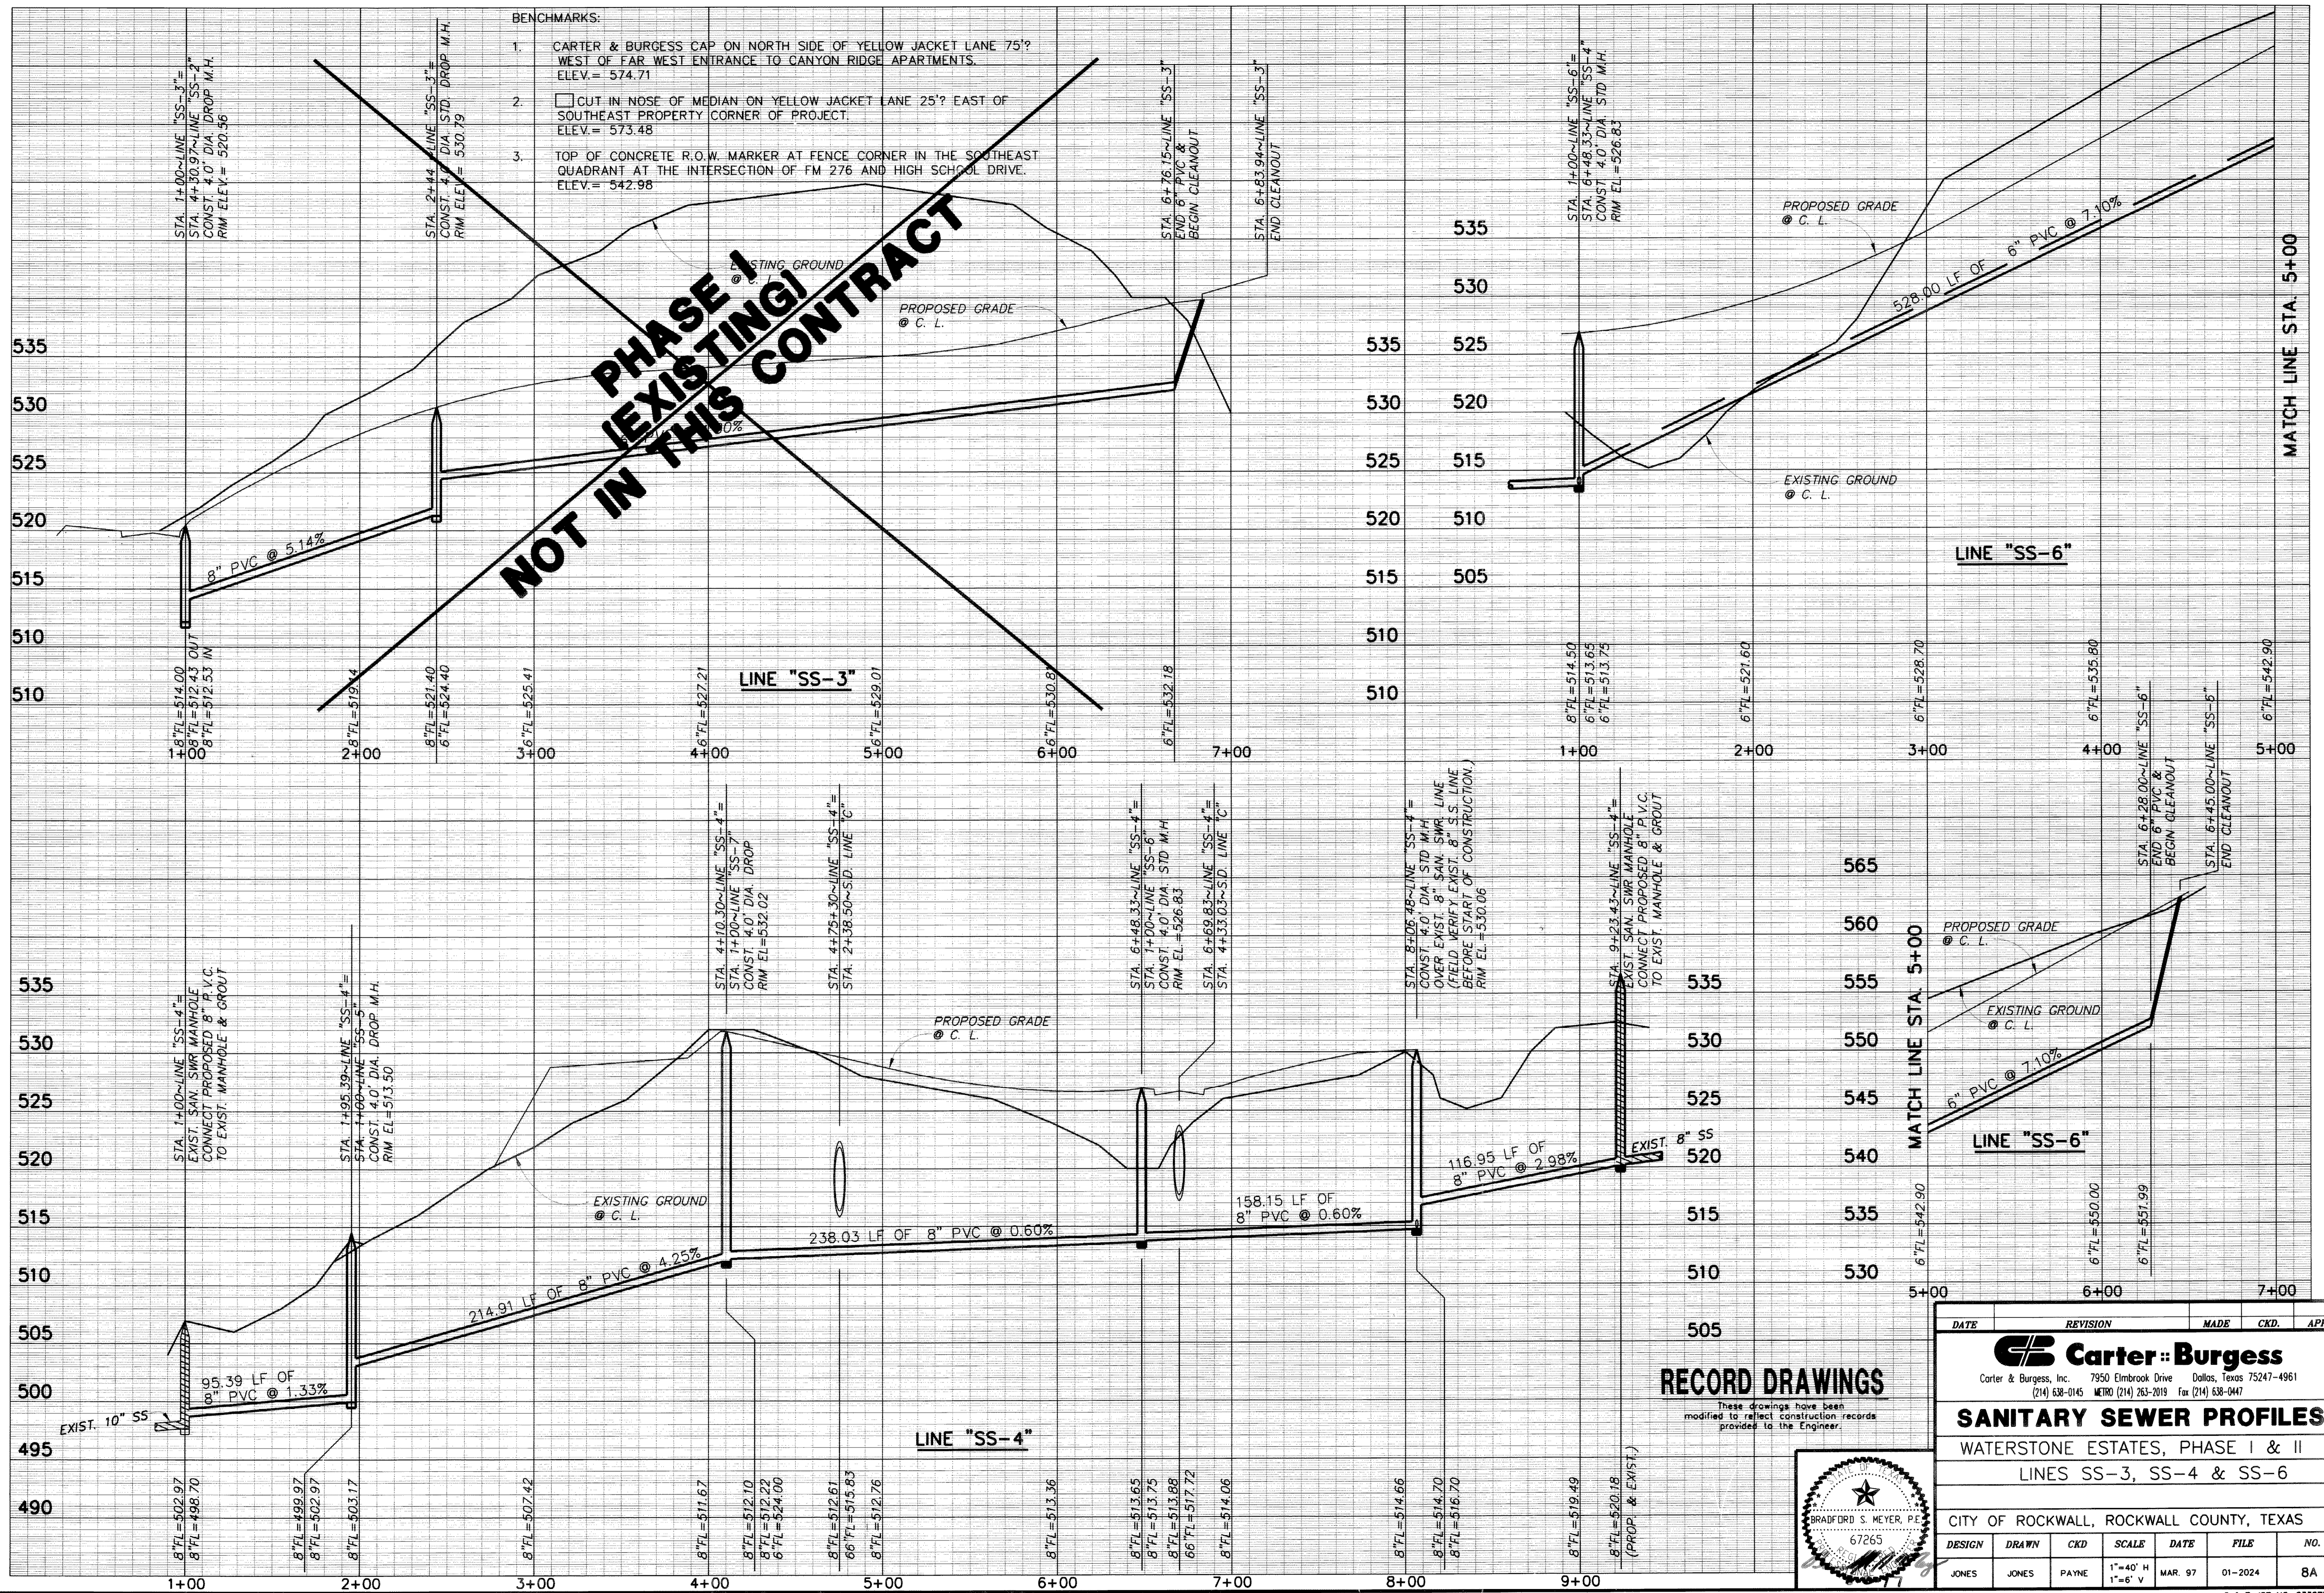

**RECORD DRAWINGS**

These drawings have been modified to reflect construction records provided to the Engineer.

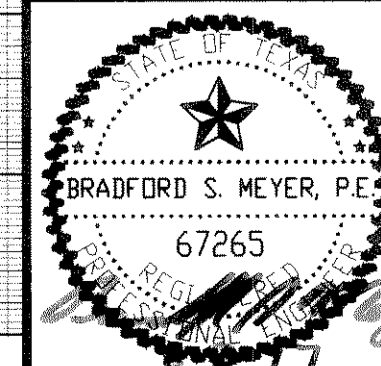

DATE	REVISION	MADE	CKD.	APPD.		
<b>Carter &amp; Burgess</b> Carter & Burgess, Inc. 7950 Elmbrook Drive Dallas, Texas 75247-4961 (214) 638-0145 METRO (214) 263-2019 Fax (214) 638-0447						
<b>SANITARY SEWER PROFILES</b> WATERSTONE ESTATES, PHASE I & II LINES SS-3, SS-4 & SS-6						
CITY OF ROCKWALL, ROCKWALL COUNTY, TEXAS						
DESIGN	DRAWN	CKD	SCALE	DATE	FILE	NO.
JONES	JONES	PAYNE	1"=40' H 1"=6' V	MAR. 97	01-2024	8A